


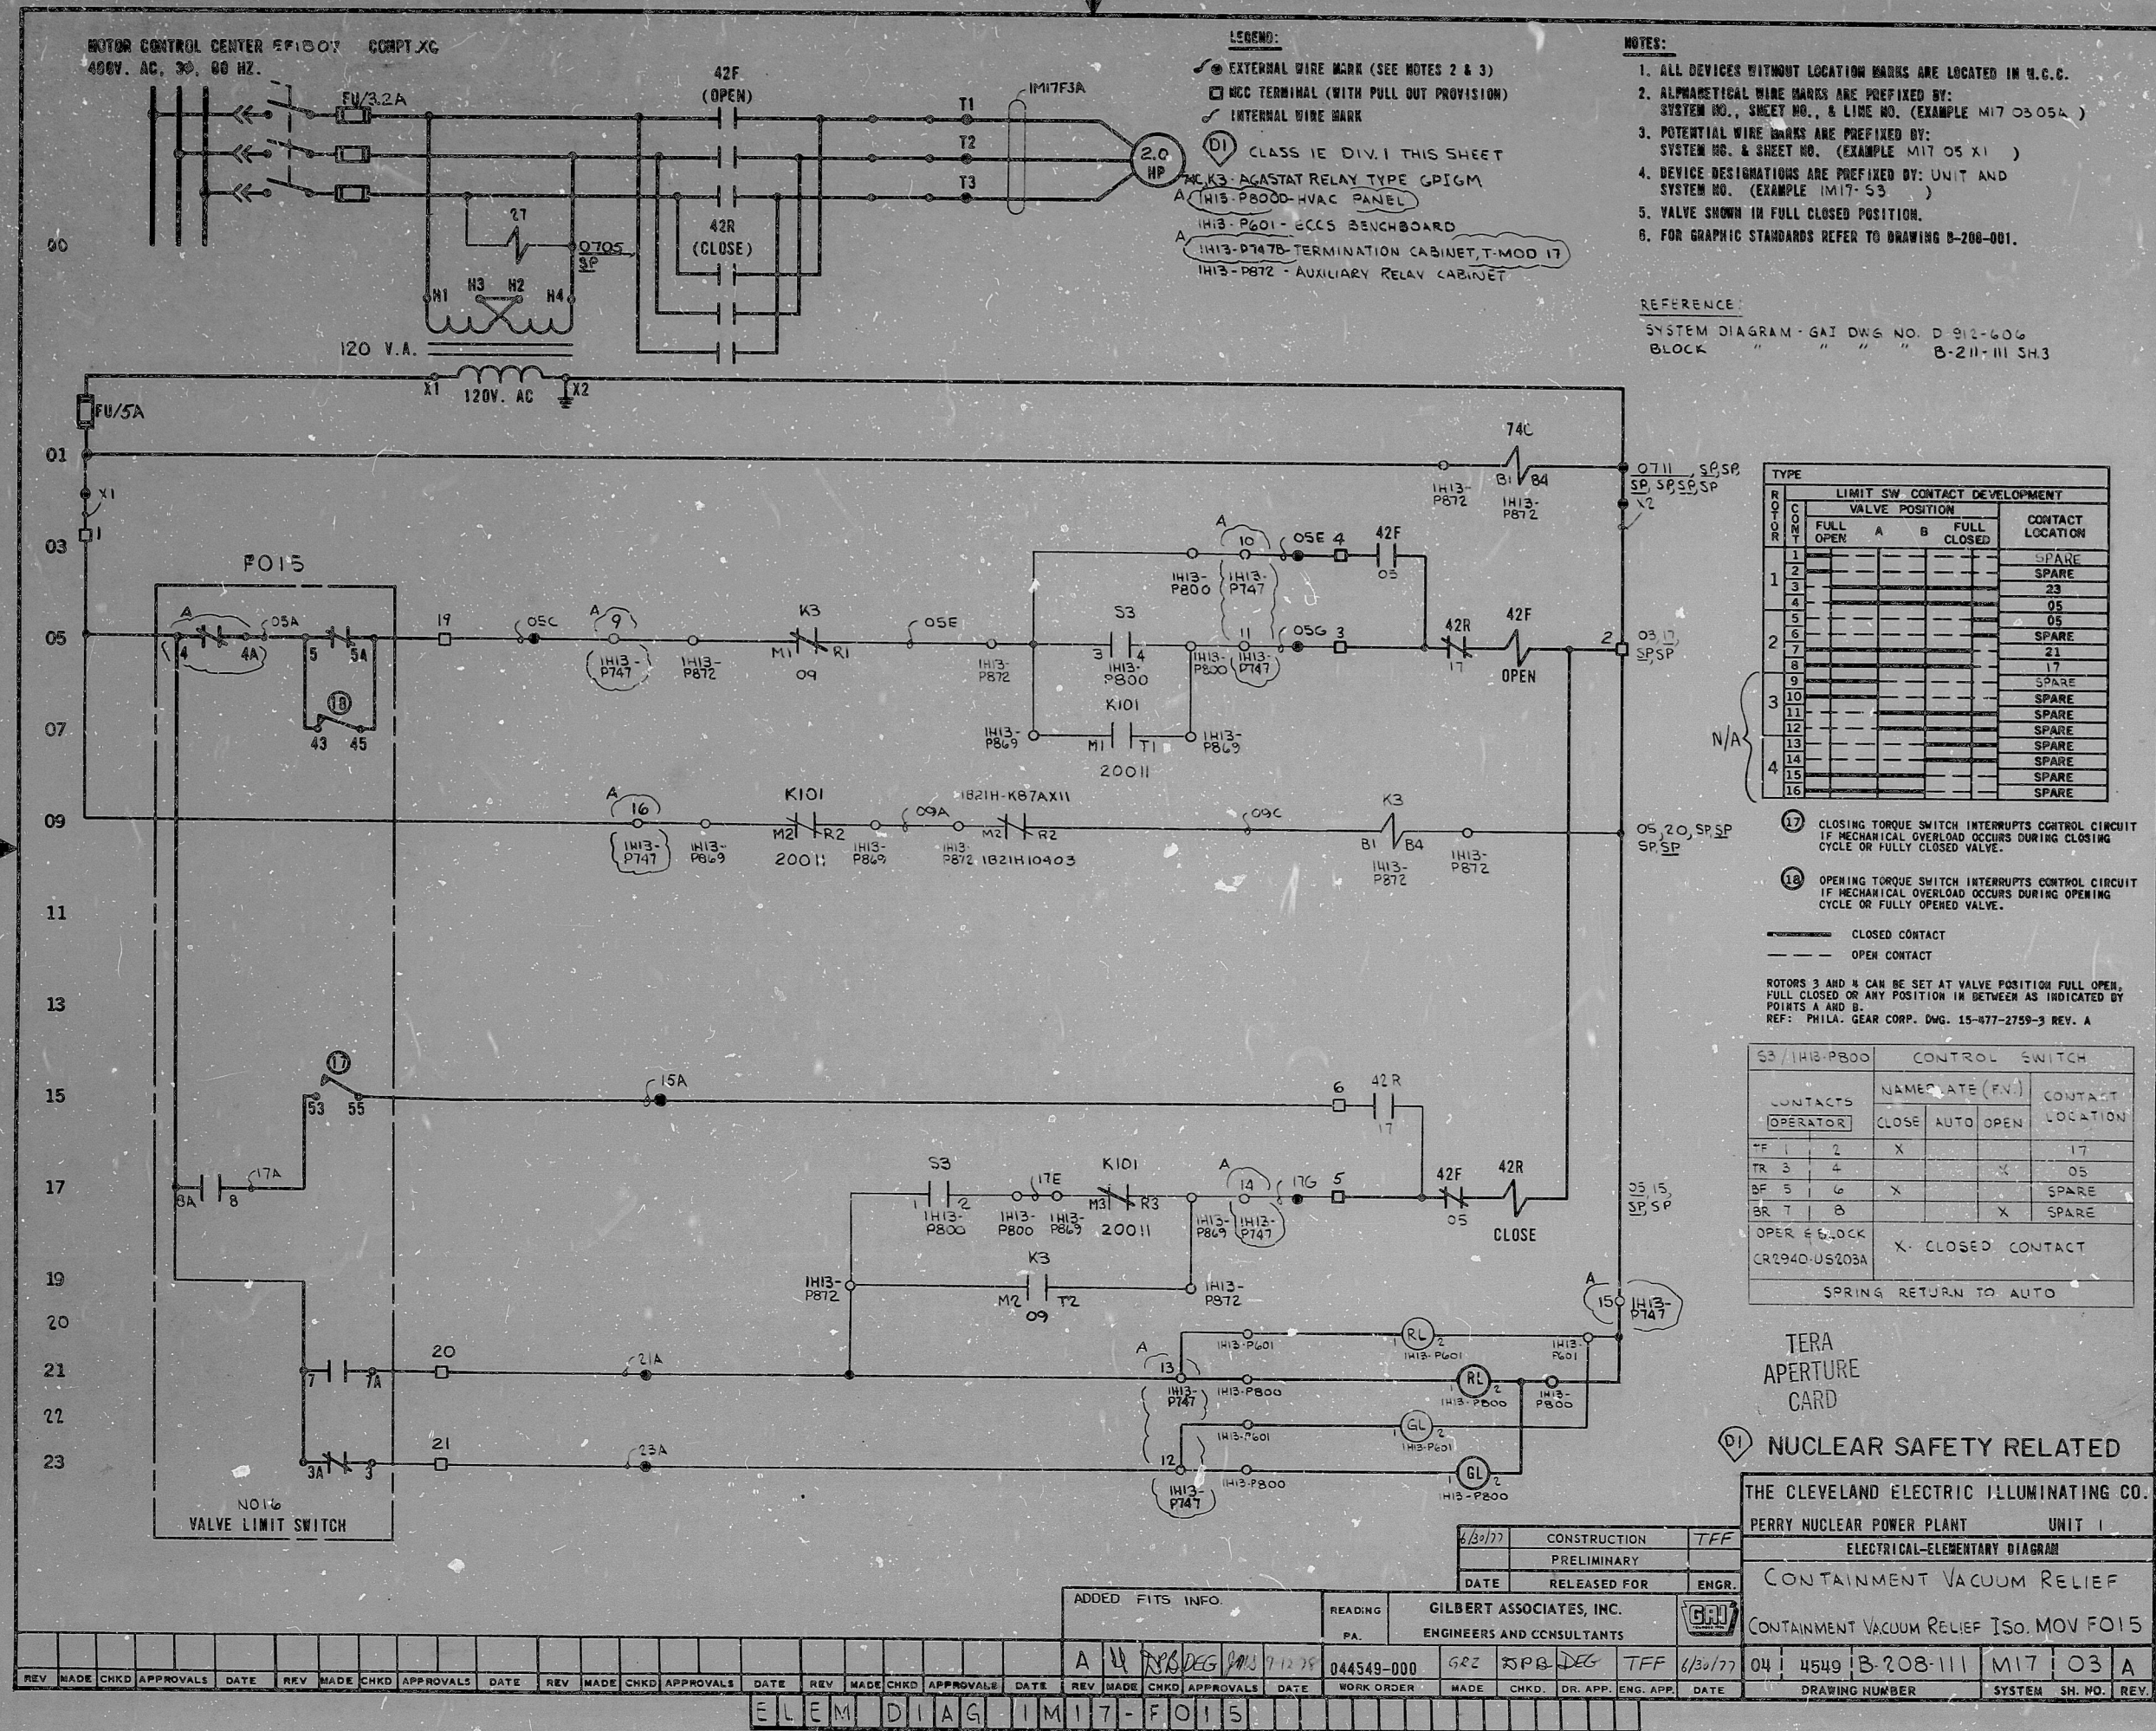



RIDS-PDR

8b3230130

