


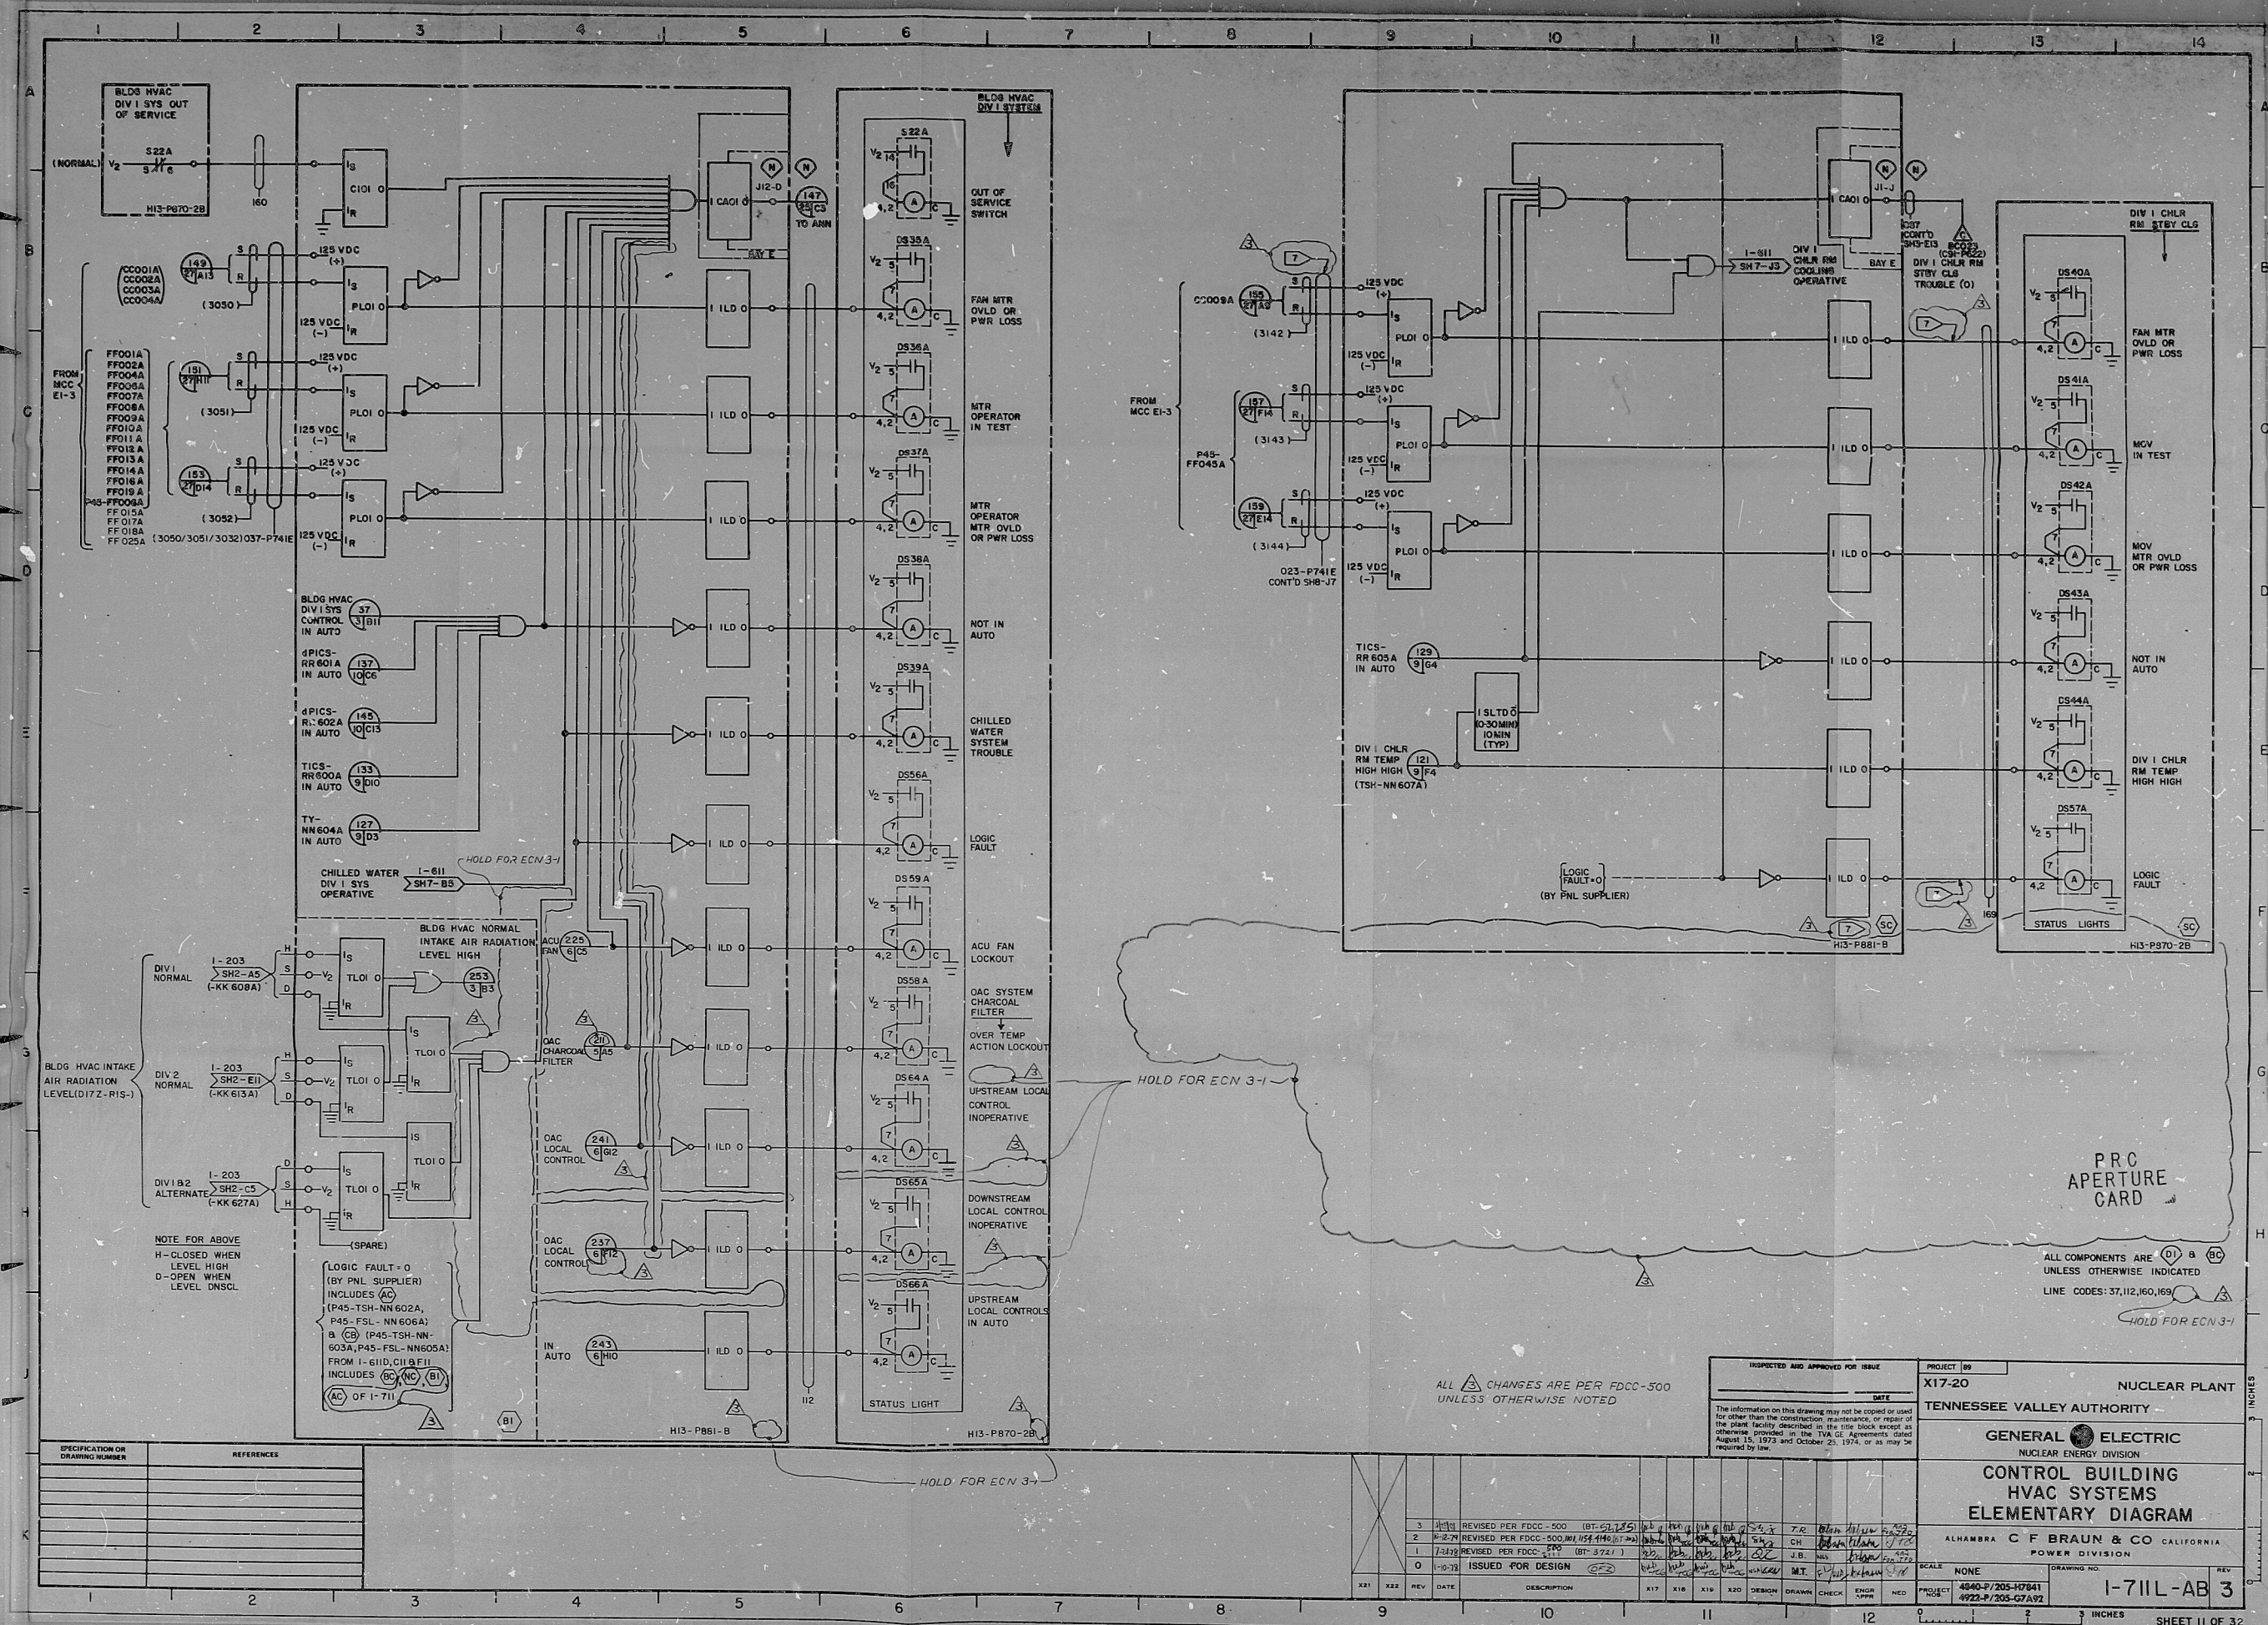

RIDS

8206150423

