


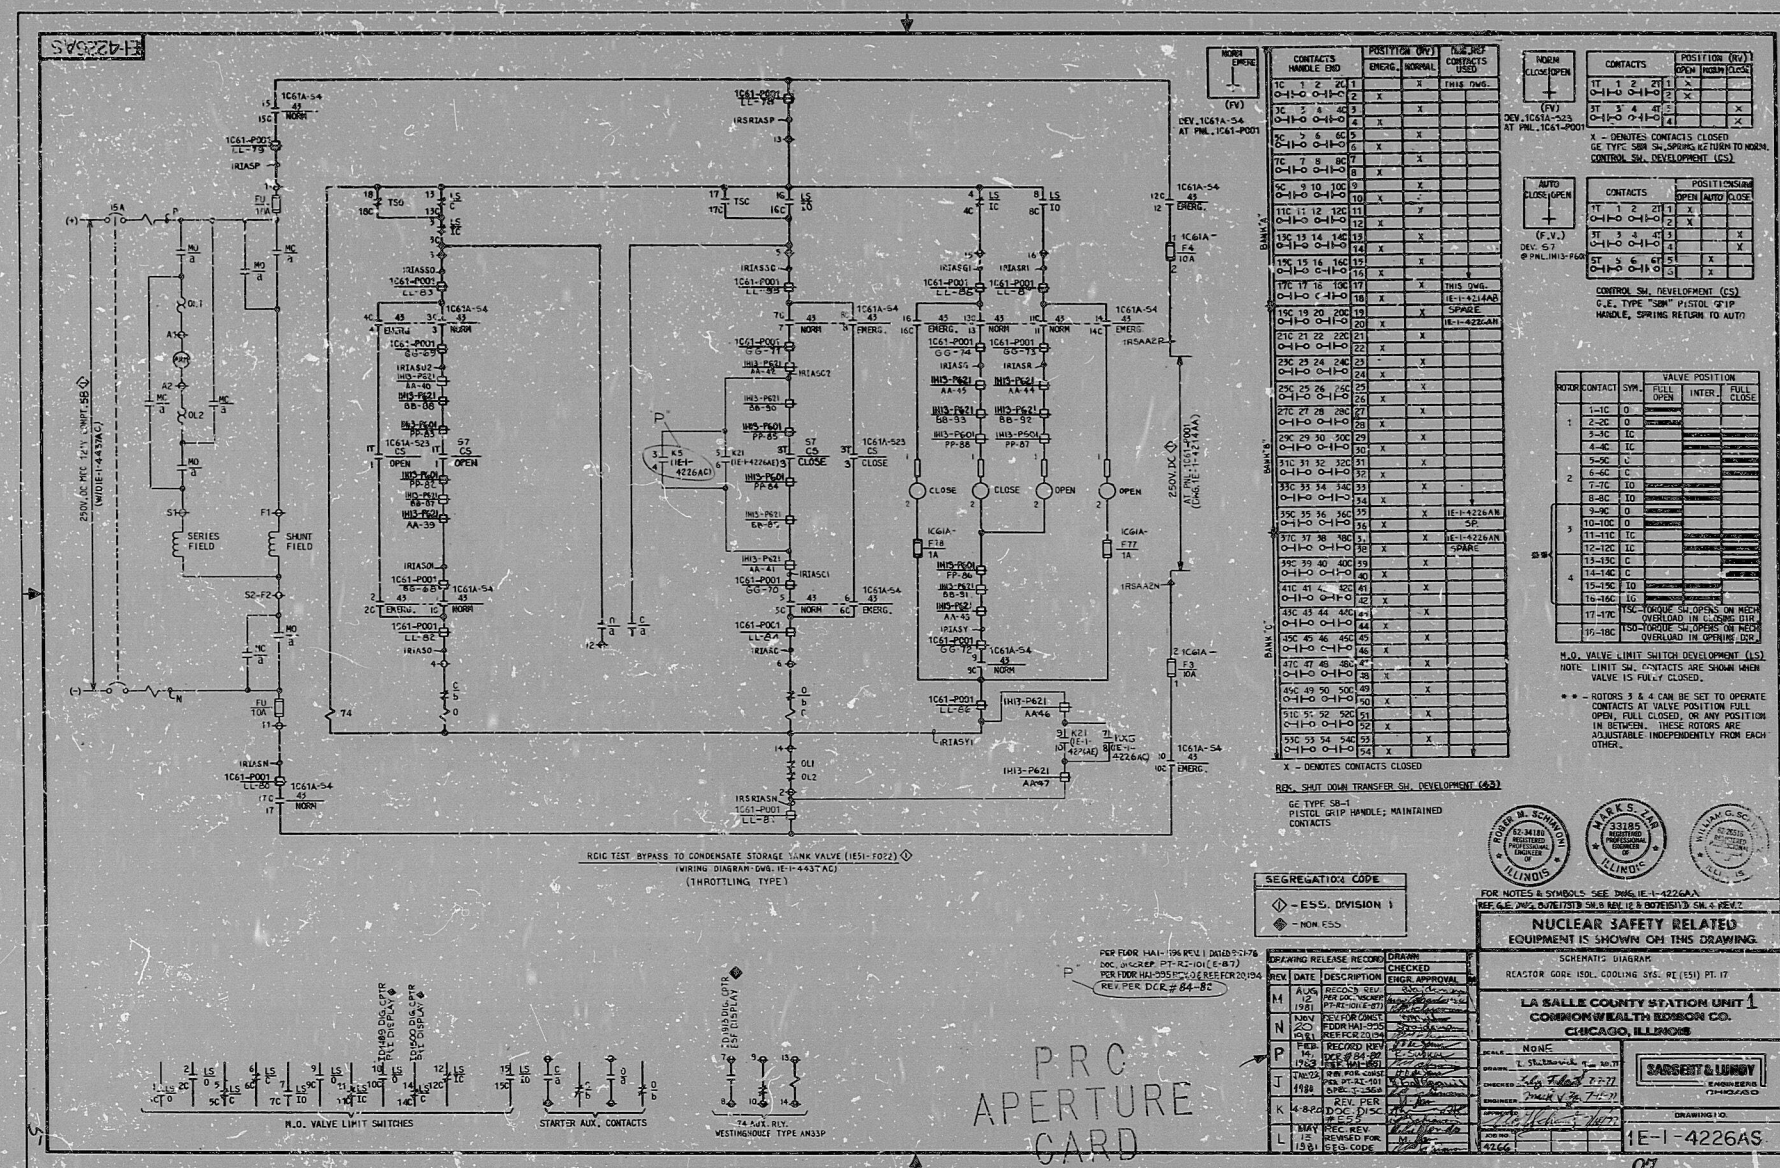

RIDS

8308260375

