


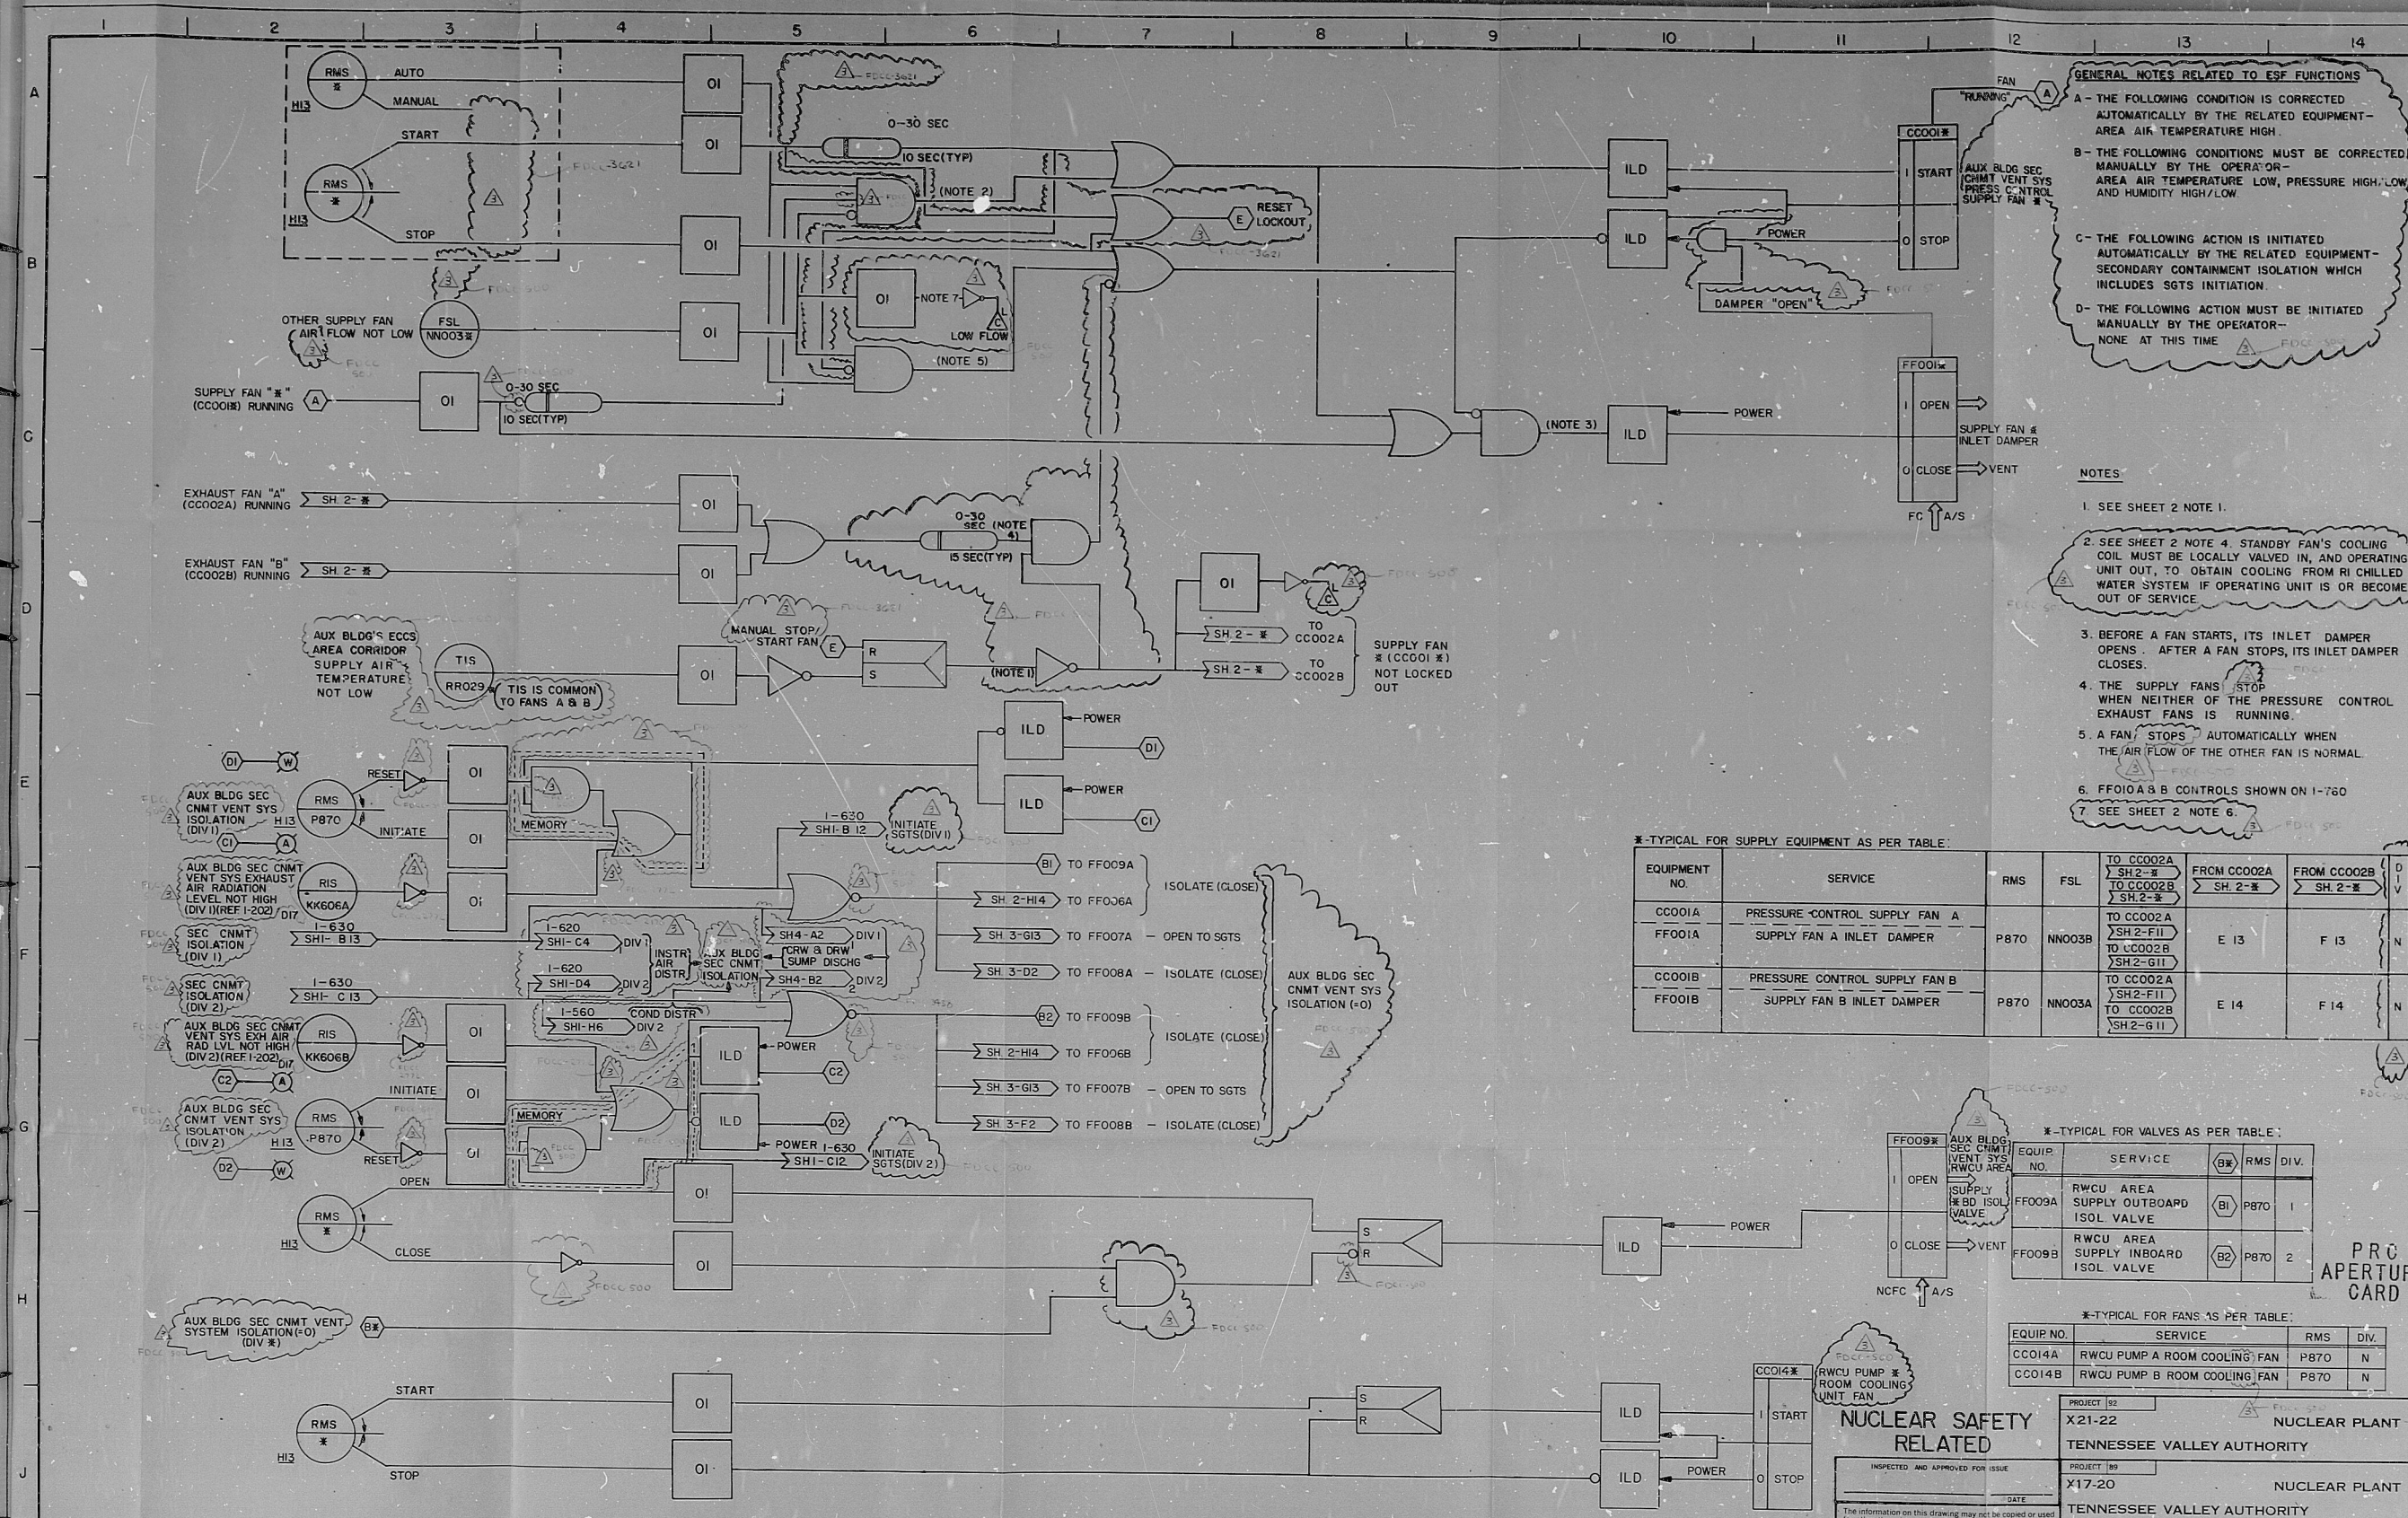

GENERAL NOTES RELATED TO ESF FUNCTIONS

A - THE FOLLOWING CONDITION IS CORRECTED AUTOMATICALLY BY THE RELATED EQUIPMENT - AREA AIR TEMPERATURE HIGH.

B - THE FOLLOWING CONDITIONS MUST BE CORRECTED MANUALLY BY THE OPERATOR - AREA AIR TEMPERATURE LOW, PRESSURE HIGH/LOW AND HUMIDITY HIGH/LOW.

C - THE FOLLOWING ACTION IS INITIATED AUTOMATICALLY BY THE RELATED EQUIPMENT - SECONDARY CONTAINMENT ISOLATION WHICH INCLUDES SGTS INITIATION.

D - THE FOLLOWING ACTION MUST BE INITIATED MANUALLY BY THE OPERATOR - NONE AT THIS TIME.

- NOTES**
1. SEE SHEET 2 NOTE 1.
 2. SEE SHEET 2 NOTE 4. STANDBY FAN'S COOLING COIL MUST BE LOCALLY VALVED IN, AND OPERATING UNIT OUT, TO OBTAIN COOLING FROM RI CHILLED WATER SYSTEM IF OPERATING UNIT IS OR BECOMES OUT OF SERVICE.
 3. BEFORE A FAN STARTS, ITS INLET DAMPER OPENS. AFTER A FAN STOPS, ITS INLET DAMPER CLOSES.
 4. THE SUPPLY FANS STOP WHEN NEITHER OF THE PRESSURE CONTROL EXHAUST FANS IS RUNNING.
 5. A FAN STOPS AUTOMATICALLY WHEN THE AIR FLOW OF THE OTHER FAN IS NORMAL.
 6. FFO01A & B CONTROLS SHOWN ON I-760.
 7. SEE SHEET 2 NOTE 6.

*** TYPICAL FOR SUPPLY EQUIPMENT AS PER TABLE:**

EQUIPMENT NO.	SERVICE	RMS	FSL	TO CCO02A SH-2-#	FROM CCO02A SH-2-#	FROM CCO02B SH-2-#	DIV
CC001A	PRESSURE CONTROL SUPPLY FAN A	P870	NN003B	TO CCO02A SH-2-F11	E 13	F 13	N
FF001A	SUPPLY FAN A INLET DAMPER	P870	NN003B	TO CCO02B SH-2-G11			
CC001B	PRESSURE CONTROL SUPPLY FAN B	P870	NN003A	TO CCO02A SH-2-F11	E 14	F 14	N
FF001B	SUPPLY FAN B INLET DAMPER	P870	NN003A	TO CCO02B SH-2-G11			

*** TYPICAL FOR VALVES AS PER TABLE:**

EQUIP. NO.	SERVICE	RMS	DIV.
FF009A	RWCU AREA SUPPLY OUTBOARD ISOL VALVE	B1	P870 1
FF009B	RWCU AREA SUPPLY INBOARD ISOL VALVE	B2	P870 2

*** TYPICAL FOR FANS AS PER TABLE:**

EQUIP. NO.	SERVICE	RMS	DIV.
CC014A	RWCU PUMP A ROOM COOLING FAN	P870	N
CC014B	RWCU PUMP B ROOM COOLING FAN	P870	N

NUCLEAR SAFETY RELATED

INSPECTED AND APPROVED FOR ISSUE: _____ DATE: _____

PROJECT NO: X21-22 NUCLEAR PLANT TENNESSEE VALLEY AUTHORITY

PROJECT NO: X17-20 NUCLEAR PLANT TENNESSEE VALLEY AUTHORITY

GENERAL ELECTRIC NUCLEAR ENERGY DIVISION

AUXILIARY BUILDING ECCS AREA PRESSURE CONTROL SYSTEM LOGIC DIAGRAM

ALHAMBRA C F BRAUN & CO CALIFORNIA POWER DIVISION

SCALE: NONE DRAWING NO: I-720A SHEET 1 OF 4

REFERENCES

REFERENCE	DESCRIPTION
I-560	DEMIN WATER & COND DISTR. LOGIC
I-620	INSTR. & SERVICE AIR DISTR. SYSTEMS LOGIC
I-001	REACTOR ISLAND LOGIC DIAGRAM SYMBOLS
K-163	AUXILIARY BUILDING ECCS AREA PRESSURE CONTROL SYSTEM FLOW DIAGRAM
I-202	PROCESS RADIATION MONITORING SYSTEM (R1) INSTRUMENT ENGINEERING DIAGRAM

REVISIONS

NO.	DATE	DESCRIPTION
1	12/1/72	REVISED PER FCC-500, 1649, 2772, 2176, 3621, 3434 (BT-1-1)
2	1/1/73	REVISED PER BT-759, ISSUED FOR DESIGN
3	2/20/74	ISSUED FOR REVIEW AND COMMENTS



92
RDS

8206150467

