


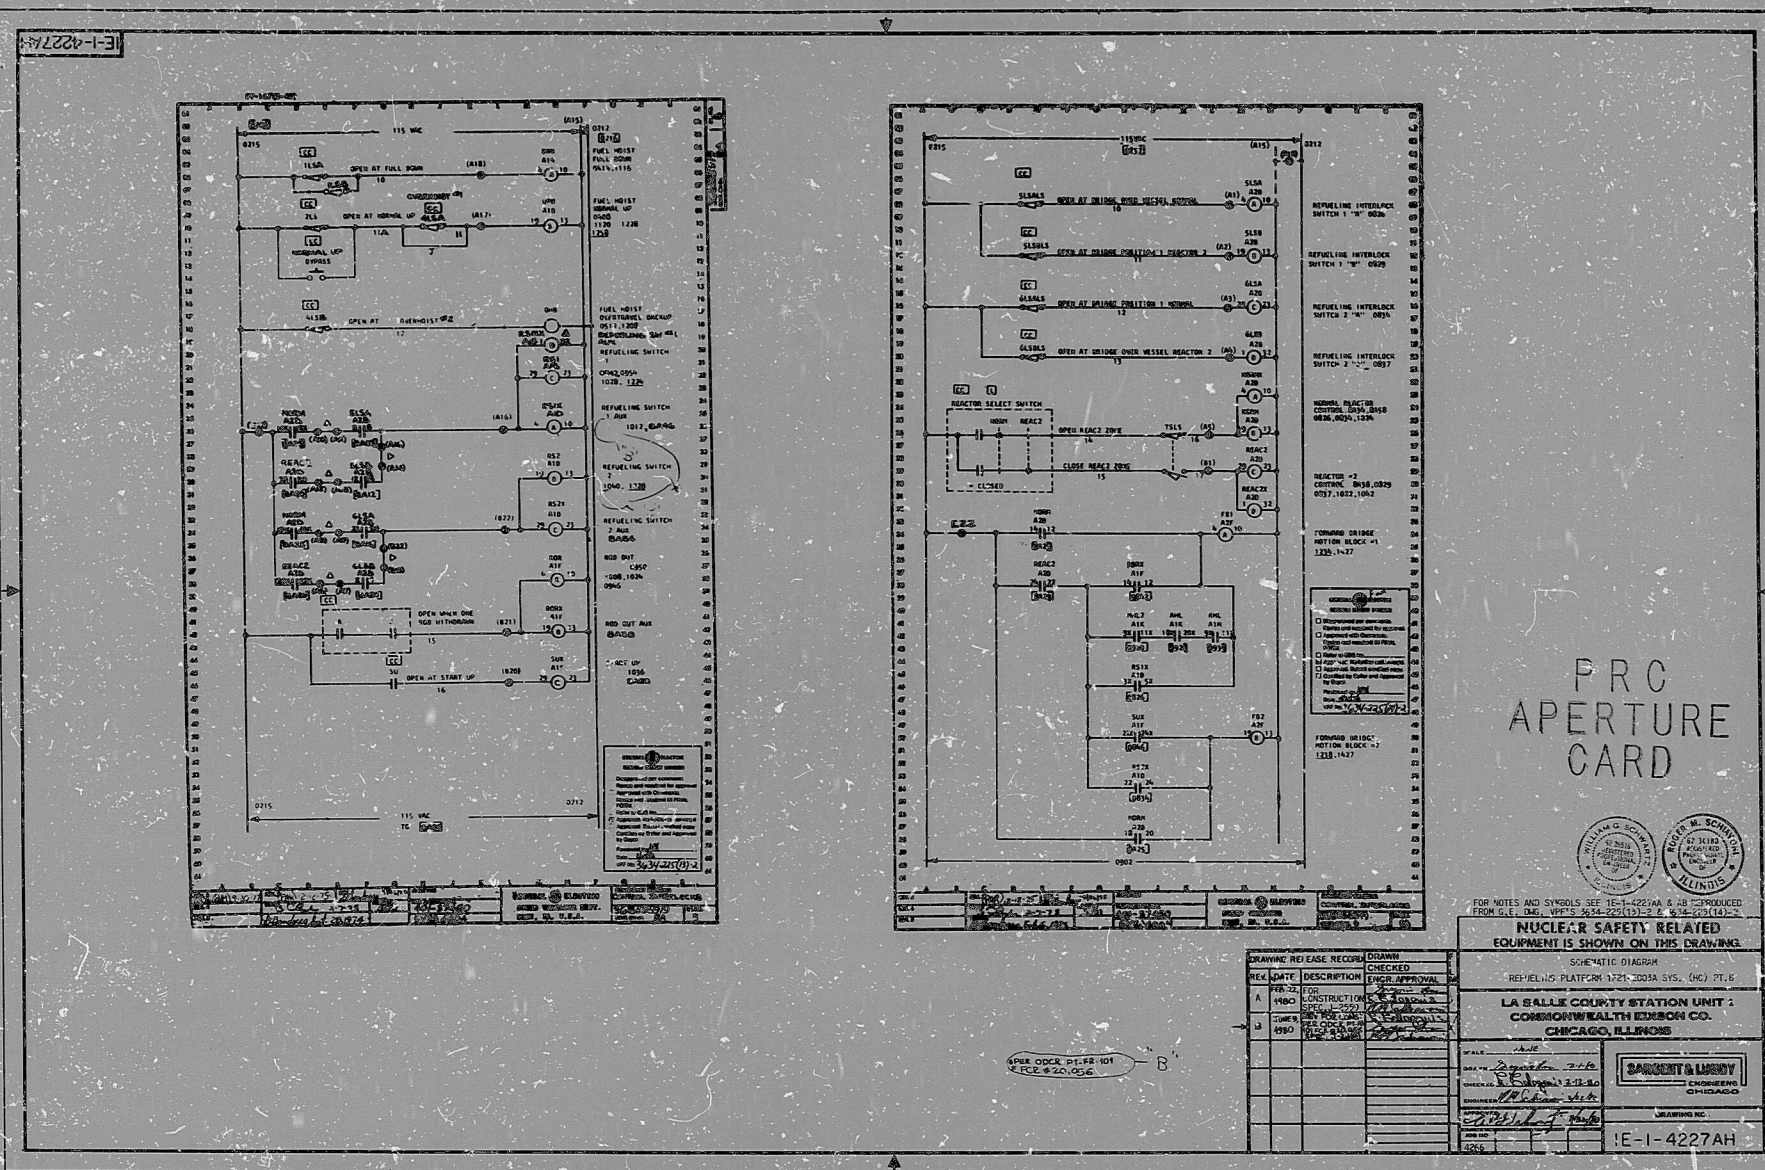

RIDS

8308260399

