


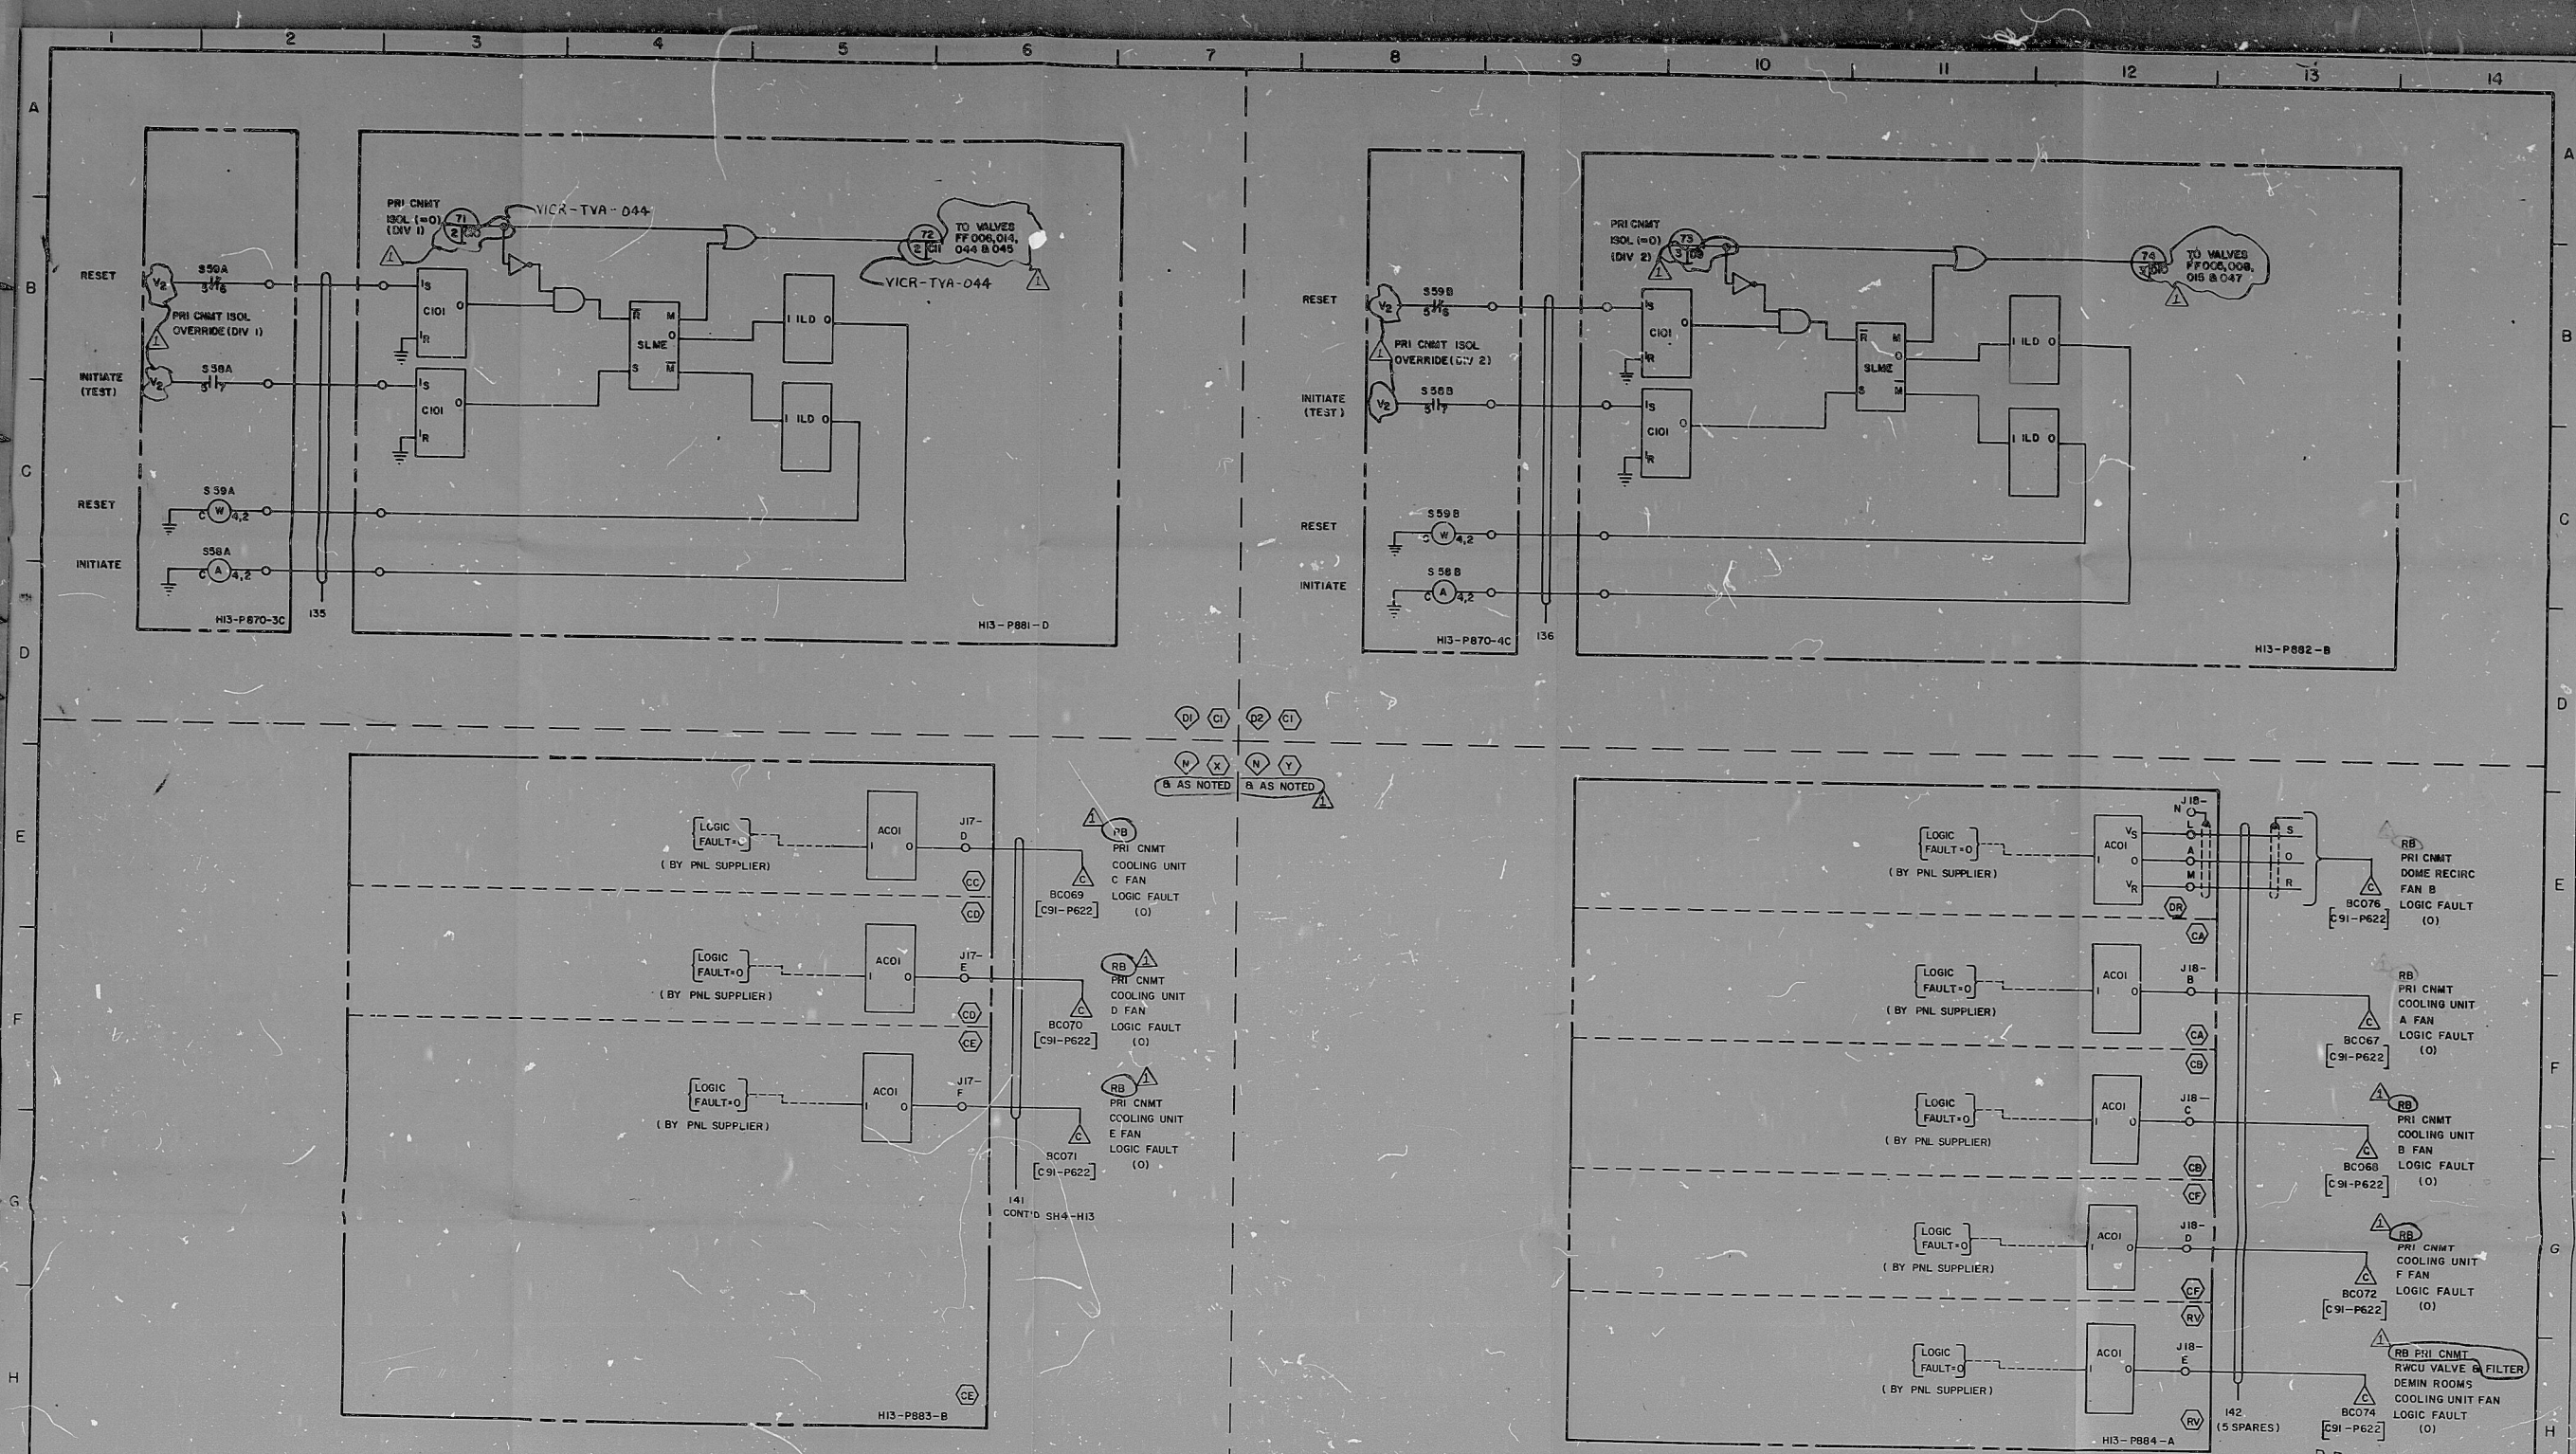

ALL CHANGES ARE PER FDCC-500
UNLESS OTHERWISE NOTED

SPECIFICATION OR DRAWING NUMBER	REFERENCES

REV	DATE	DESCRIPTION	BY	CHKD	APPD	ENGR	APPD	DATE
X1	10/1/73	REVISED PER FDCC-500 (BY S. J. H.)						
X2	10/1/73	ADDED PER FDCC-400 (BY S. J. H.)						

PROJECT 192
X21-22
TENNESSEE VALLEY AUTHORITY
NUCLEAR PLANT

PROJECT 193
X17-20
TENNESSEE VALLEY AUTHORITY
NUCLEAR PLANT

GENERAL ELECTRIC
NUCLEAR ENERGY DIVISION
CONTAINMENT COOLING, PRESSURE
CONTROL AND PURGE SYSTEMS
ELEMENTARY DIAGRAM

ALHAMBRA C F BRAUN & CO CALIFORNIA
POWER DIVISION

SCALE: NONE
DRAWING NO: 1-741M
PROJECT NO: 4840-P/205-107841
4922-P/205-G7A92

SHEET 12 OF 12

RIDS

8206160183

