


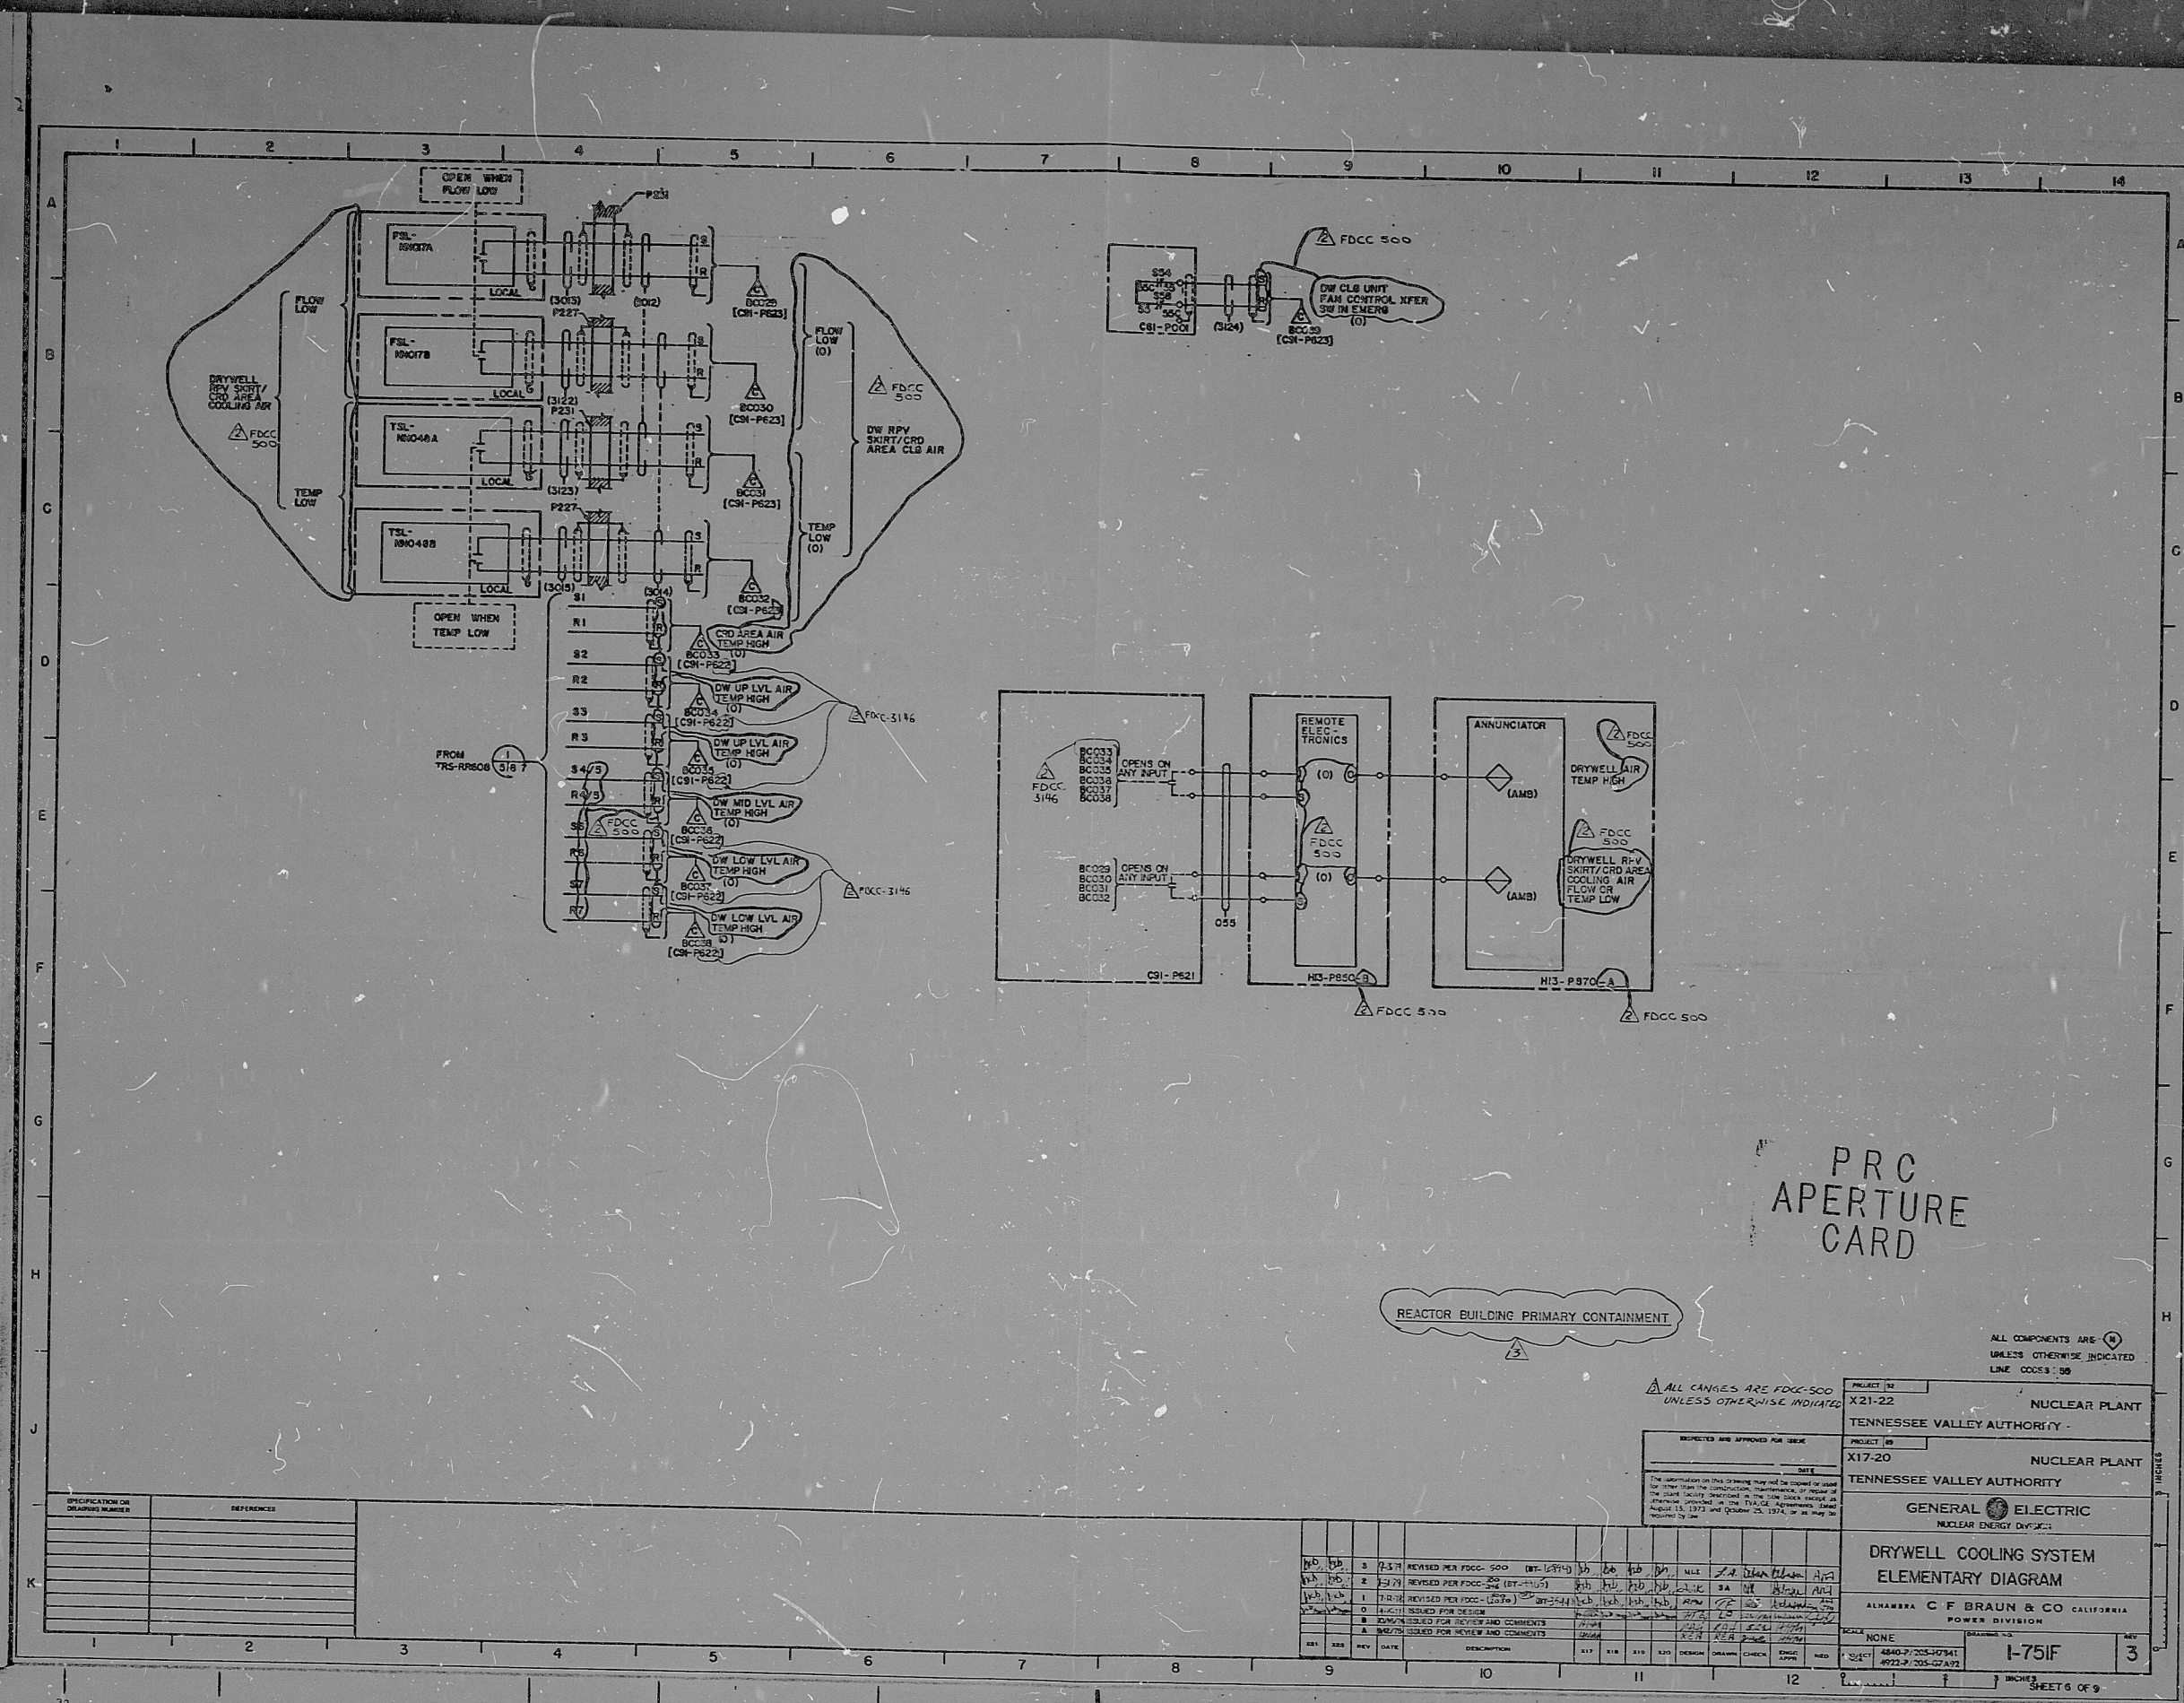

REVISION	DATE	DESCRIPTION
PRC
APERTURE
CARD

ALL CHANGES ARE FDCC-500
UNLESS OTHERWISE INDICATED

PROJECT 14	X21-22	NUCLEAR PLANT
PROJECT 15	X17-20	NUCLEAR PLANT
TENNESSEE VALLEY AUTHORITY		
GENERAL ELECTRIC		
NUCLEAR ENERGY DIVISION		
DRYWELL COOLING SYSTEM		
ELEMENTARY DIAGRAM		
ALABAMA C F BRAUN & CO CALIFORNIA		
POWER DIVISION		
SCALE	NONE	
PROJECT	4840-7-705-407941	
REVISION	4022-7-705-407942	
DATE	1-75IF	3
SHEET 6 OF 9		

RIDS

8206160195

