


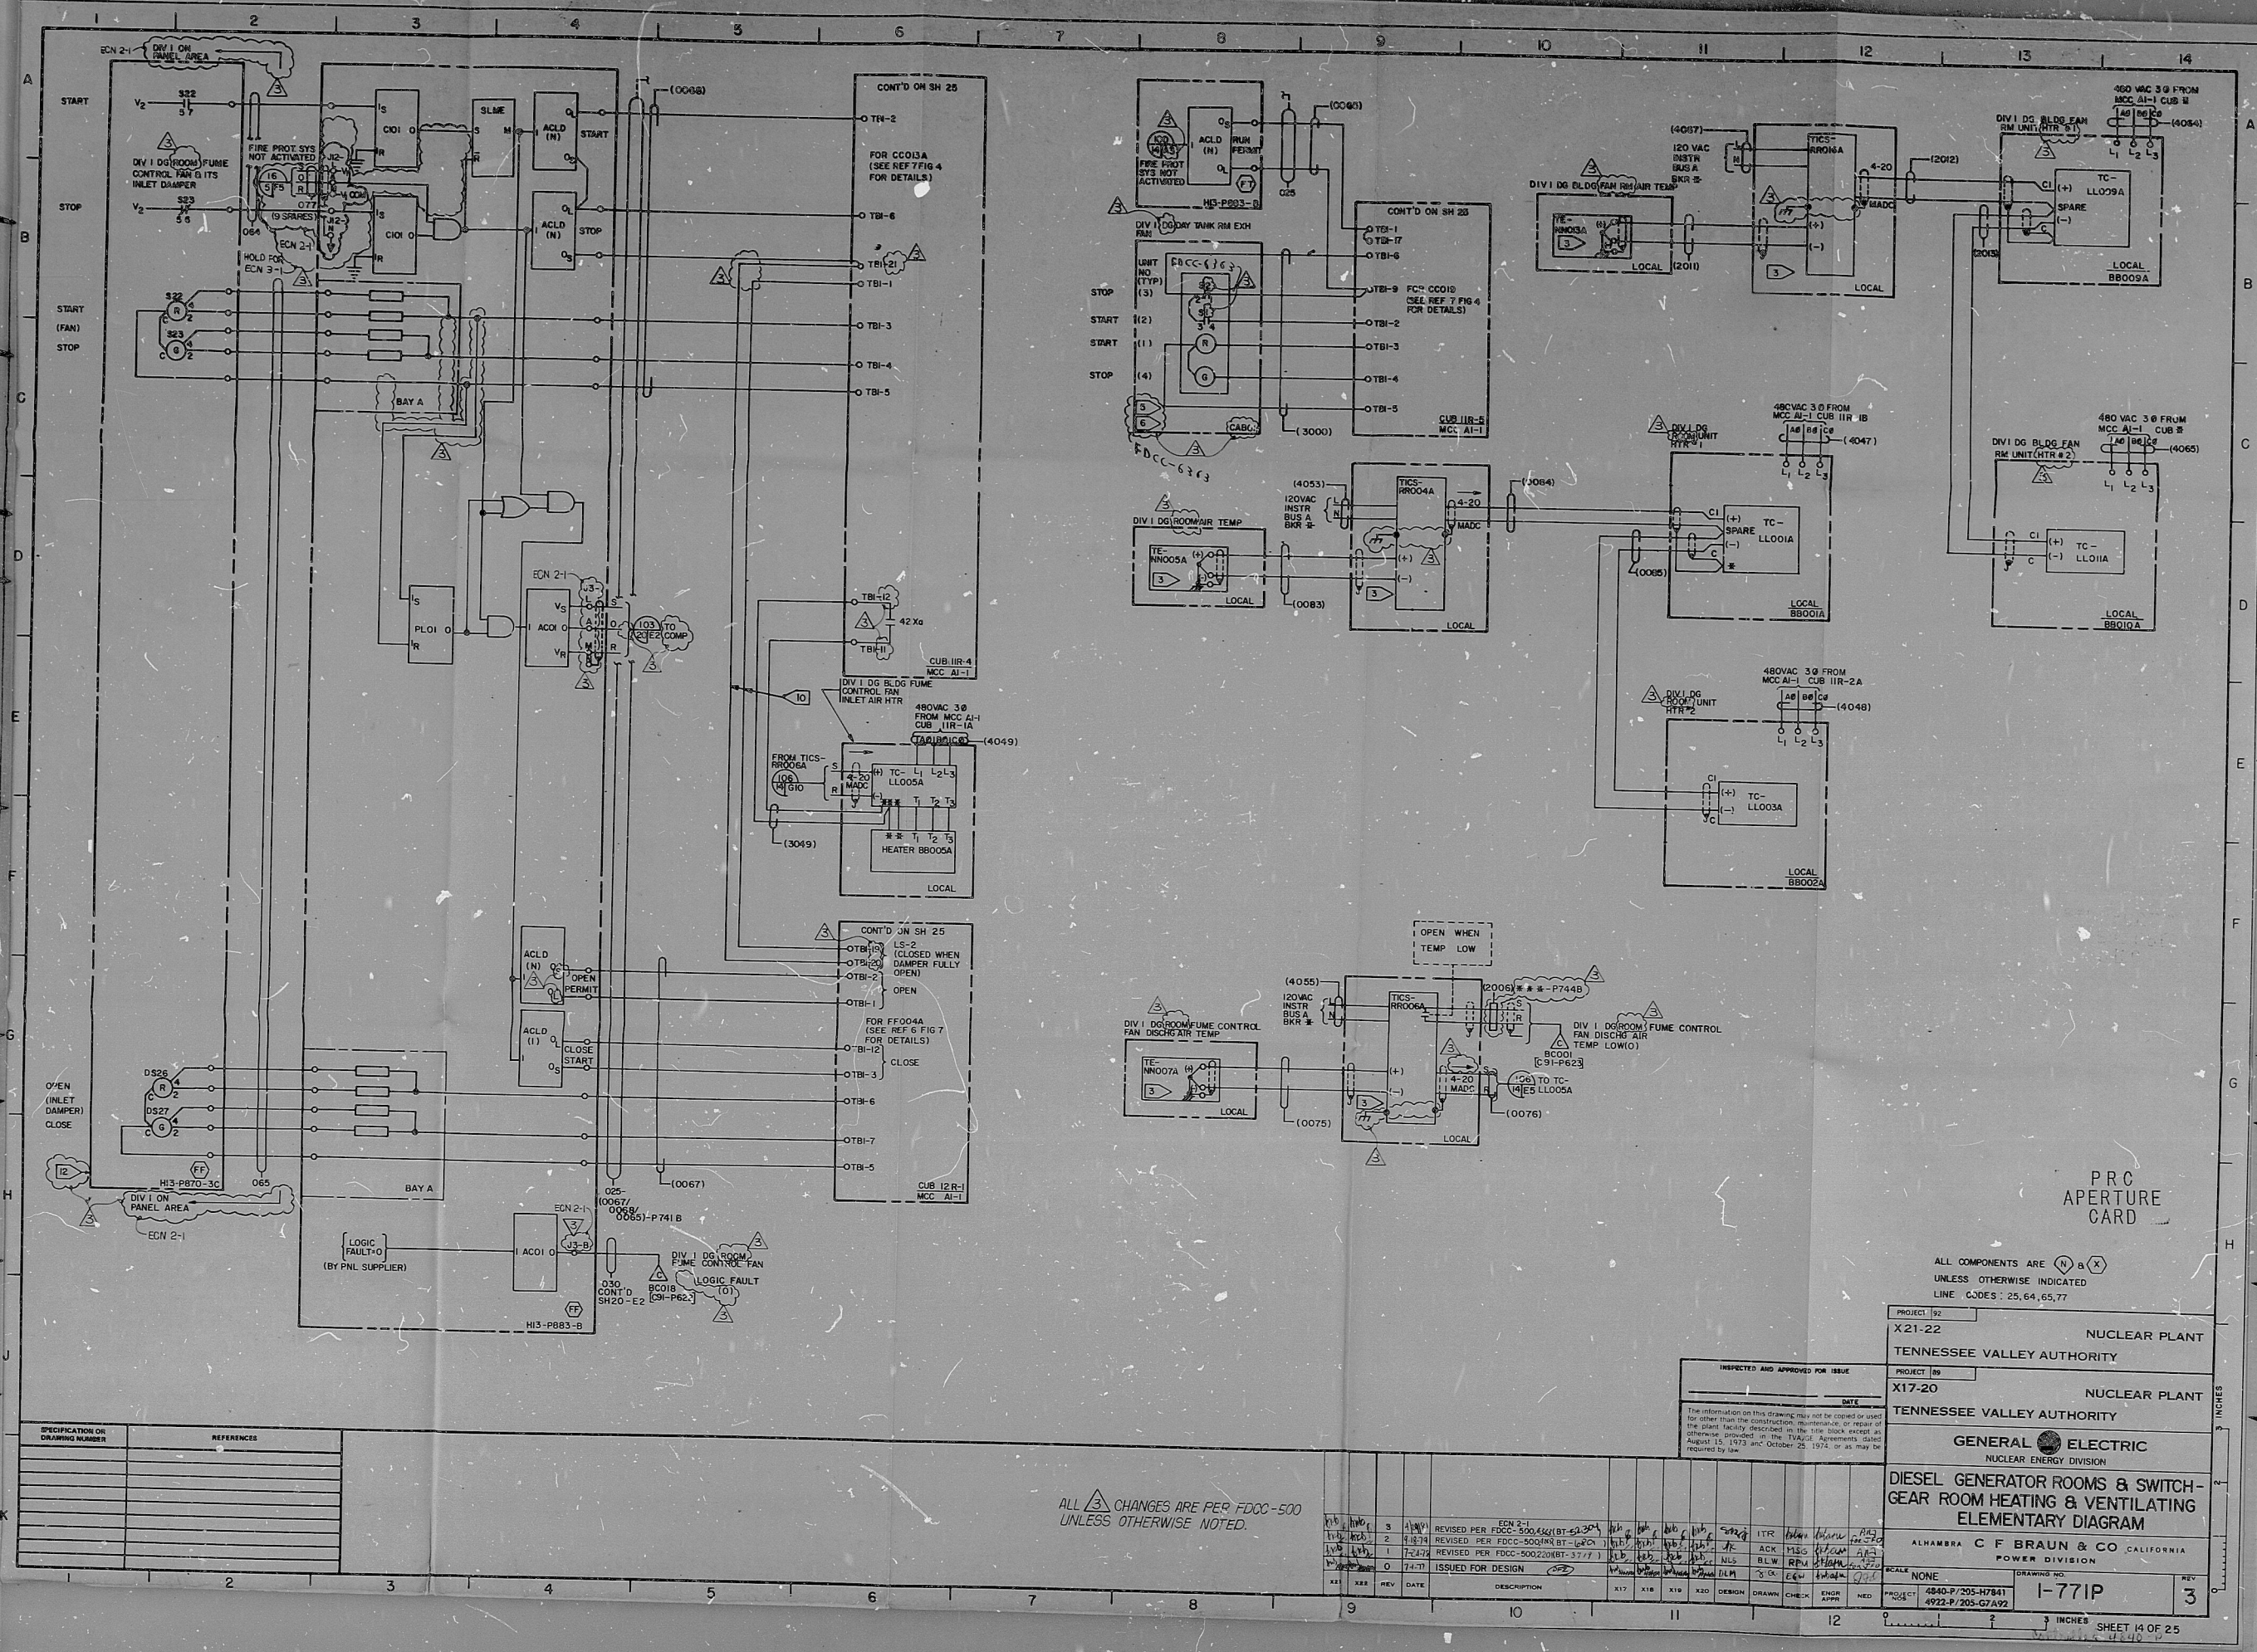

ALL CHANGES ARE PER FDCC-500
UNLESS OTHERWISE NOTED.

PROJECT 22		X21-22		NUCLEAR PLANT	
Tennessee Valley Authority		PROJECT 22		X17-20	
Tennessee Valley Authority		GENERAL ELECTRIC		NUCLEAR ENERGY DIVISION	
DIESEL GENERATOR ROOMS & SWITCHGEAR ROOM HEATING & VENTILATING ELEMENTARY DIAGRAM		ALHAMBRA C F BRAUN & CO CALIFORNIA		POWER DIVISION	
DRAWING NO. 1-771P		REV. 3		SHEET 14 OF 25	

RIDS

806160253

