


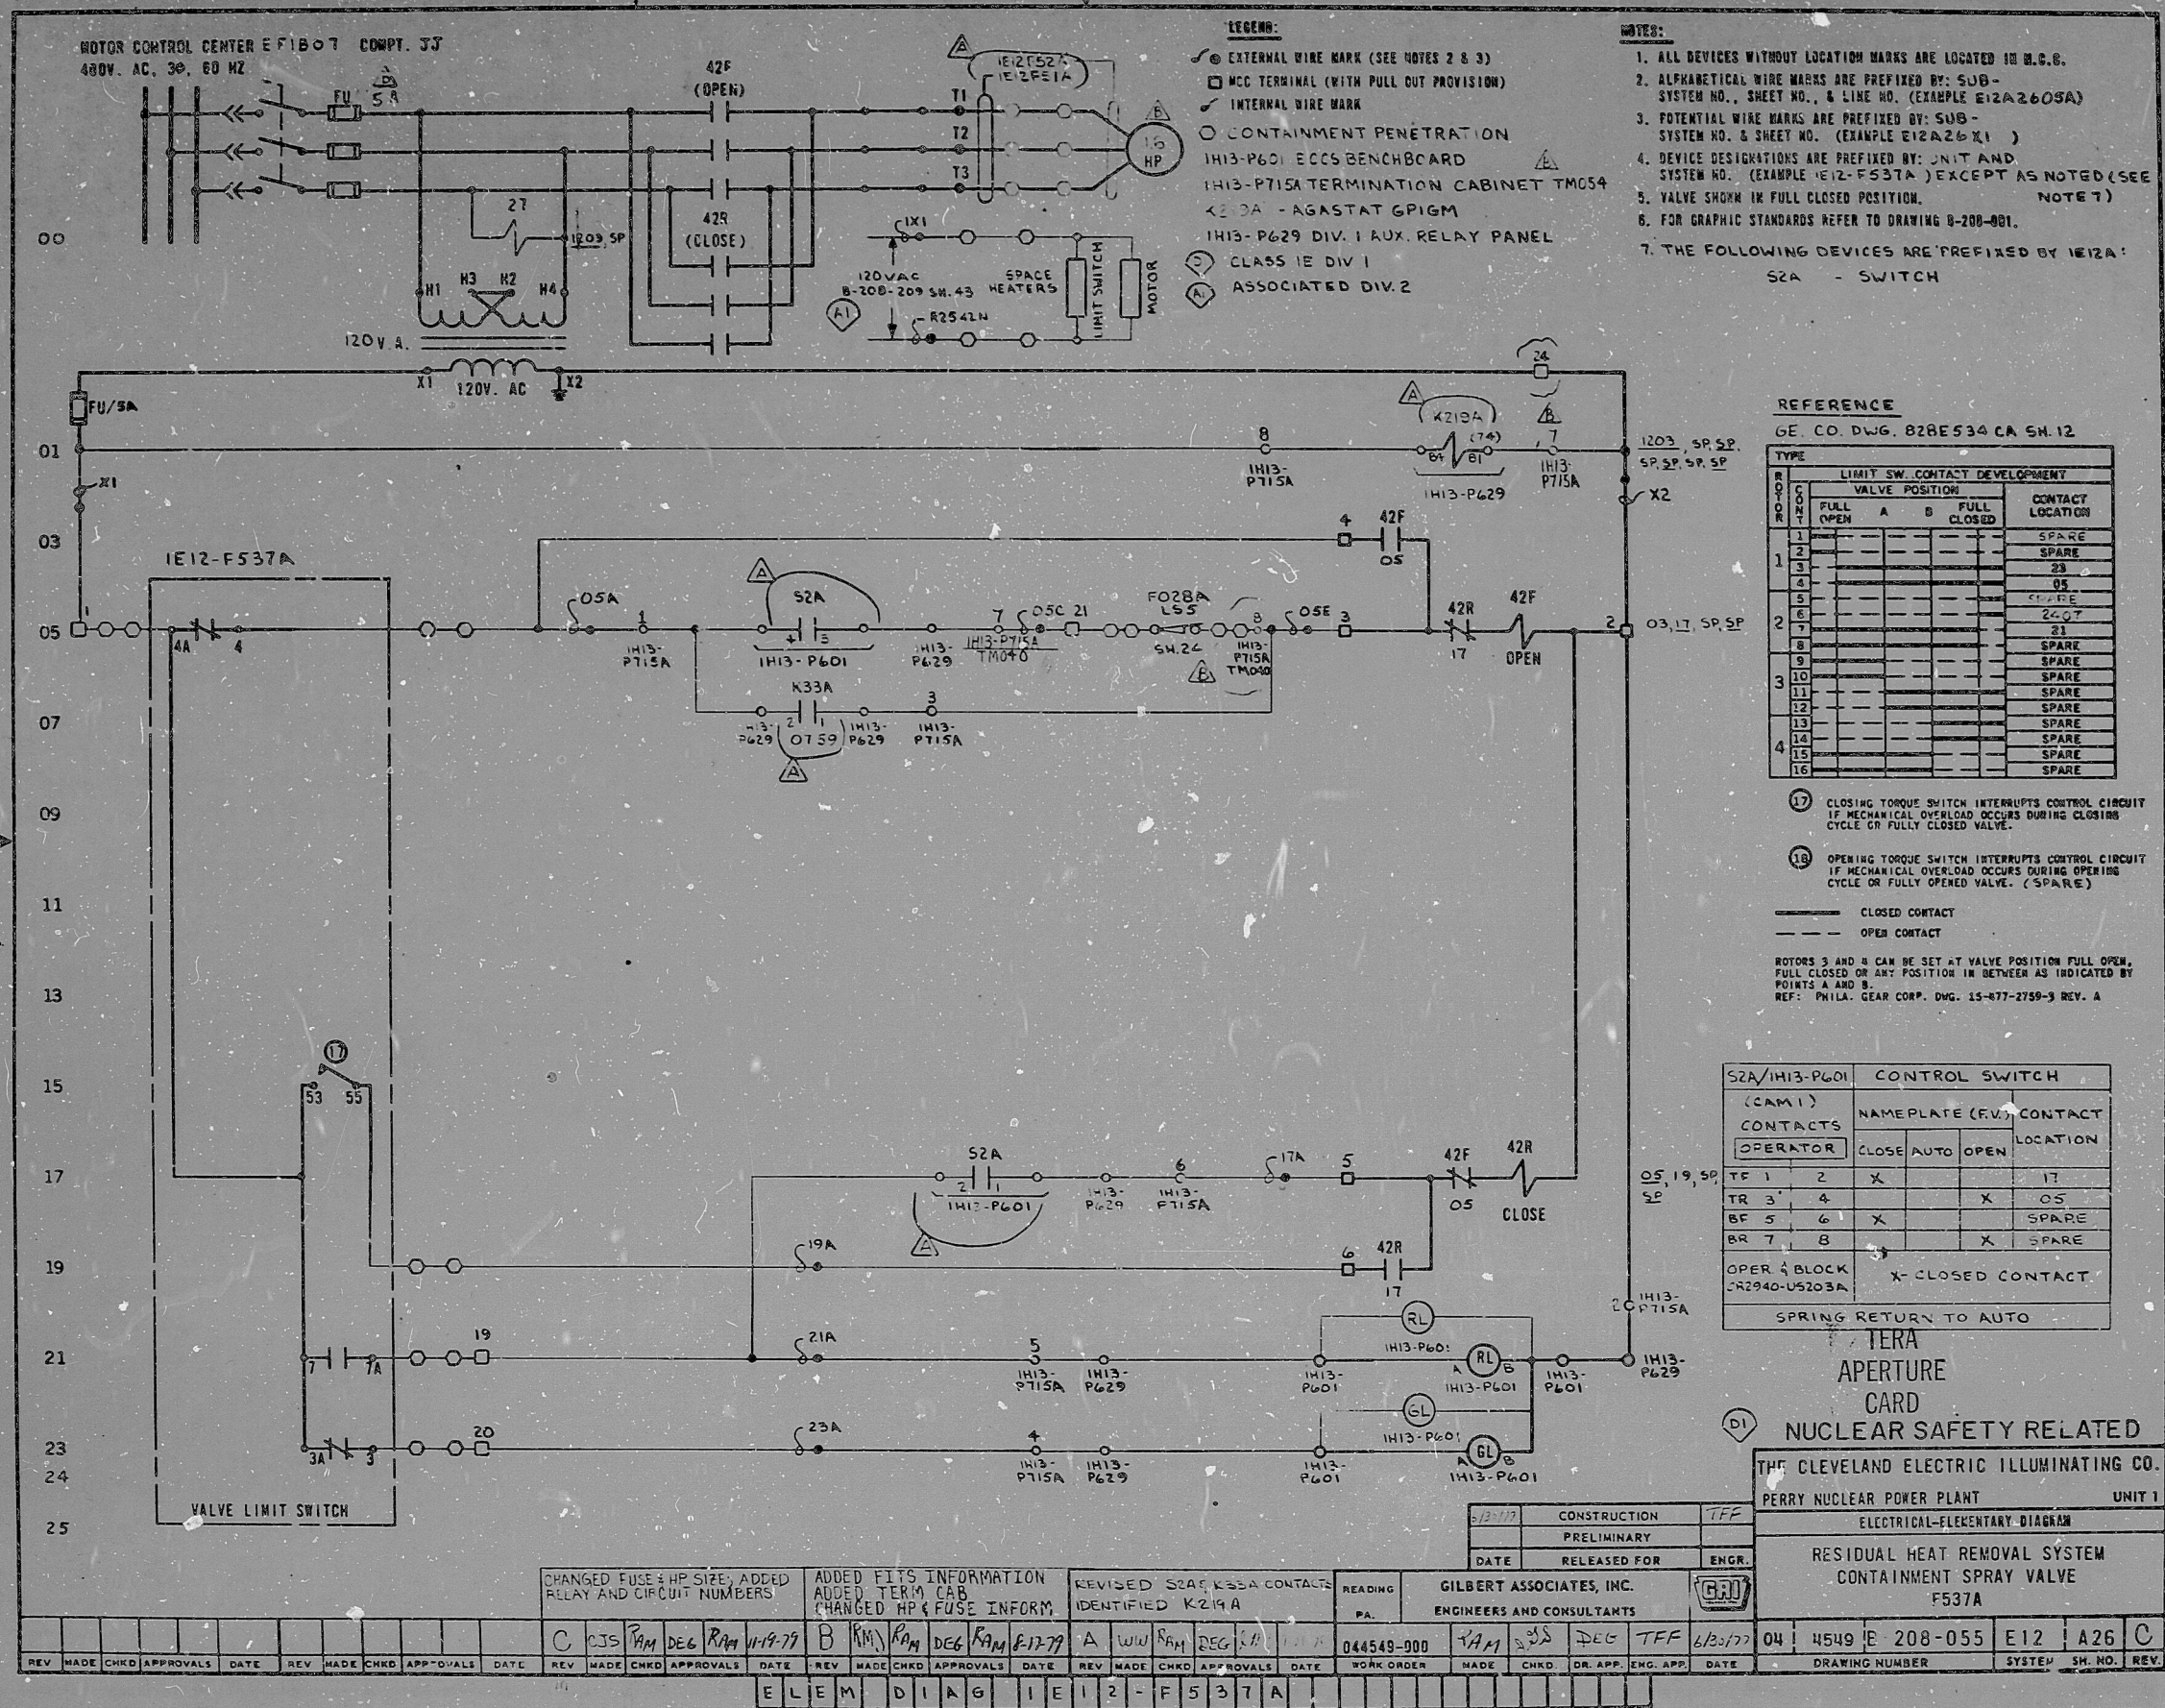

RIDS-PDR

8103230526

