

DRAWING NUMBER
FM-47A

DESIGNER


CHECKED

DATE

CLASS

DRAWING NUMBER
FM-47A

REV. 28

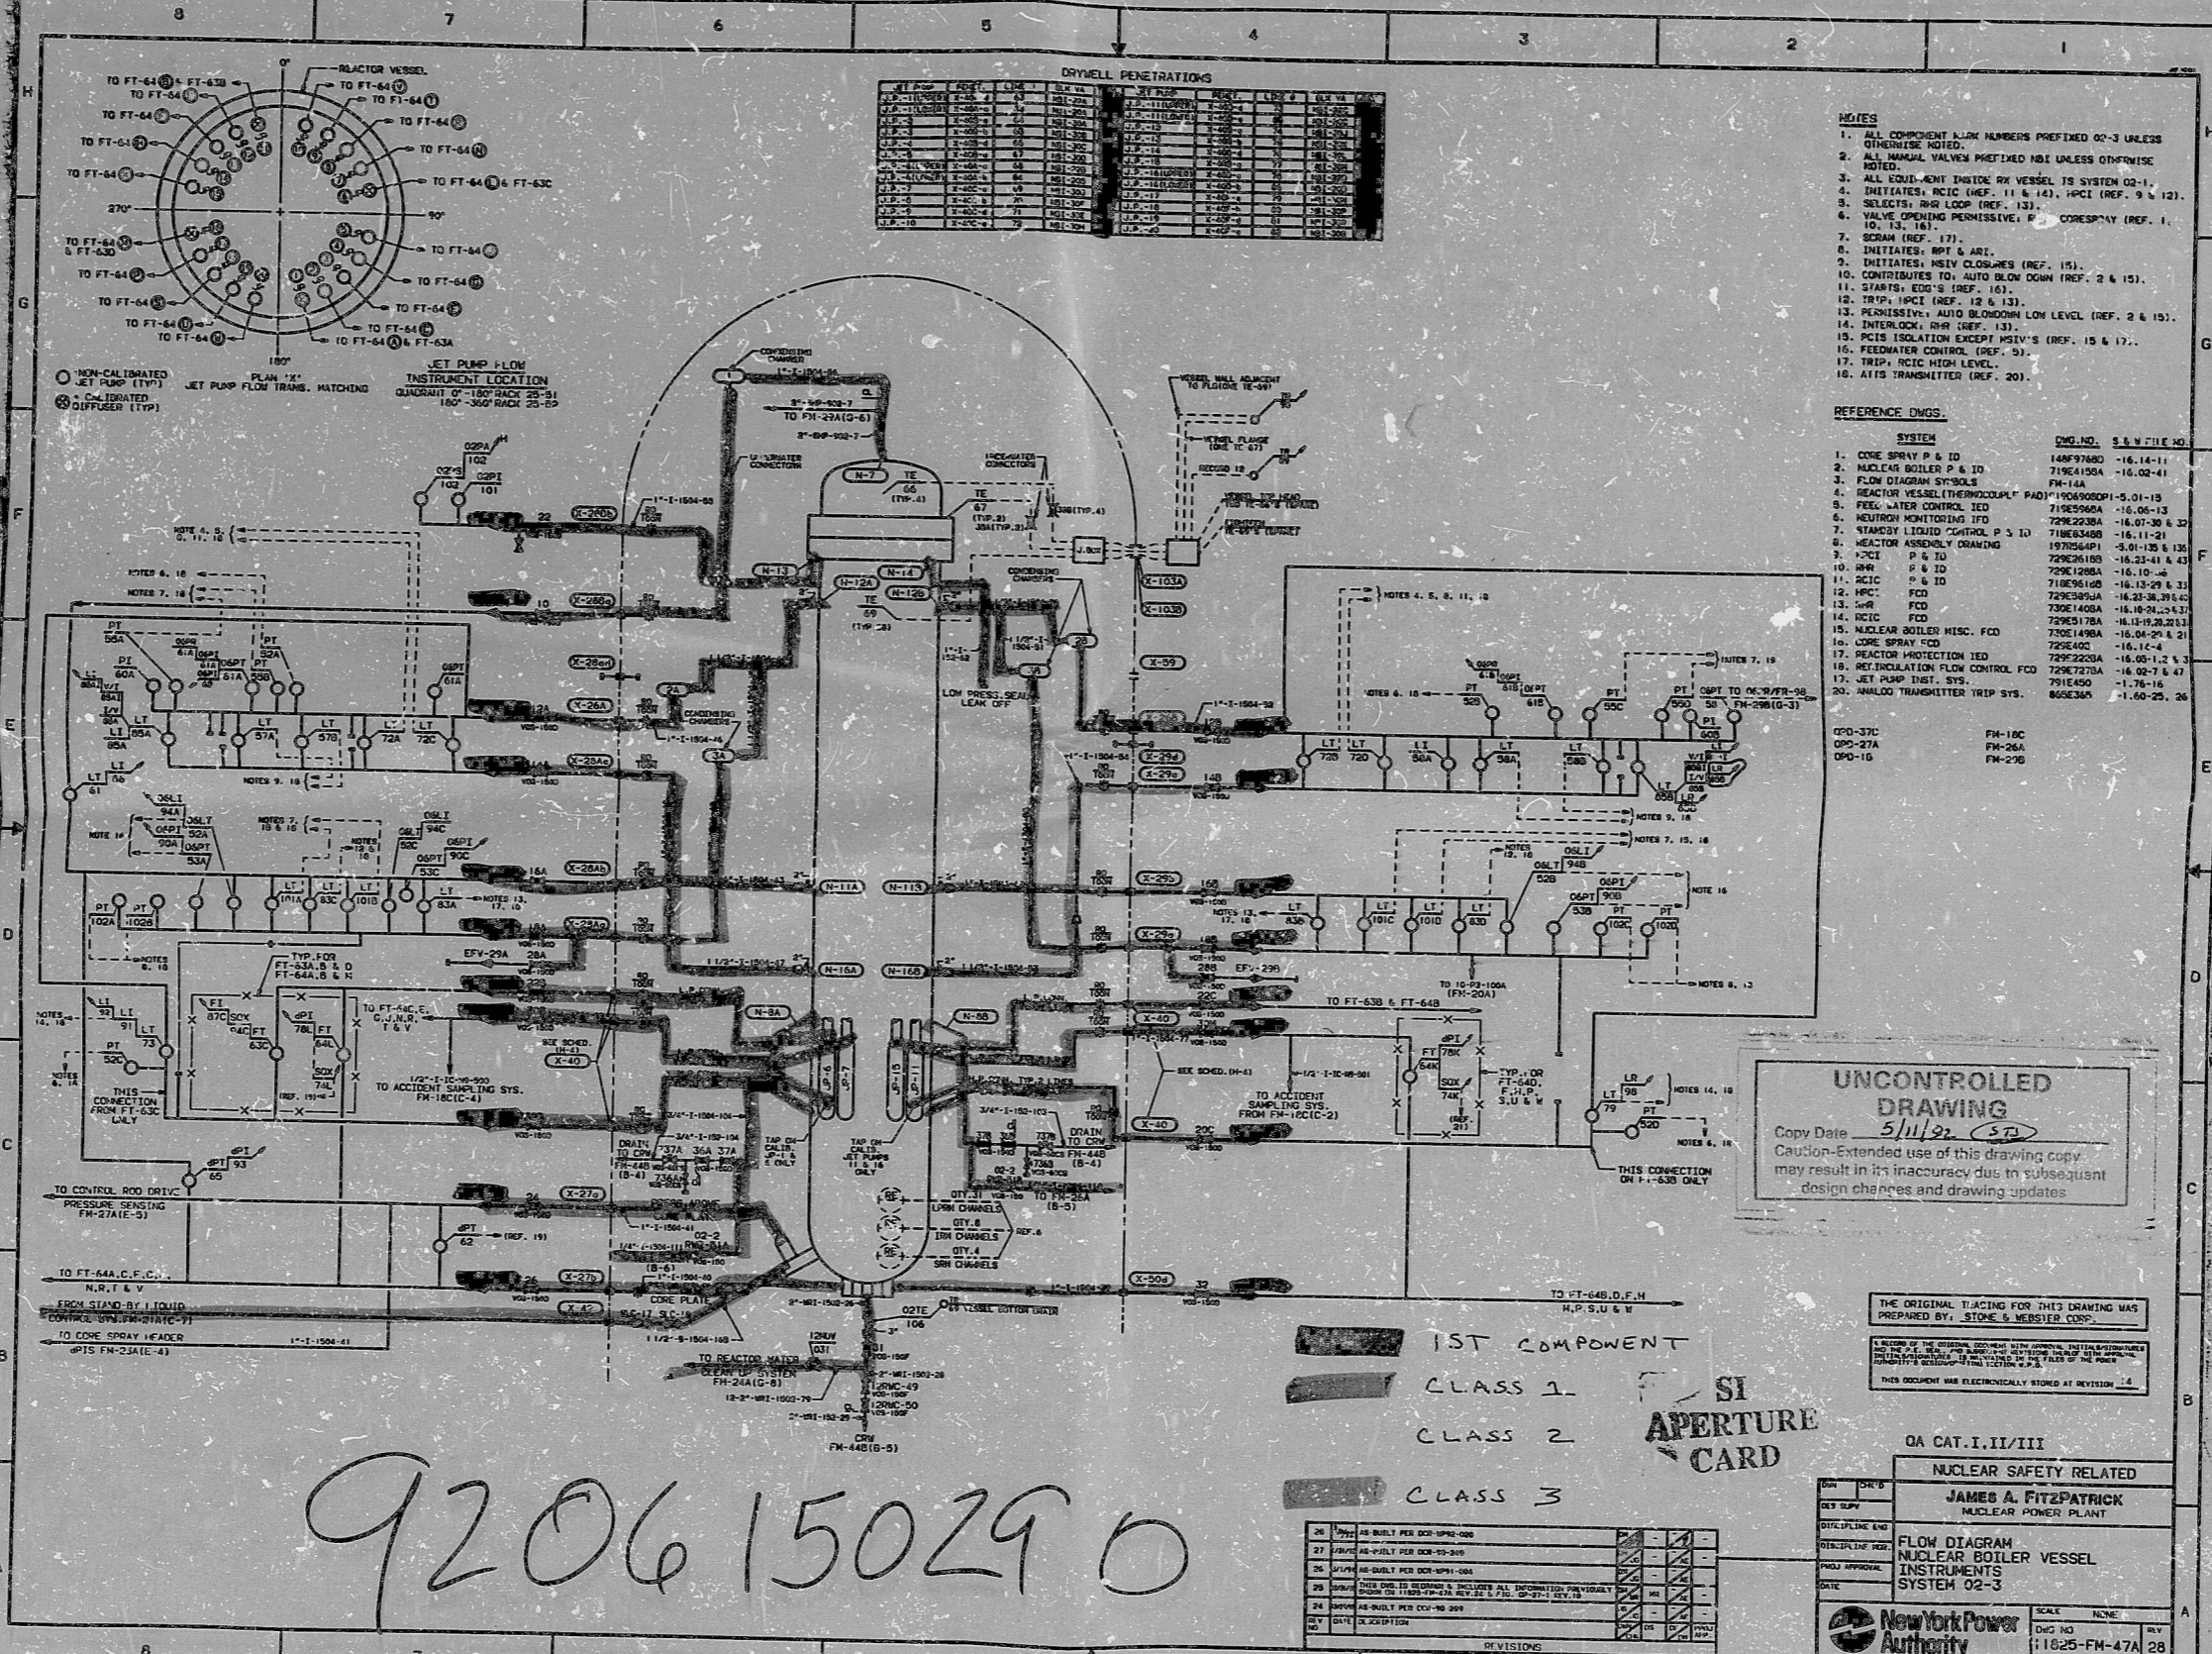

THE ORIGINAL TRACING FOR THIS DRAWING WAS PREPARED BY: STONE & WEBSTER CORP.

THIS DOCUMENT HAS ELECTRONICALLY SIGNED AT REVISION: 28

ON CAT. I, II, III

NUCLEAR SAFETY RELATED	
REV.	DATE
DESIGN	...
DRAWING ENG.	...
DESIGNING	...
PROJ. APPROVAL	...
DATE	...

FLOW DIAGRAM
NUCLEAR BOILER VESSEL
INSTRUMENTS
SYSTEM 02-3

New York Power Authority

SCALE: NONE

DWG. NO: 11025-FM-47A

SHEET OF 28

REF: DPO-27C

PDR RIDS

9206150290

