
[illegible]

PDR RDS

85052/0560

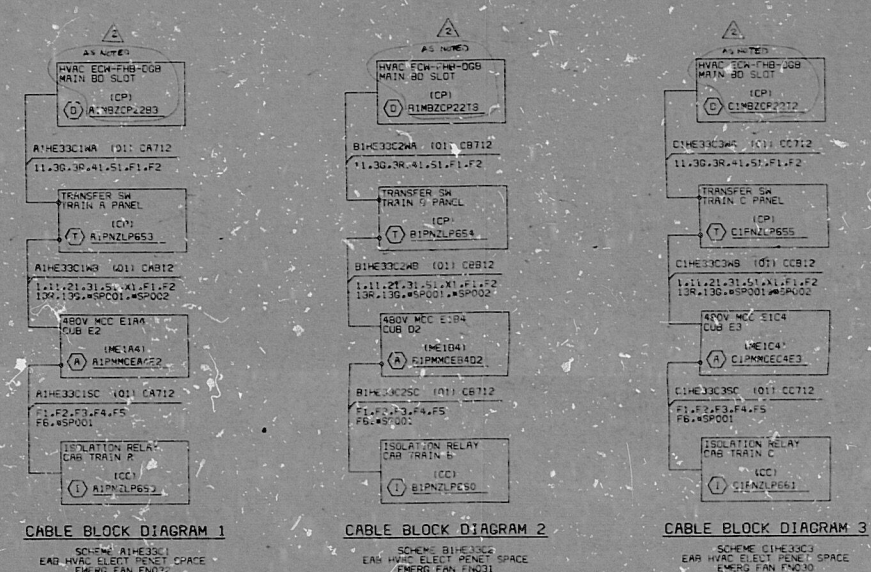