




RIDS PDR 8103230730

8103230730

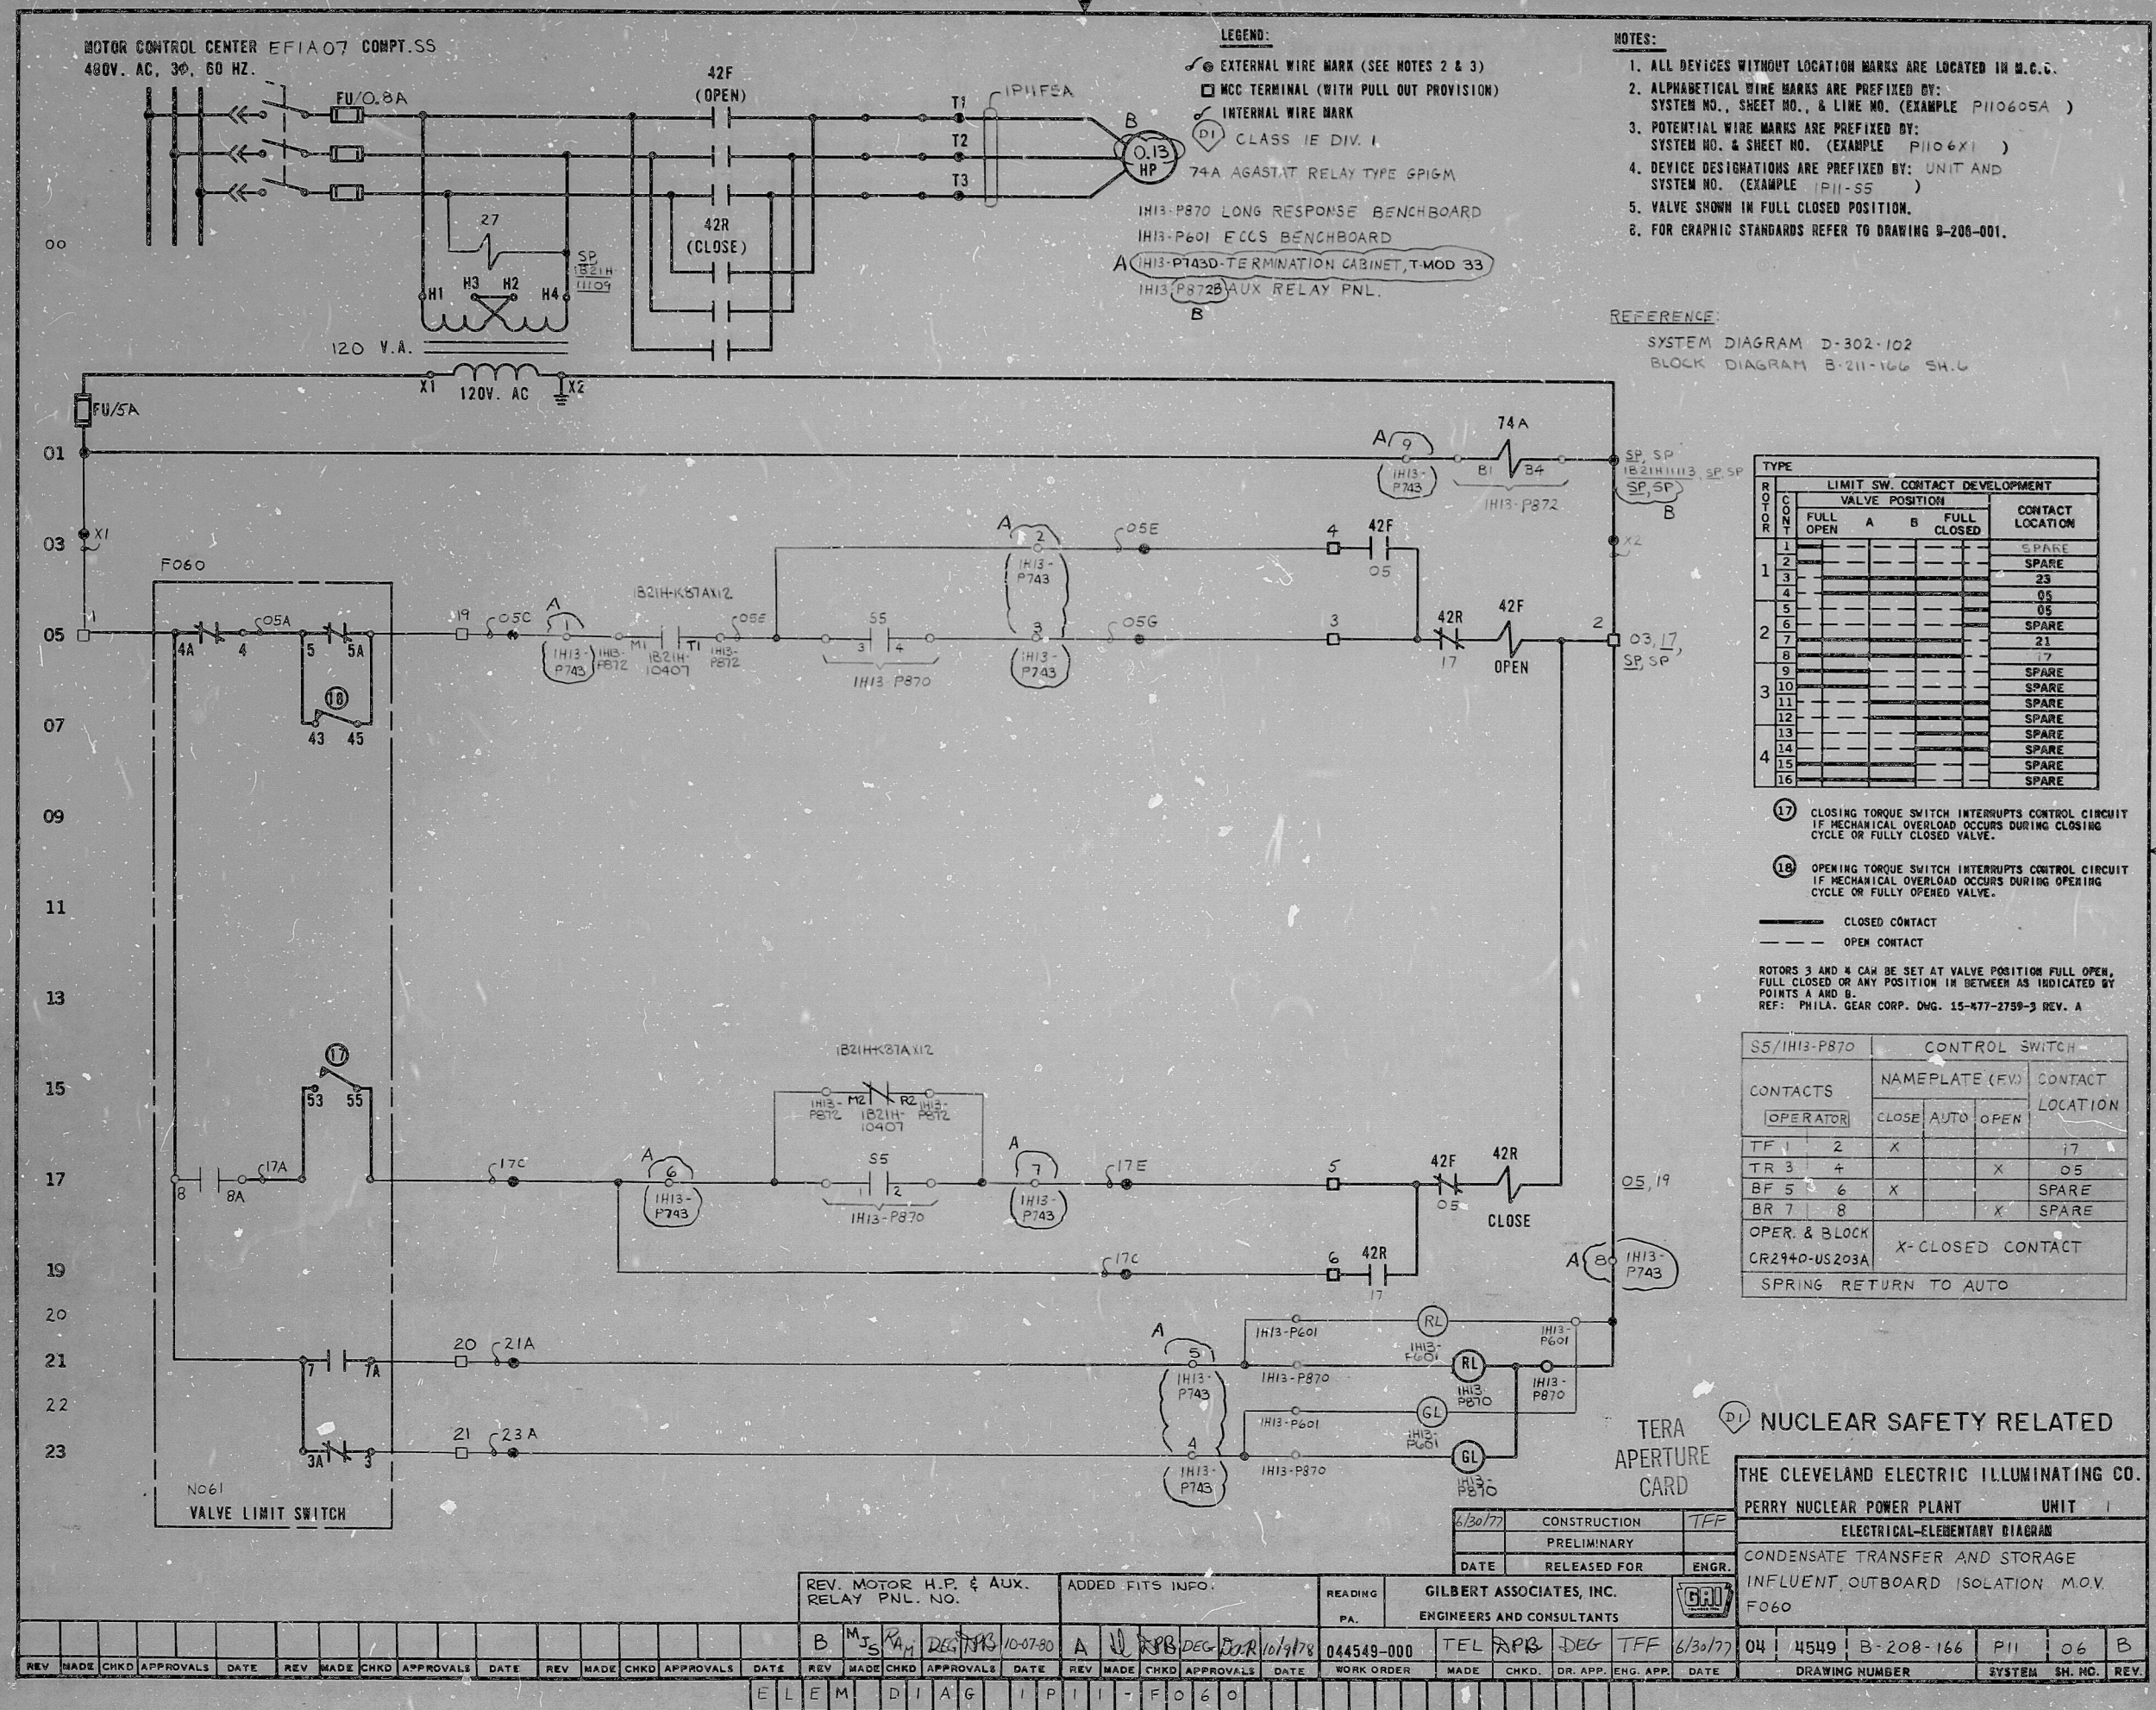