

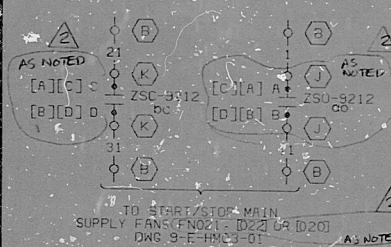


DC78F 02/27/85 10:45 MGM COMP. D

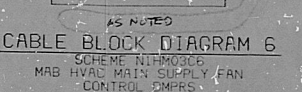

CONTACT			POSITION				
HANDLE END	NUMBER	START	AUTO AFTER		STOP	STOP TO LOCK	
			START	STOP			
1 10 20	2	1				x	
• • • •	3					x	
3 30 40	4	3			x	x	
• • • •	4				x		
5 50 60	6	5	x	x	x		
• • • •	6	6	x				
7 70 80	8	7	x	x			
• • • •	8		x	x			
9 90 100	10	9	x	x			
• • • •	10	10	x	x			

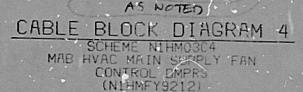

CONTACT	DAMPER POSITION		USE
	CLOSE	OPEN	
A-B (b/c)			THIS DWG
C-D (b/c)			RED LT
G-H (b/c)			SPARE
E-F (a/c)			SPARE

HOUSTON OFFICE ISSUED
INFORMATION ONLY
STP 14926

- AS 1

PDR RIDS

8505280043

