
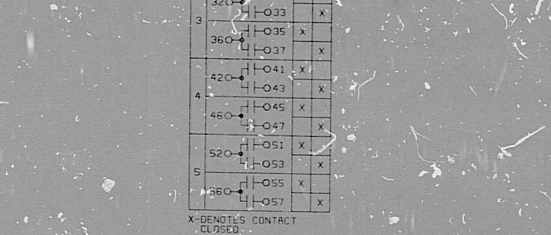
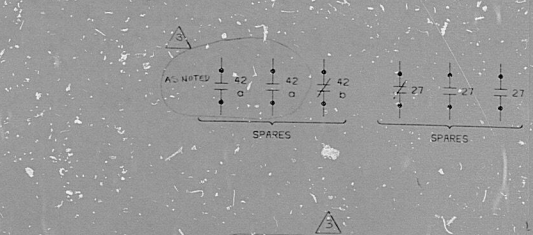
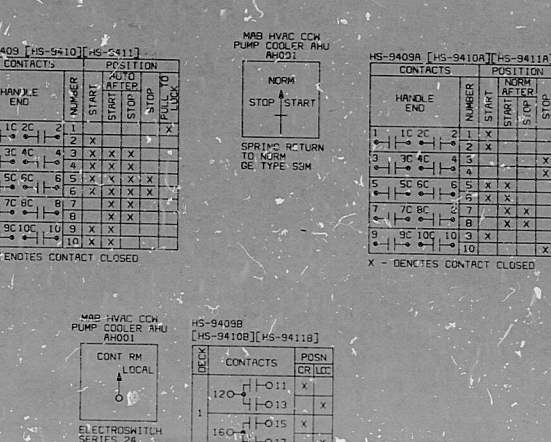
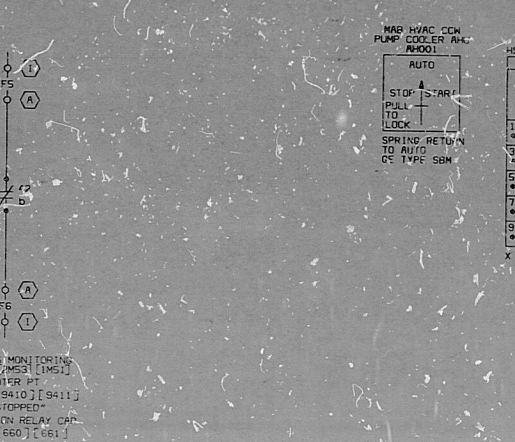
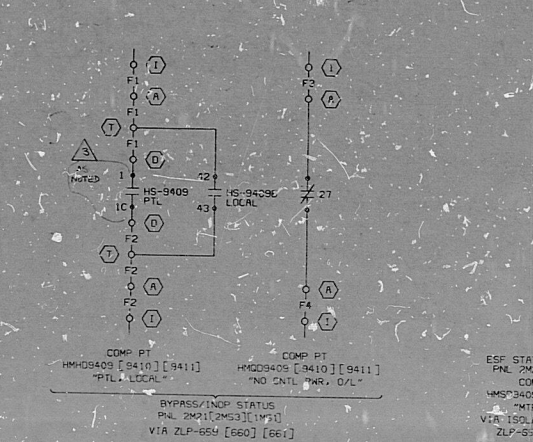
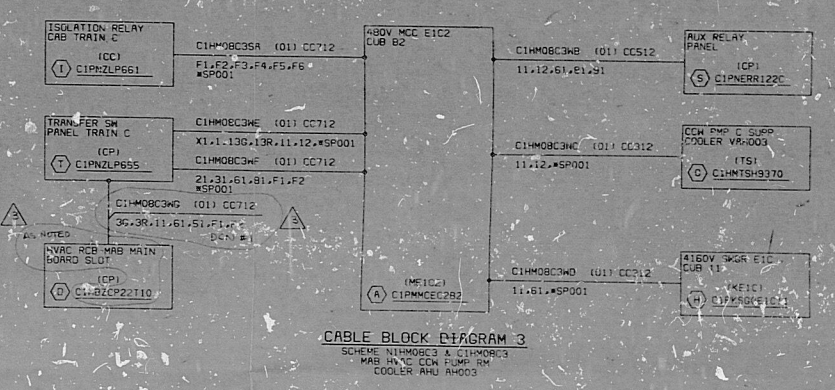
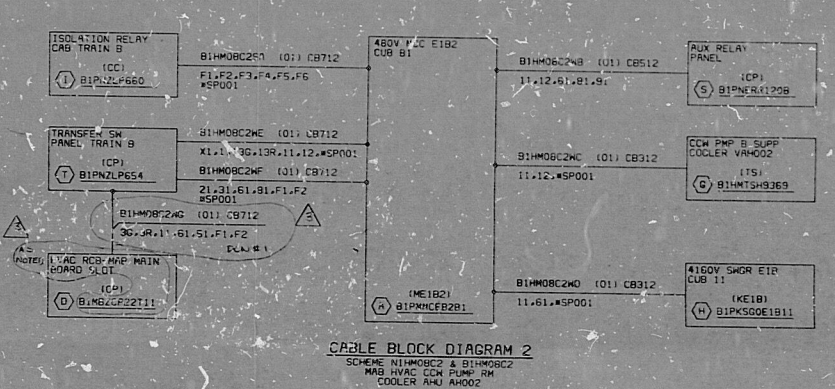
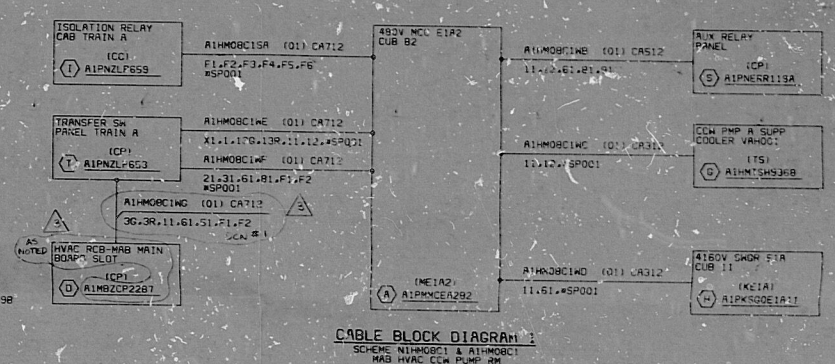


THIS DRAWING AND THE DESIGN IT CONTAINS ARE THE PROPERTY OF BECHTEL. THEY ARE HEREBY LOANED AND ON THE BORROWER'S EXPRESS AGREEMENT THAT THEY WILL NOT BE REPRODUCED, COPIED, LOANED, EXHIBITED, OR USED EXCEPT IN THE LIMITED WAY AND PRIVATE USE PERMITTED BY THE LENDER TO THE BORROWER.

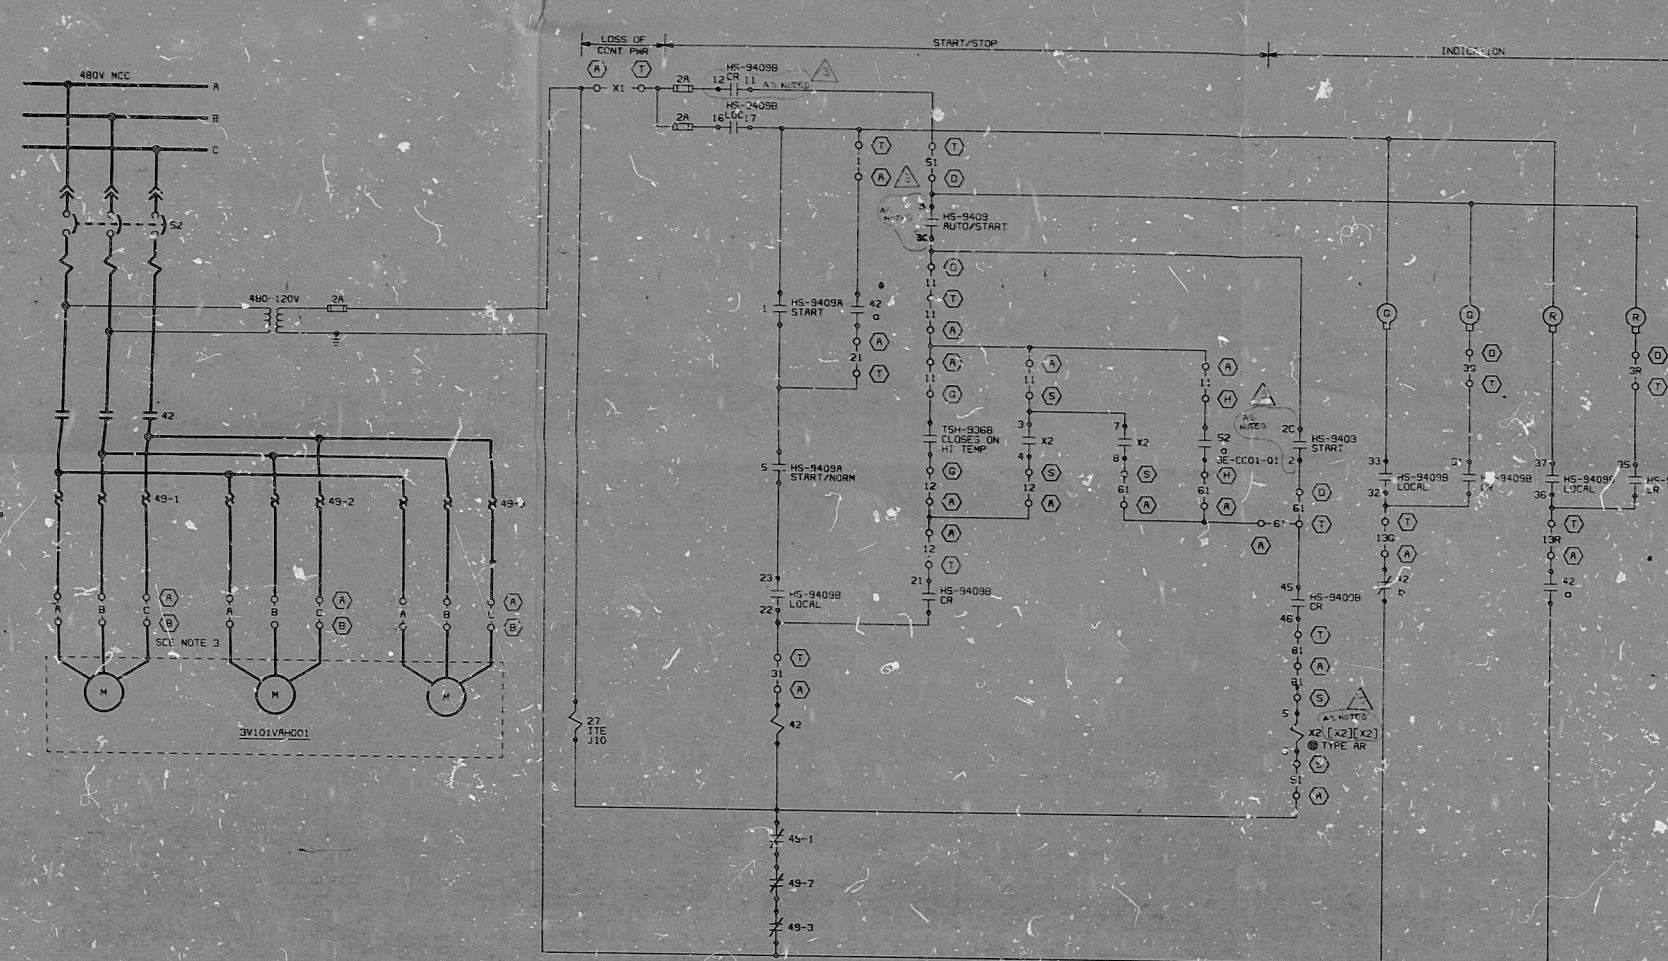

NO.	DESCRIPTION	DATE	BY	CHKD.	APP'D.

NOTES:

- FOR LEGEND AND SYMBOLS REFER TO DRAWINGS 9-E-NZ01-01 & 9-E-NZ01-02.
- LOCATES LOCATION NUMBER FOR COMPLETE LOCATION NUMBER REFER TO CABLE BLOCK DIAGRAM SHOWN ON THIS DRAWING.
- CABLE NUMBERS FOR POWER CABLES ARE ASSIGNED FROM REFERENCED ONE LINE DRAWINGS.
- THIS DRAWING SUPERSEDES BAR AND NO. 41015353, 41015354, 41015355, 41015356, 41015357 & 41015358.
- ELEMENTARY SHOWN IS FOR AH001, FOR AH002 & AH003 IS SIMILAR EXCEPT AS SHOWN ON CABLE BLOCK DIAGRAM AND IN SCHEDULES.

HOUSTON OFFICE ISSUED
INFORMATION ONLY
STP 14526

NUCLEAR SAFETY RELATED

ELEMENTARY DIAGRAM
MAB HVAC
CCK PUMP RM COOLER AHU
AH001, AH002 & AH003

BECHTEL ENERGY CORPORATION
HOUSTON, TEXAS

HOUSTON LIGHTING & POWER CO.
SOUTH TEXAS PROJECT

SCALE	JOB NO.	DRAWING NO.	REV.
NONE	14028	9-E-HM08-01	3

PDR RIDS

8505280051

