
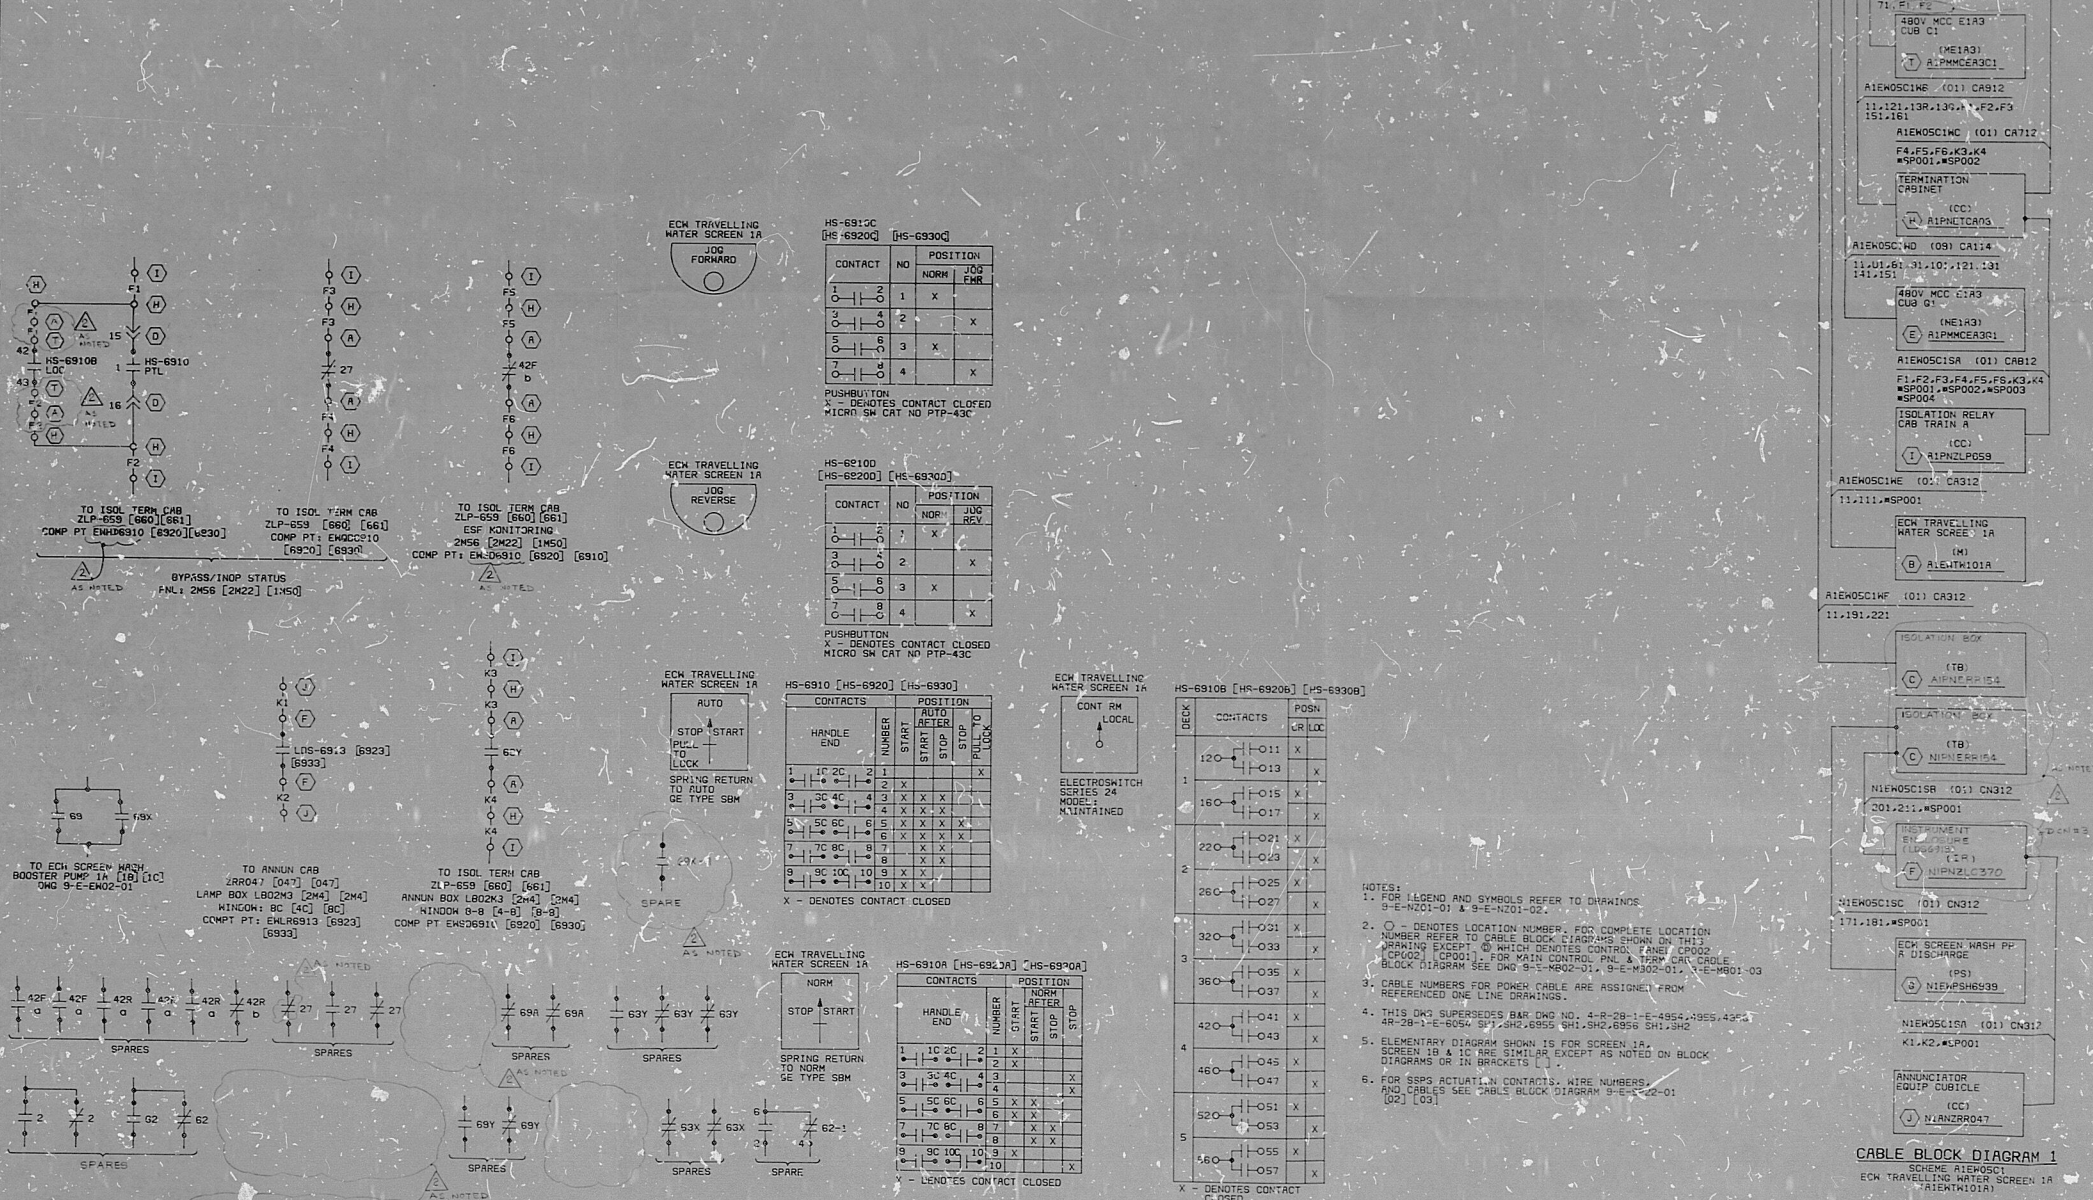


THIS DRAWING AND THE DESIGN IT COVERS ARE THE PROPERTY OF BECHTEL. THEY ARE HEREBY LOANED AND ON THE BORROWER'S EXPRESS AGREEMENT THAT THEY WILL NOT BE REPRODUCED, COPIED, LOANED, USED EXCEPT IN THE LIMITED WAY AND PRIVATE USE PERMITTED BY ANY WRITTEN COVENANT GIVEN BY THE LENDER TO THE BORROWER.

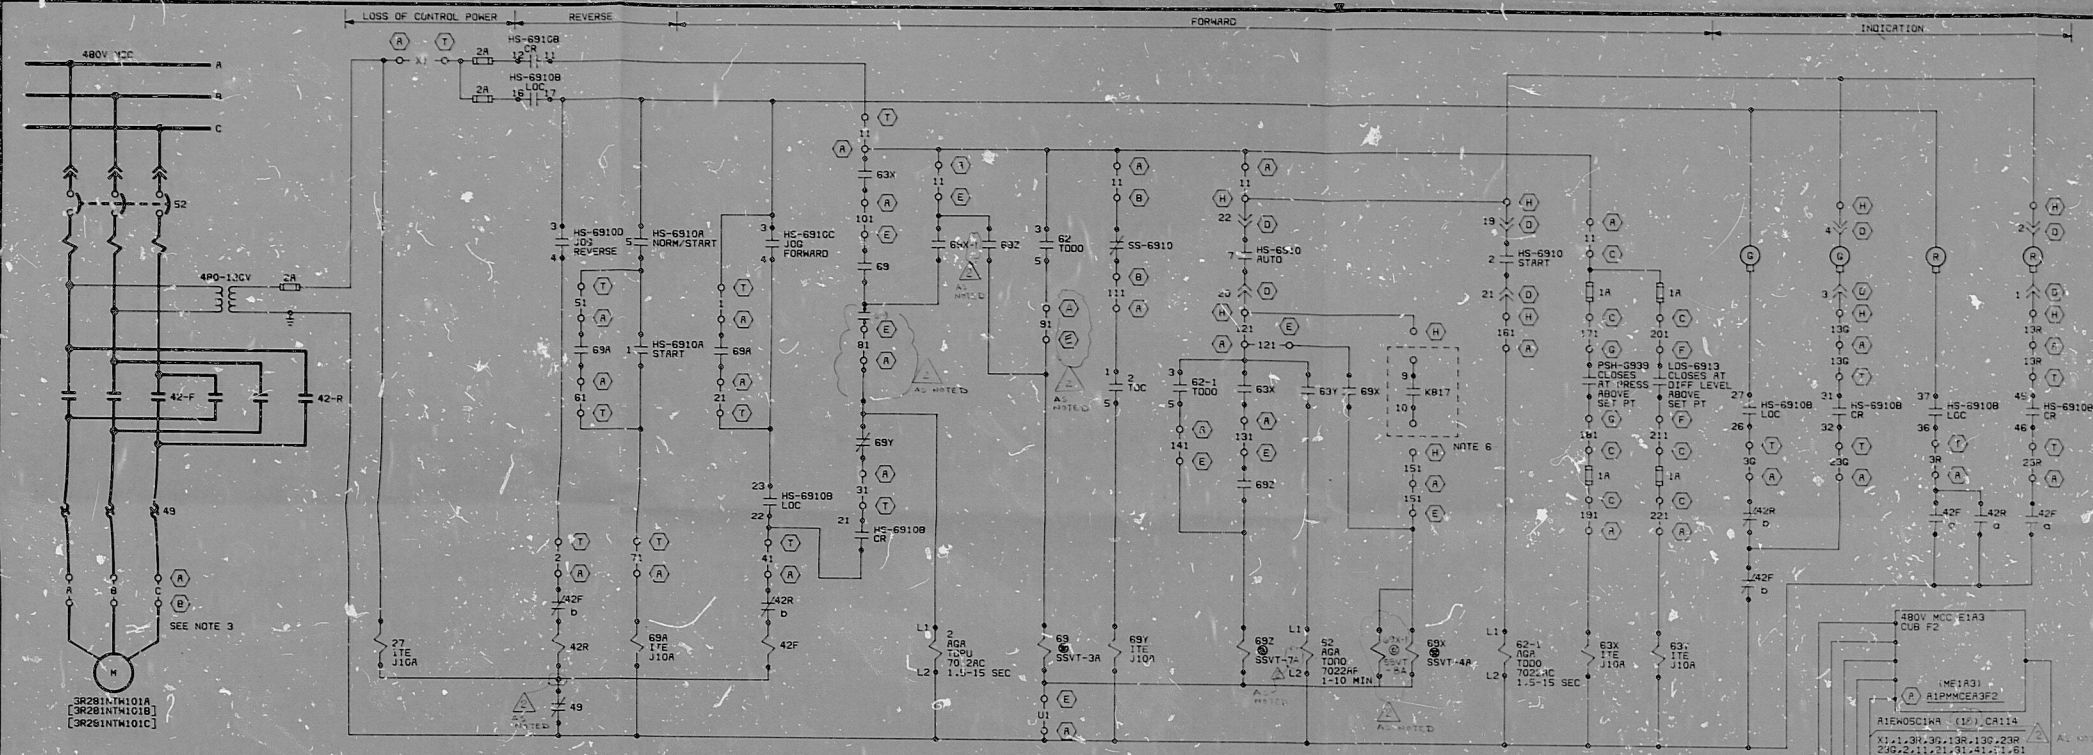

| NO. | DATE    | REVISION | BY           | CHK          | Q | APP | PE |
|-----|---------|----------|--------------|--------------|---|-----|----|

NUCLEAR SAFETY RELATED


TRAVELLING WATER SCREENS 1A, 1B & 1C








BECHTEL ENERGY CORPORATION

HOUSTON, TEXAS

HOUSTON LIGHTING & POWER CO.

SOUTH TEXAS PROJECT

PDR RIDS

8505280227

