




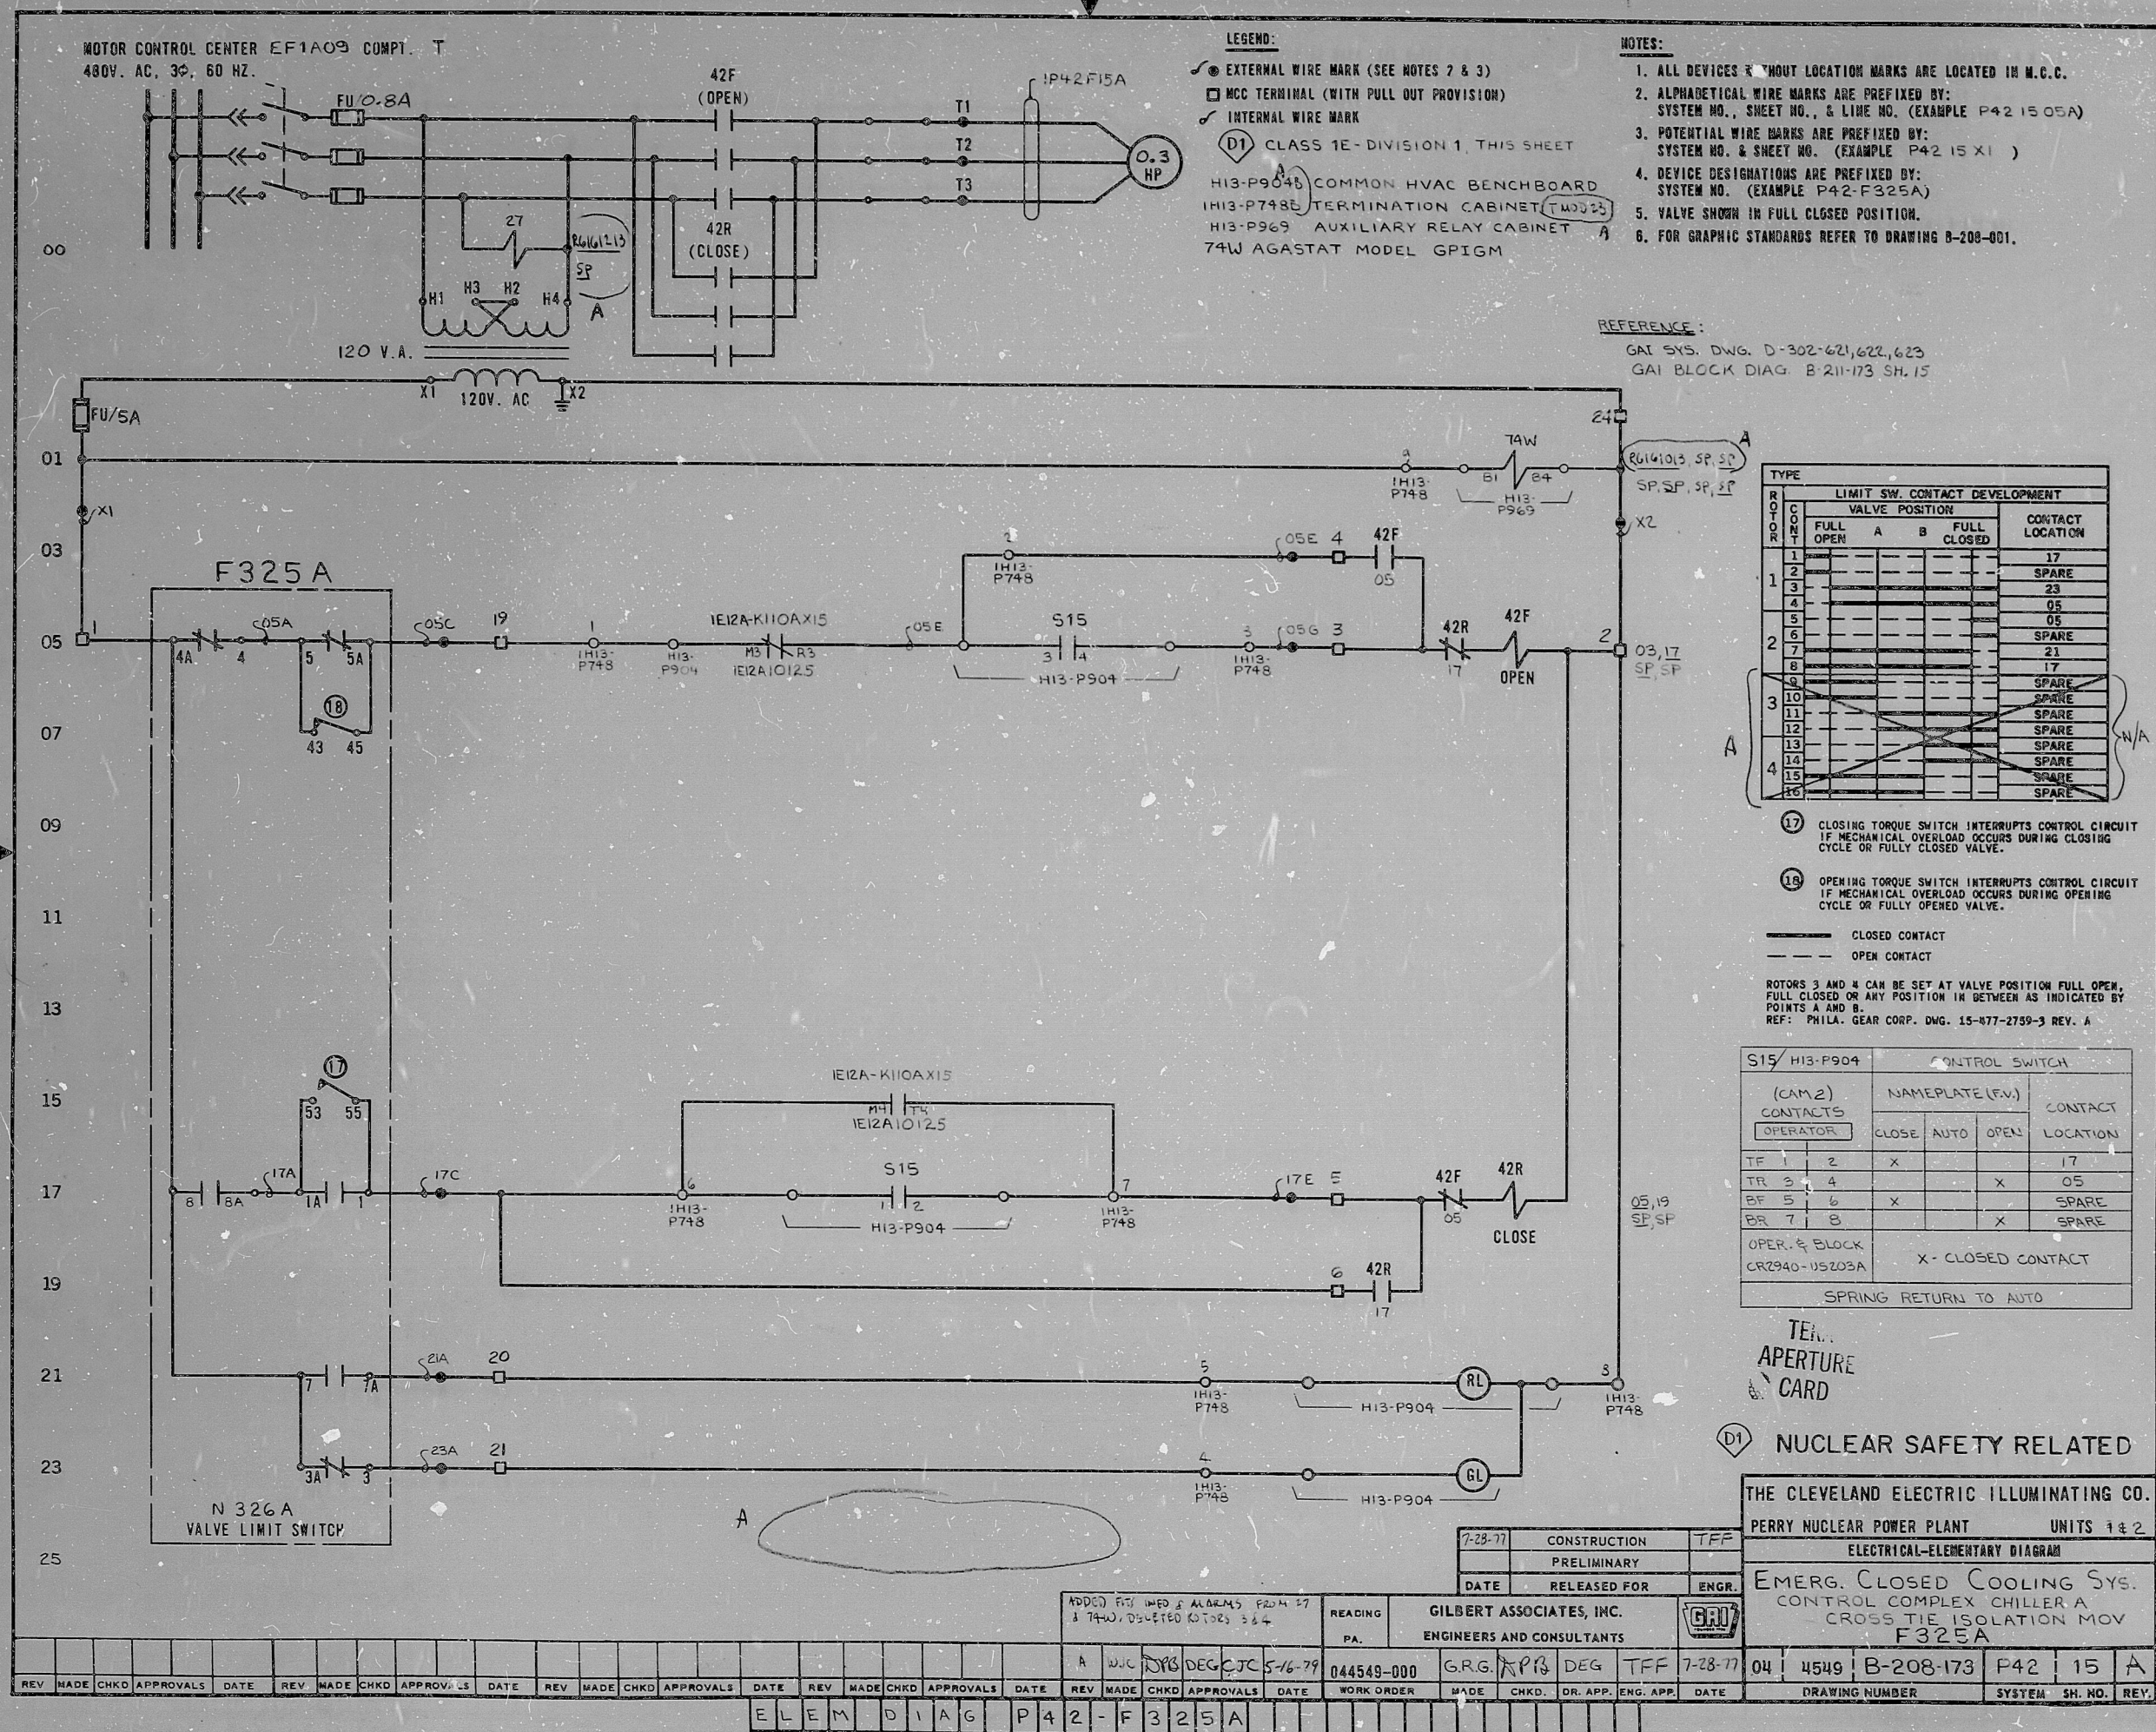

RIDS PDR

8103230804

