

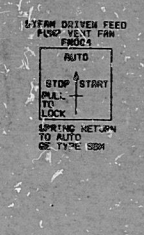


THIS DRAWING AND THE DESIGN IT REPRESENTS ARE THE PROPERTY OF BECHTEL. IT AND SIMILARLY LABELED AND ON THE BECHTEL PROPERTY. IT IS NOT TO BE REPRODUCED, COPIED, EXHIBITED, OR USED EXCEPT ON THE LIMITED AND PRIVATE USE PERMITTED BY ANY WRITTEN CONSENT GIVEN BY THE ENGINEER.

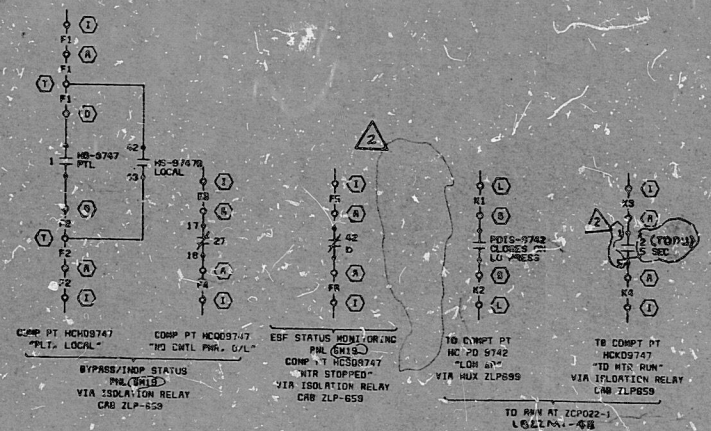


HS-9747 CONTACTS


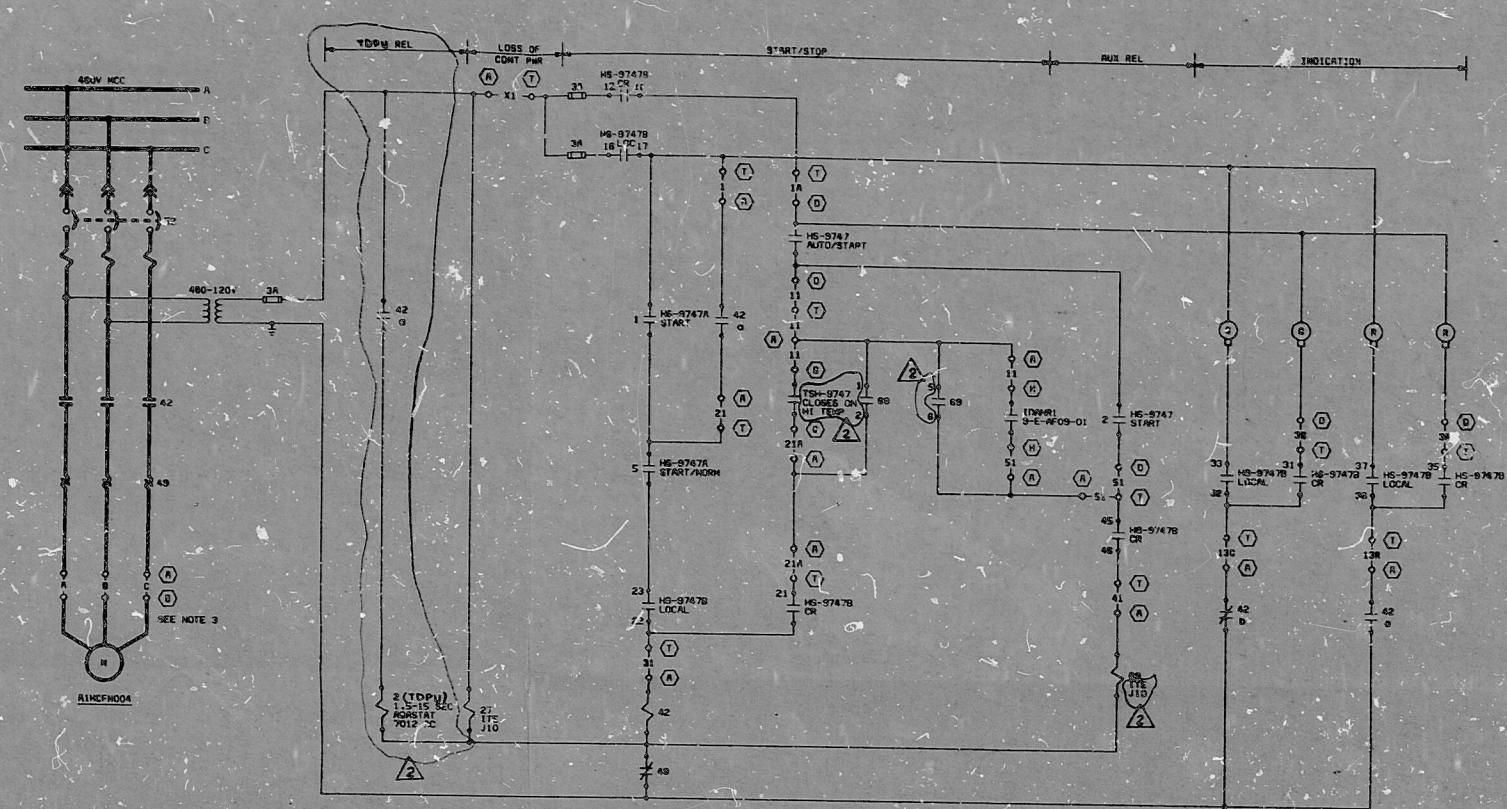


HS-9747A CONTACTS


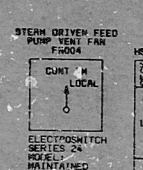

HS-9747B CONTACTS


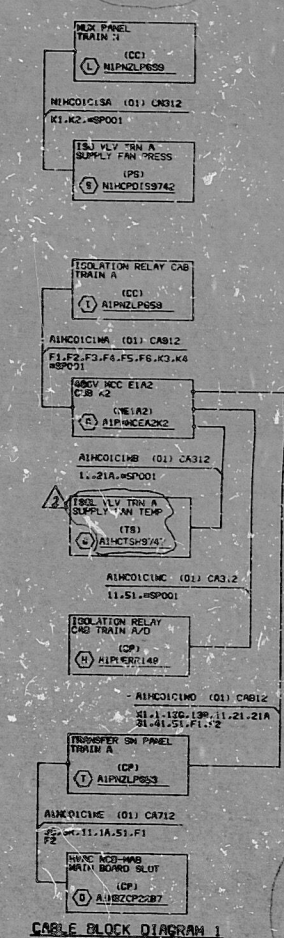

HOUSTON OFFICE ISSUED
INFORMATION ONLY
STP 14926

- NOTES:
1. FOR LEGEND AND SYMBOLS REFER TO DRAWING 9-E-MC01-01A, SEE NOTE 2.
 2. C- DENOTES LOCATION NUMBER, FOR COMPLETE LOCATION NUMBER REFER TO CABLE BLOCK DIAGRAM SHOWN ON THIS DRAWING.
 3. CABLE NUMBERS FOR POWER CABLES ARE ASSIGNED FROM REFERENCED ON THE DRAWINGS.

NO	REVISION	DATE	BY	CHKD	APP'D	REMARKS
1						REVISED 10/10/84
2						REVISED 10/10/84
BECHTEL ENERGY CORPORATION
HOUSTON, TEXAS
HOUSTON LIGHTING & POWER CO.
SOUTH TEXAS PROJECT

DSK0 Dwg Size X= 42.828 Y= 33.529 LV - OFF
TOTAL VECTORS = 32549
98/14/84 8:43:19 P48806
SULFAC X= 0.500 Y= 0.500

PDR RIDS

8505280273

