


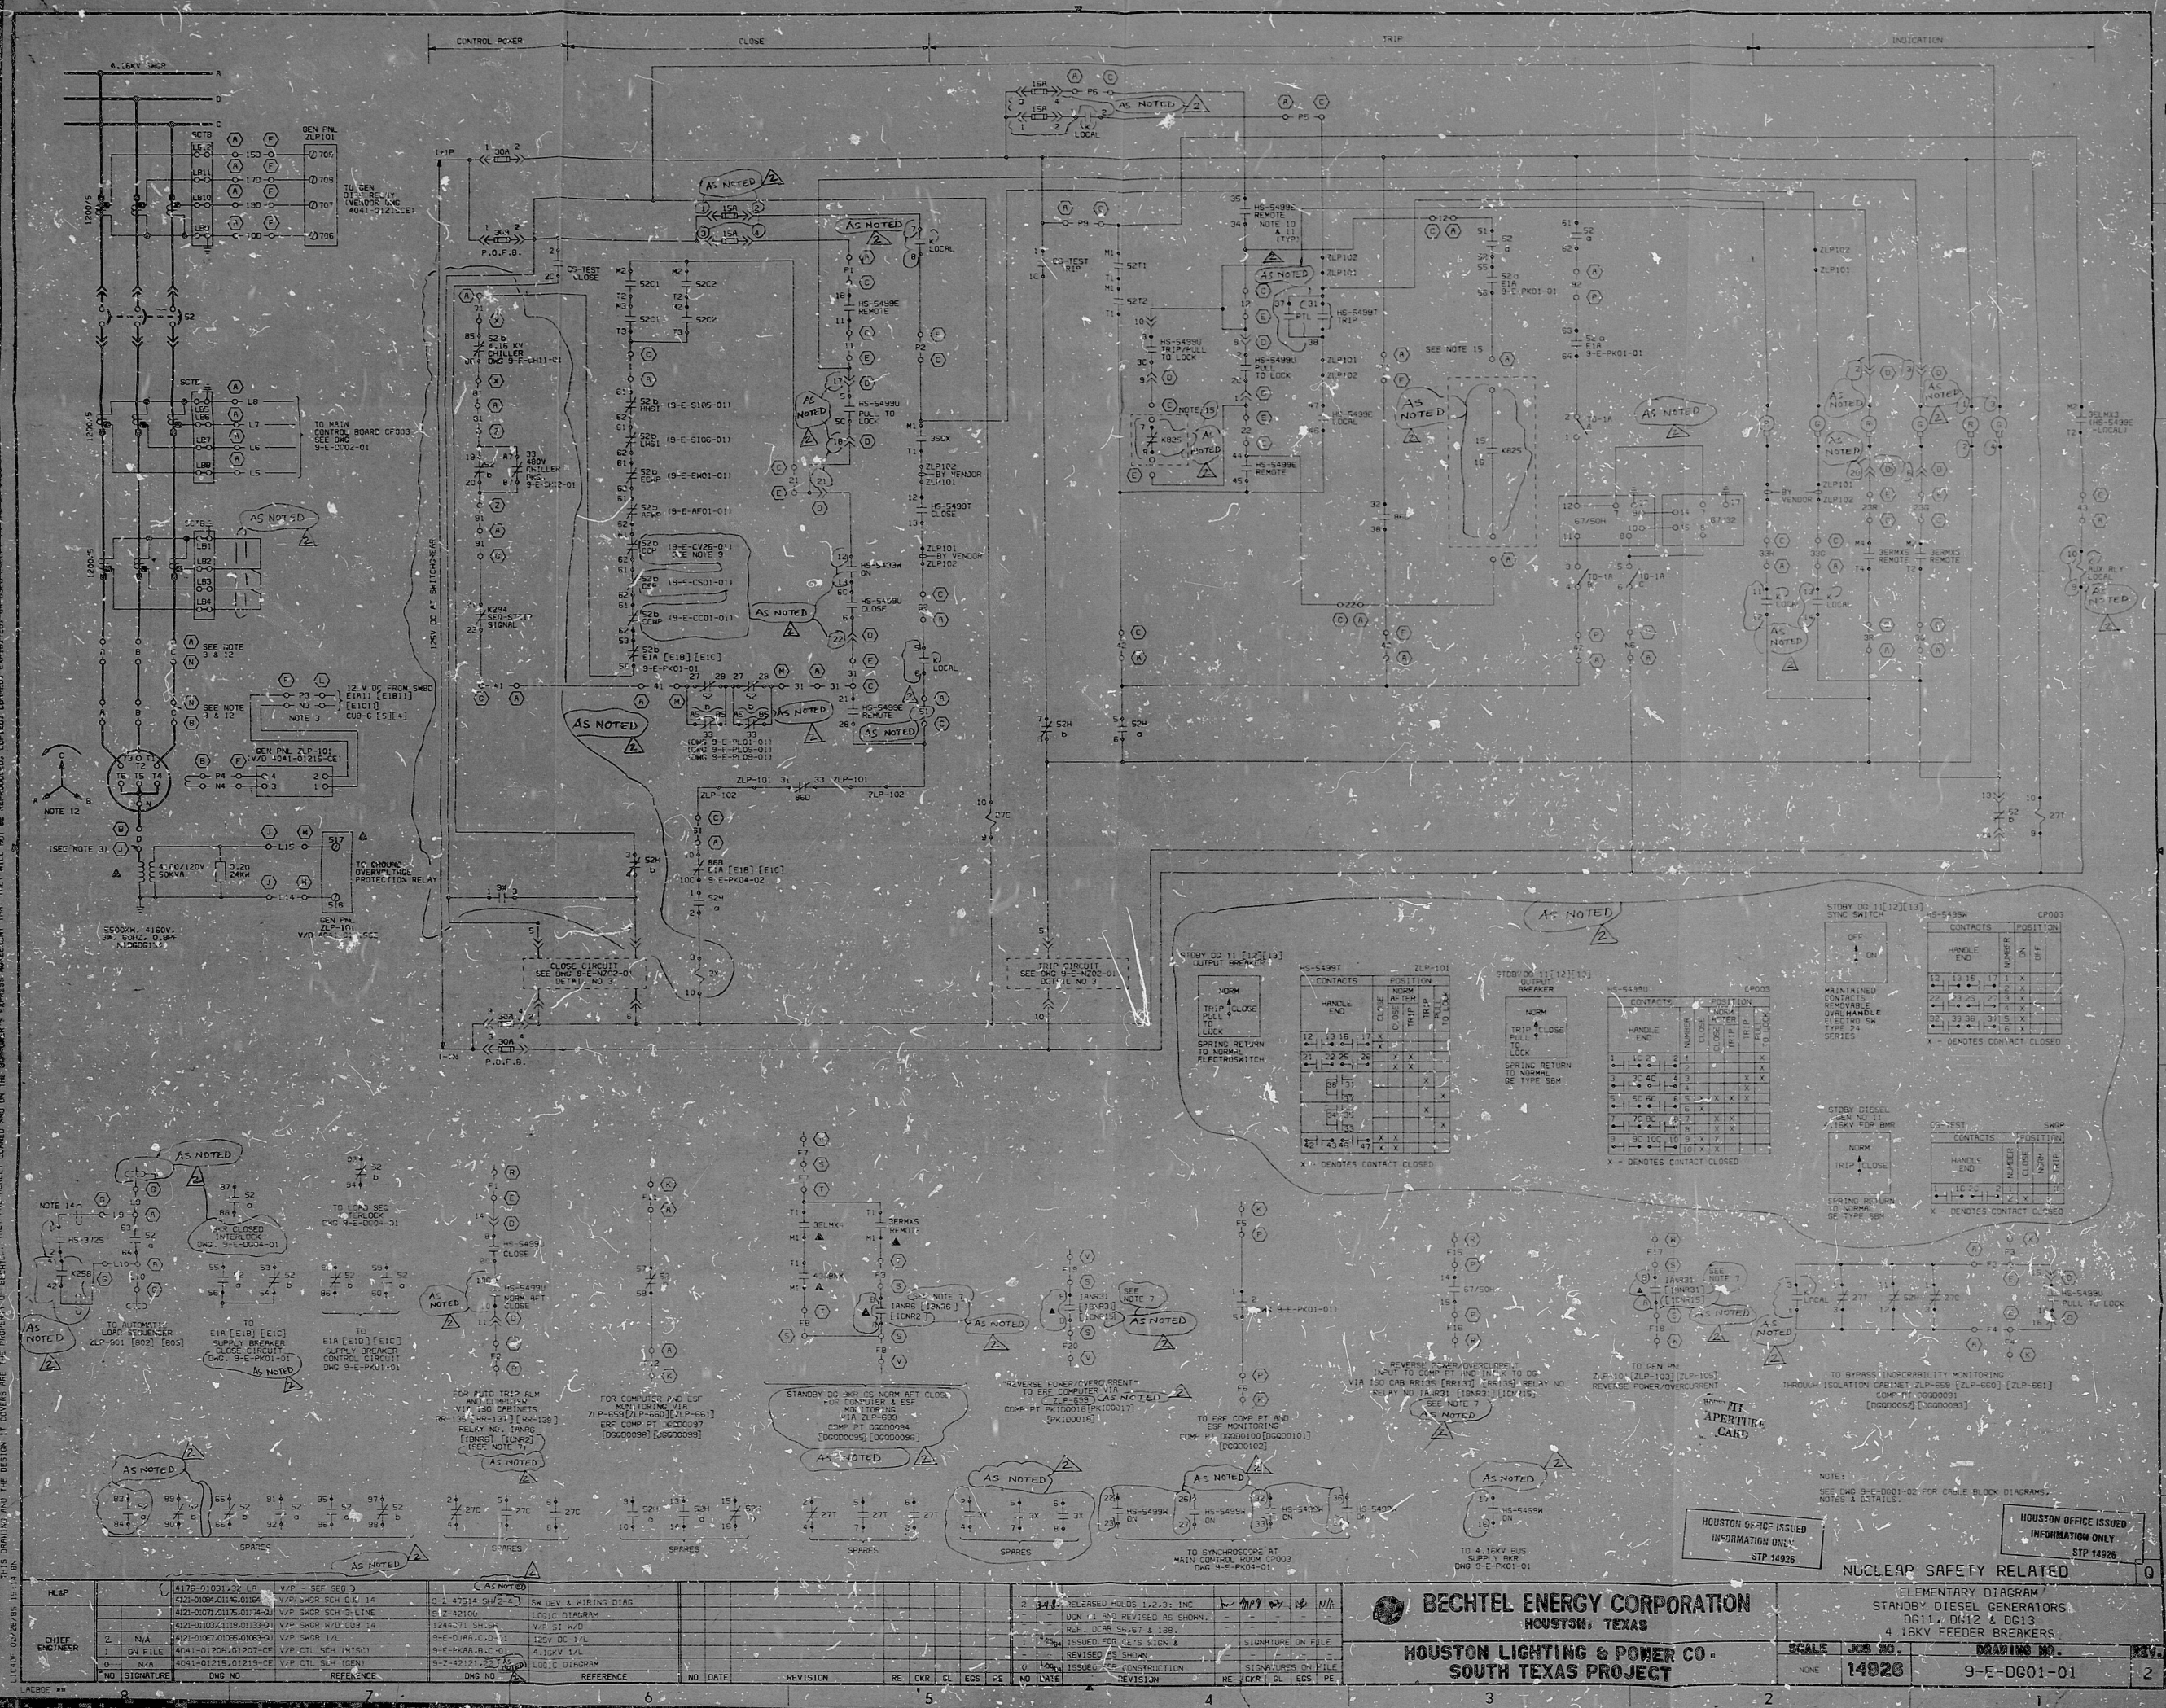

LIC40F 02/26/85 15:14 BW

HL1P

CHIEF
ENGINEER

2	N
1	ON
0	N
NO	SIGN

	4176-
	5121-01
	4121-01
	4121-01
A	5121-01
FILE	4041-
KA	4041-
SIGNATURE	

01031.32 LA
001.01146.01164
071.01175.01174
103.01119.01133
007.01065.01063
01206.01207-
01215.01219-
DNC NO

	V/P - SE
	V/P SWGR
-QU	V/P SWGR
-QI	V/P SWGR
-QU	V/P SWGR
-CE	V/P CTL
-CE	V/P CTL

REF	SEQ
SCH CXL	14
SCH 3-LINE	
W/D CUB	14
1/L	
SCH (MISO)	
SCH (GEN)	
REFERENCE	

9-2-47514 S
 9-Z-42100
 1244071 SH.5
 9-E-DJAA,C.D
 9-E-PKAA,B.C
 9-Z-42121, 2
 DWG N

2-4	SW
	LOG
	V/P
125	
4.18	
LOG	

REV & HIRING
IC DIAGRAM
SI W/D
V DC 1/L
SKV 1/L
IC DIAGRAM
REFER

DIAG

ENCE

NO DAT



E

REVISION




E	CKR	GL
---	-----	----

[illegible]

2	348
-	-
-	-
1	349
-	-
0	350
NO	DATE

RELEASED HO
OON 11 AND R
REF. DCAR 59
ISSUED FOR C
REVISED AS S
ISSUED FOR C
RE

DS 1,2,3: 1
REVISED AS S
,67 & 188.
E'S SIGN &
HOWN
ONSTRUCTION
VISION

NC
DOWN.
NE

MP9	02/	
-	-	-
-	-	-
SIGNATURE OF		
-	-	-
SIGNATURES		
CKR	GL	E

1	2	
---	---	---	---	---	---	---	---	---	----	----	-----	-----	

BECH
CUSTO
SO

TEL E
P
ON LIG
UTH T

ENERG
HOUSTON
NTING
TEXAS

Y CORP
TEXAS
& POW
PROJE

CORPORATION
 CT

TION

	SCAL
	NONE

E	JOB
	149

ELEM	
STANDBY	
DG11	
4.16KV	
NO.	

ENTARY D
DIESEL G
, DG12 &
FEEDER
9-E

DIAGRAM
GENERATOR
DG13
BREAKERS
-DG01-

RS
5
0.
-01

2

A


PDR RIDS

8505290134

