
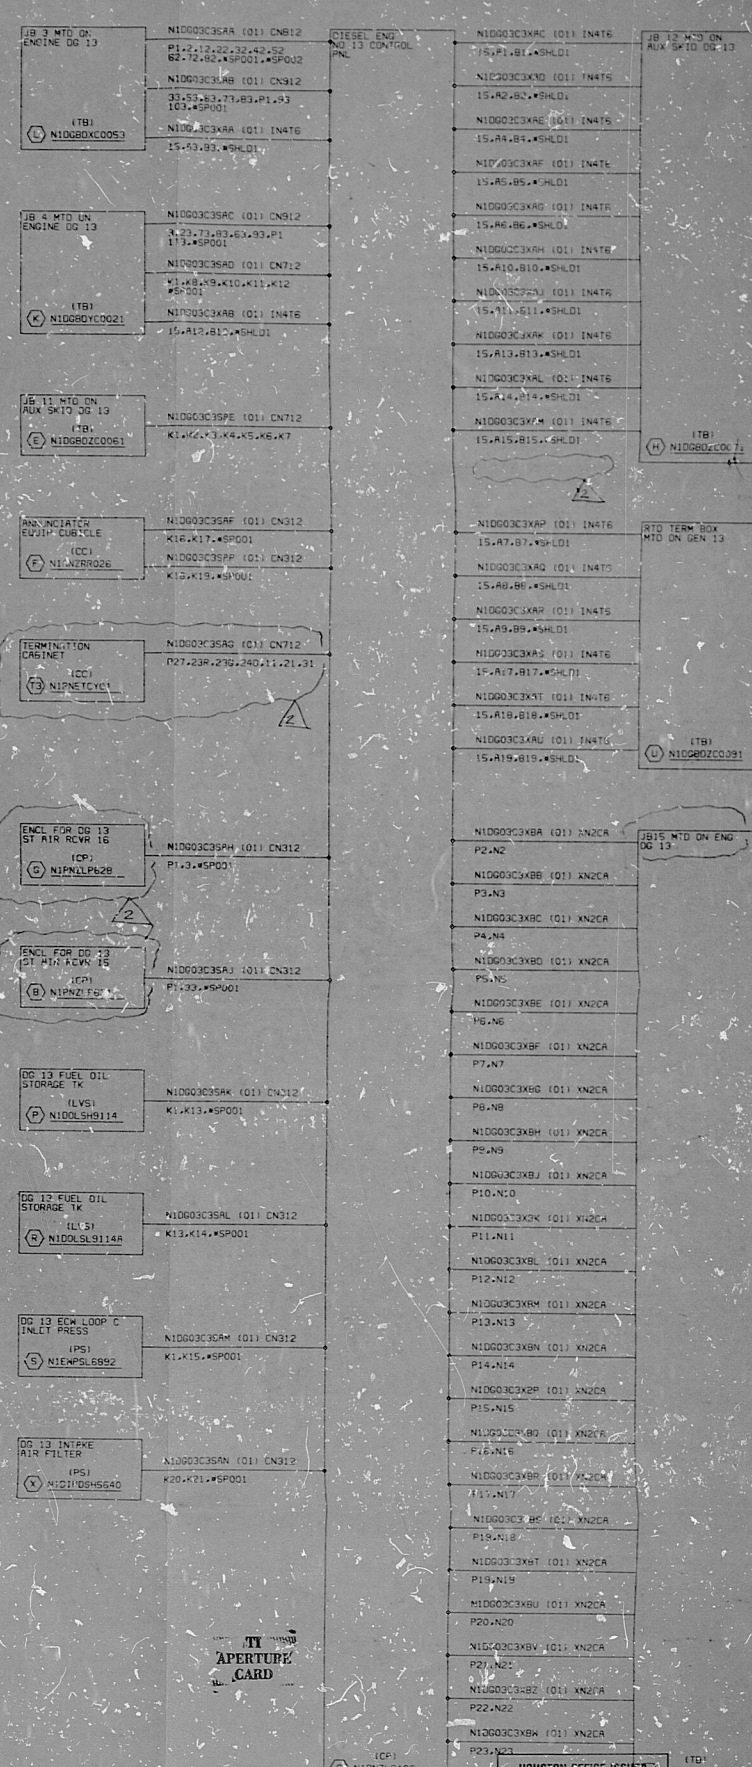
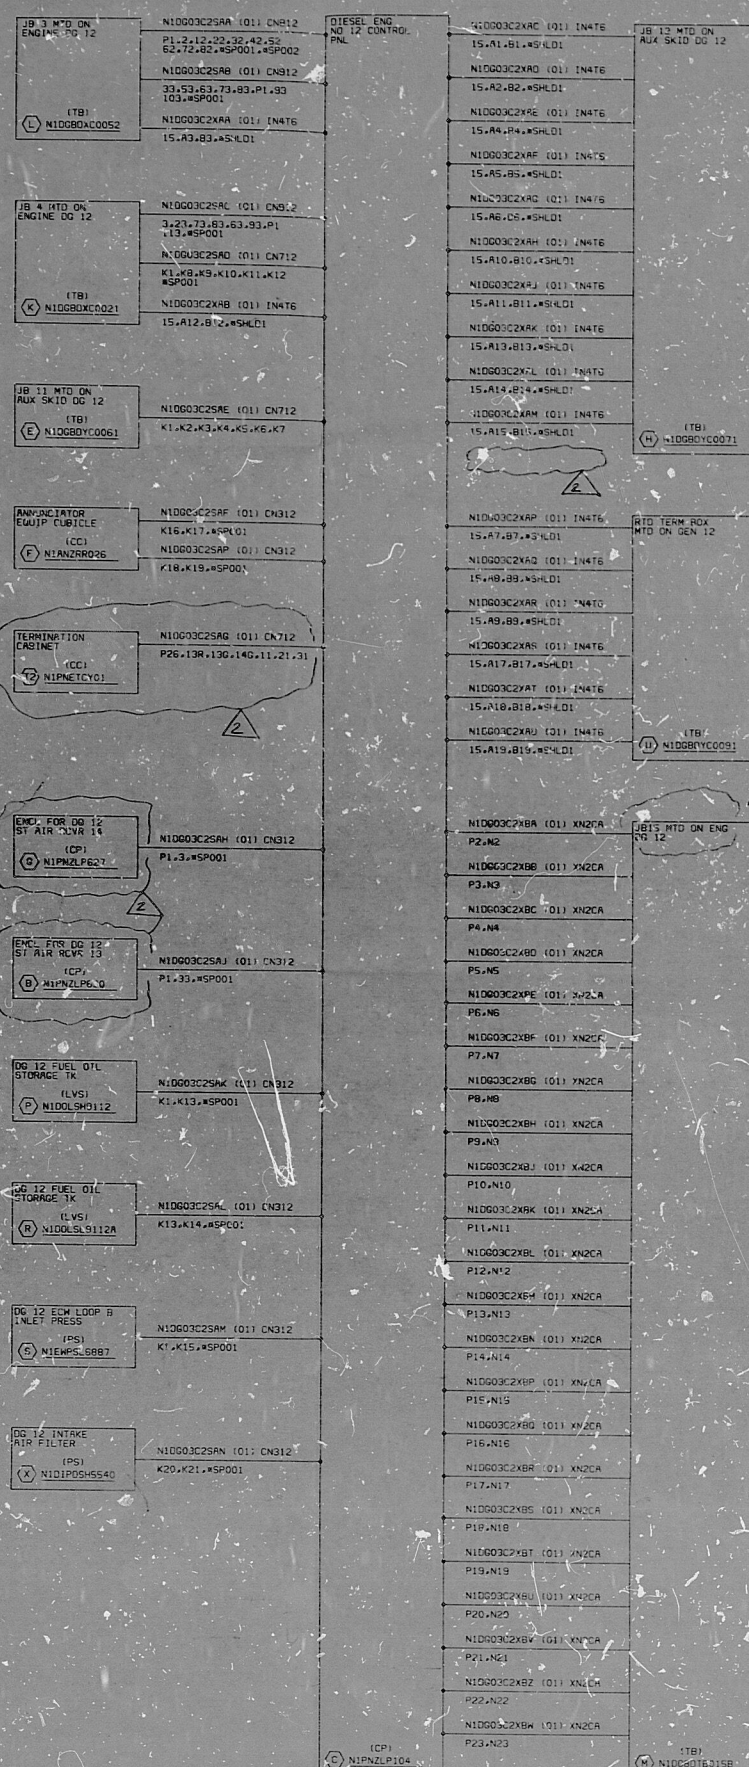


THIS DRAWING AND THE DESIGN IT COVERS ARE THE PROPERTY OF BECHTEL. THEY ARE NOT TO BE REPRODUCED, COPIED, LOANED, EXHIBITED OR USED IN ANY MANNER WITHOUT THE WRITTEN CONSENT OF BECHTEL. ANY VIOLATION OF THIS NOTICE WILL BE CONSIDERED A VIOLATION OF THE PATENT RIGHTS OF BECHTEL.

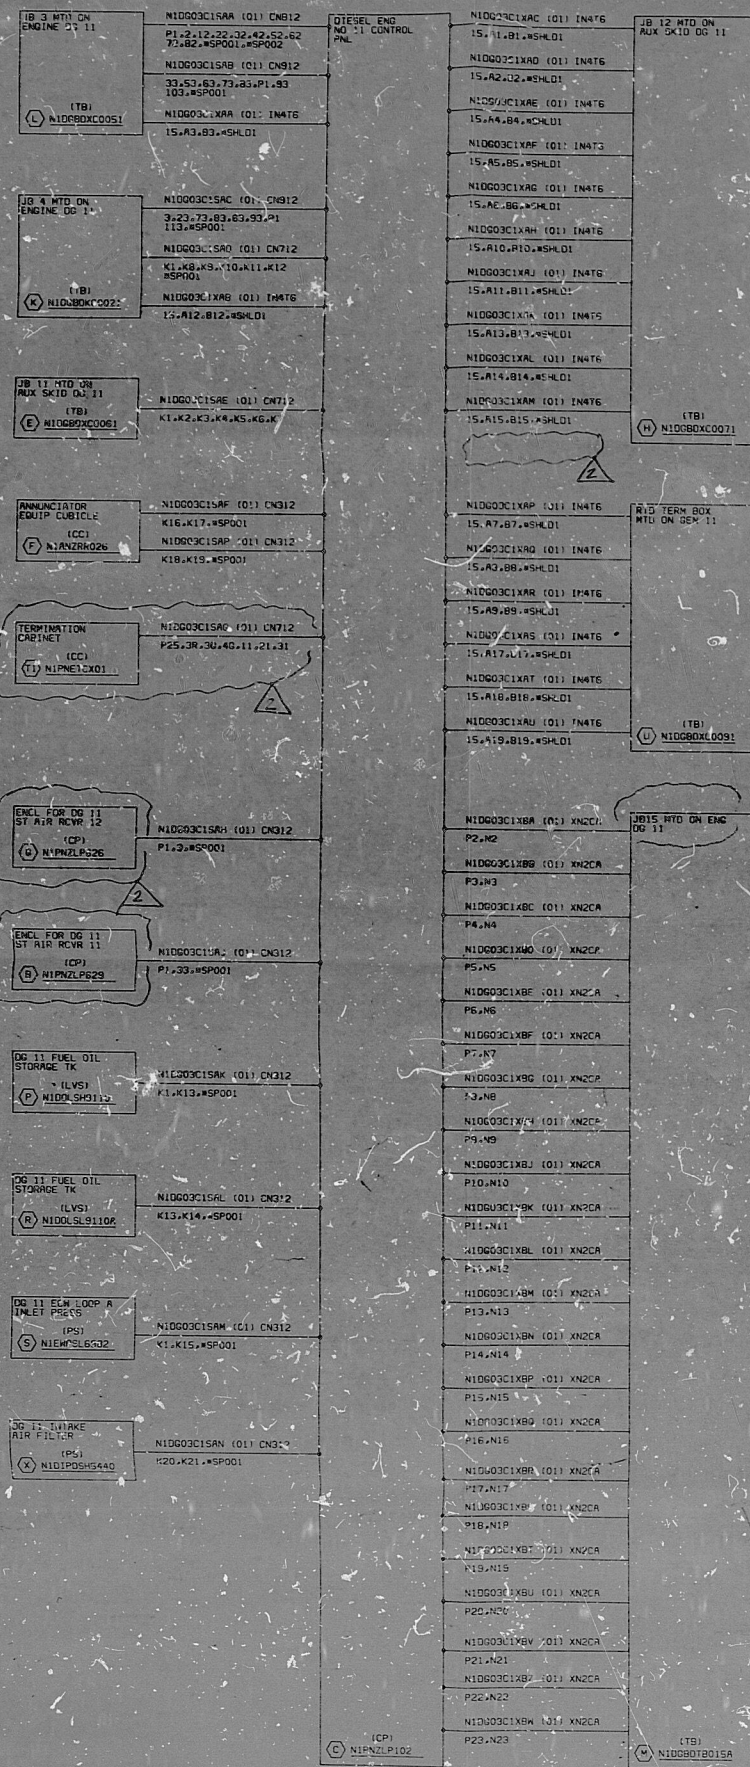

NO	DATE	REVISION	RE	CKR	DL	EDS	PE
1	12/12/81	ISSUED FOR C.E.'S SIGNATURE					
2	12/12/81	REVIEWED AND SHOWN					

BECHTEL ENERGY CORPORATION
HOUSTON, TEXAS
HOUSTON LIGHTING & POWER CO.
SOUTH TEXAS PROJECT

ELEMENTARY DIAGRAM
CONTROL, INSTRUMENTATION AND ALARM
SCALE: NONE
JOB NO: 14926
DRAWING NO: S-E-DG03-02
REV: 2

PDR RIDS

8505290171

