


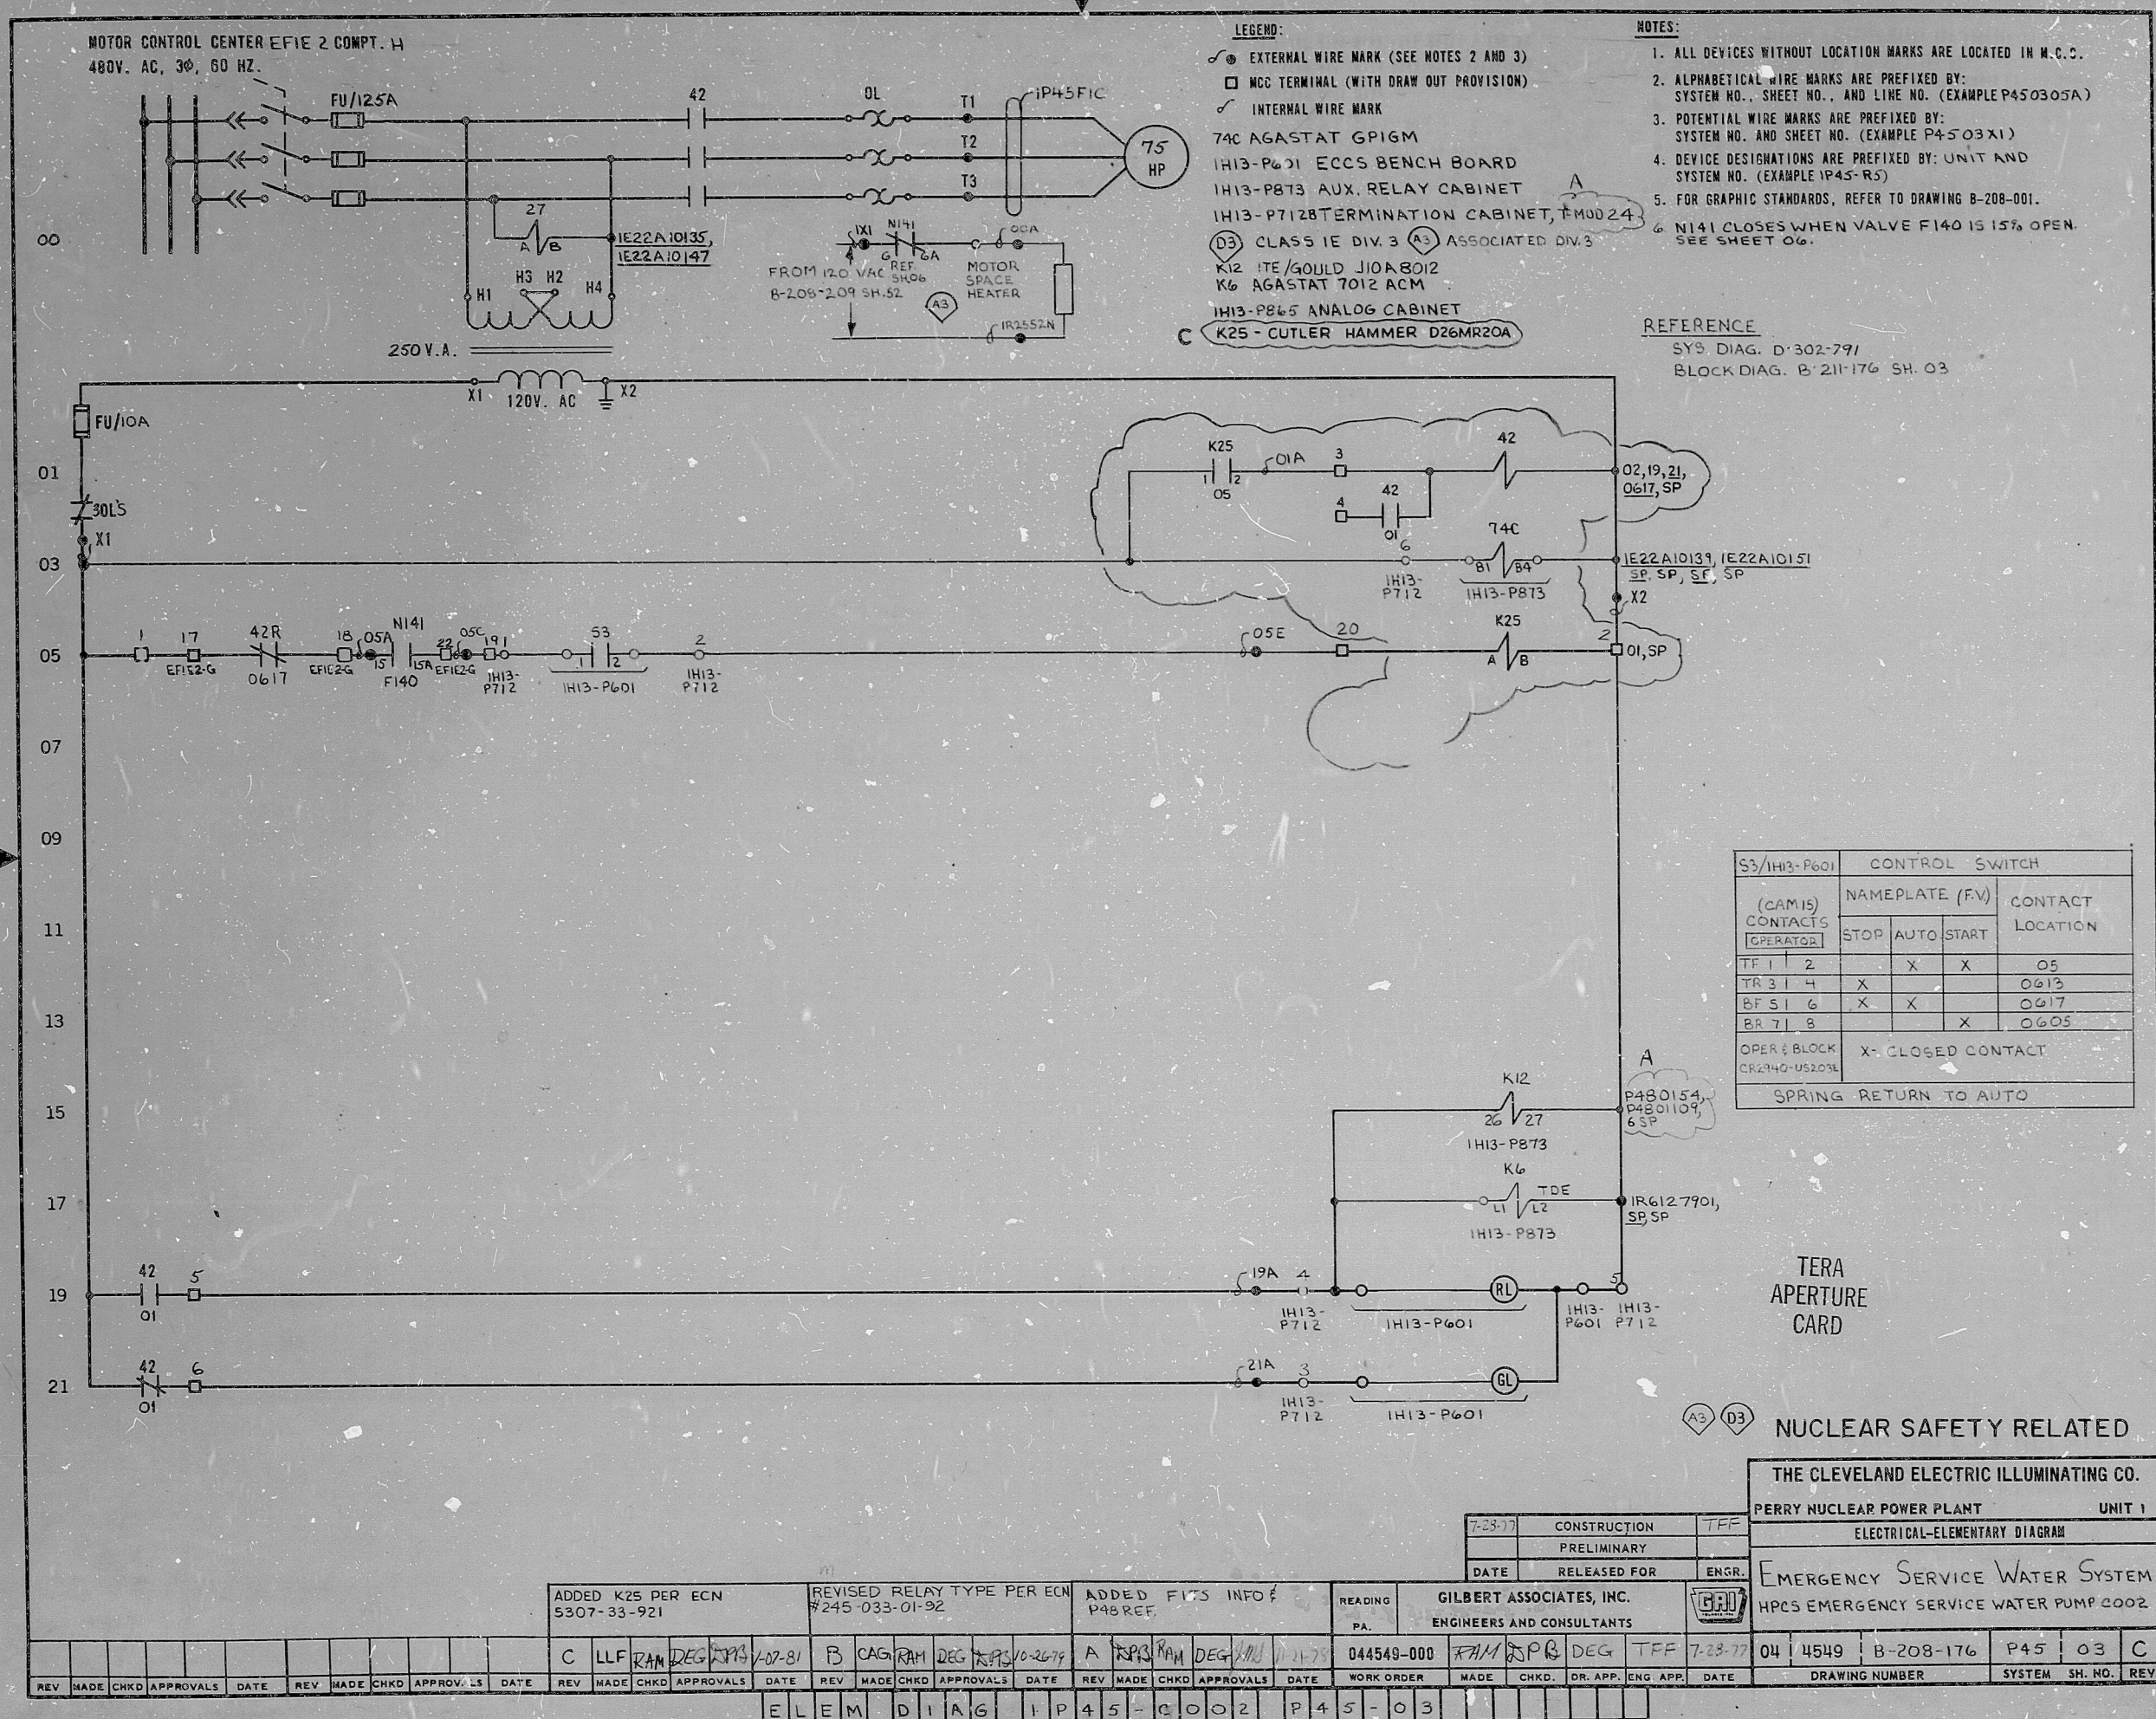

RIDS PDR

8103230884

