
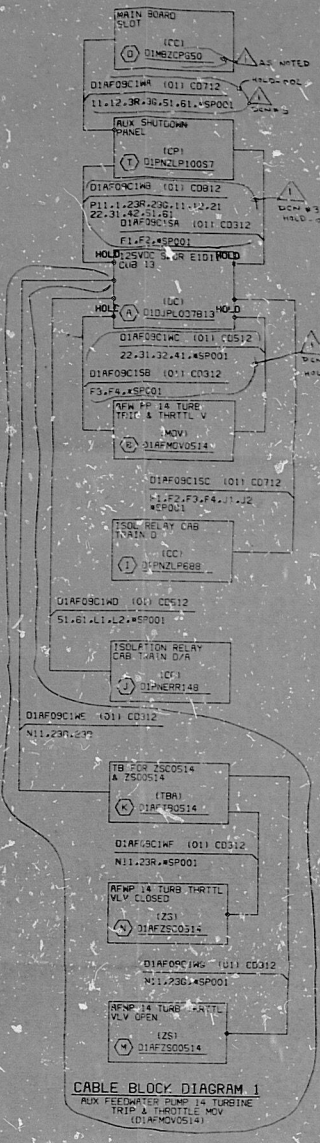


THIS DRAWING AND THE DESIGN IT CONTAINS ARE THE PROPERTY OF BECHTEL ENERGY CORPORATION. THEY ARE LOANED TO YOU BY THE BECHTEL ENERGY CORPORATION. THEY ARE NOT TO BE REPRODUCED, COPIED, LOANED, EXHIBITED, OR USED IN ANY MANNER WITHOUT THE WRITTEN CONSENT GIVEN BY THE BECHTEL ENERGY CORPORATION. ANY VIOLATION OF THIS AGREEMENT WILL BE CONSIDERED A BREACH OF CONTRACT AND WILL BE PROSECUTED TO THE FULL EXTENT OF THE LAW.

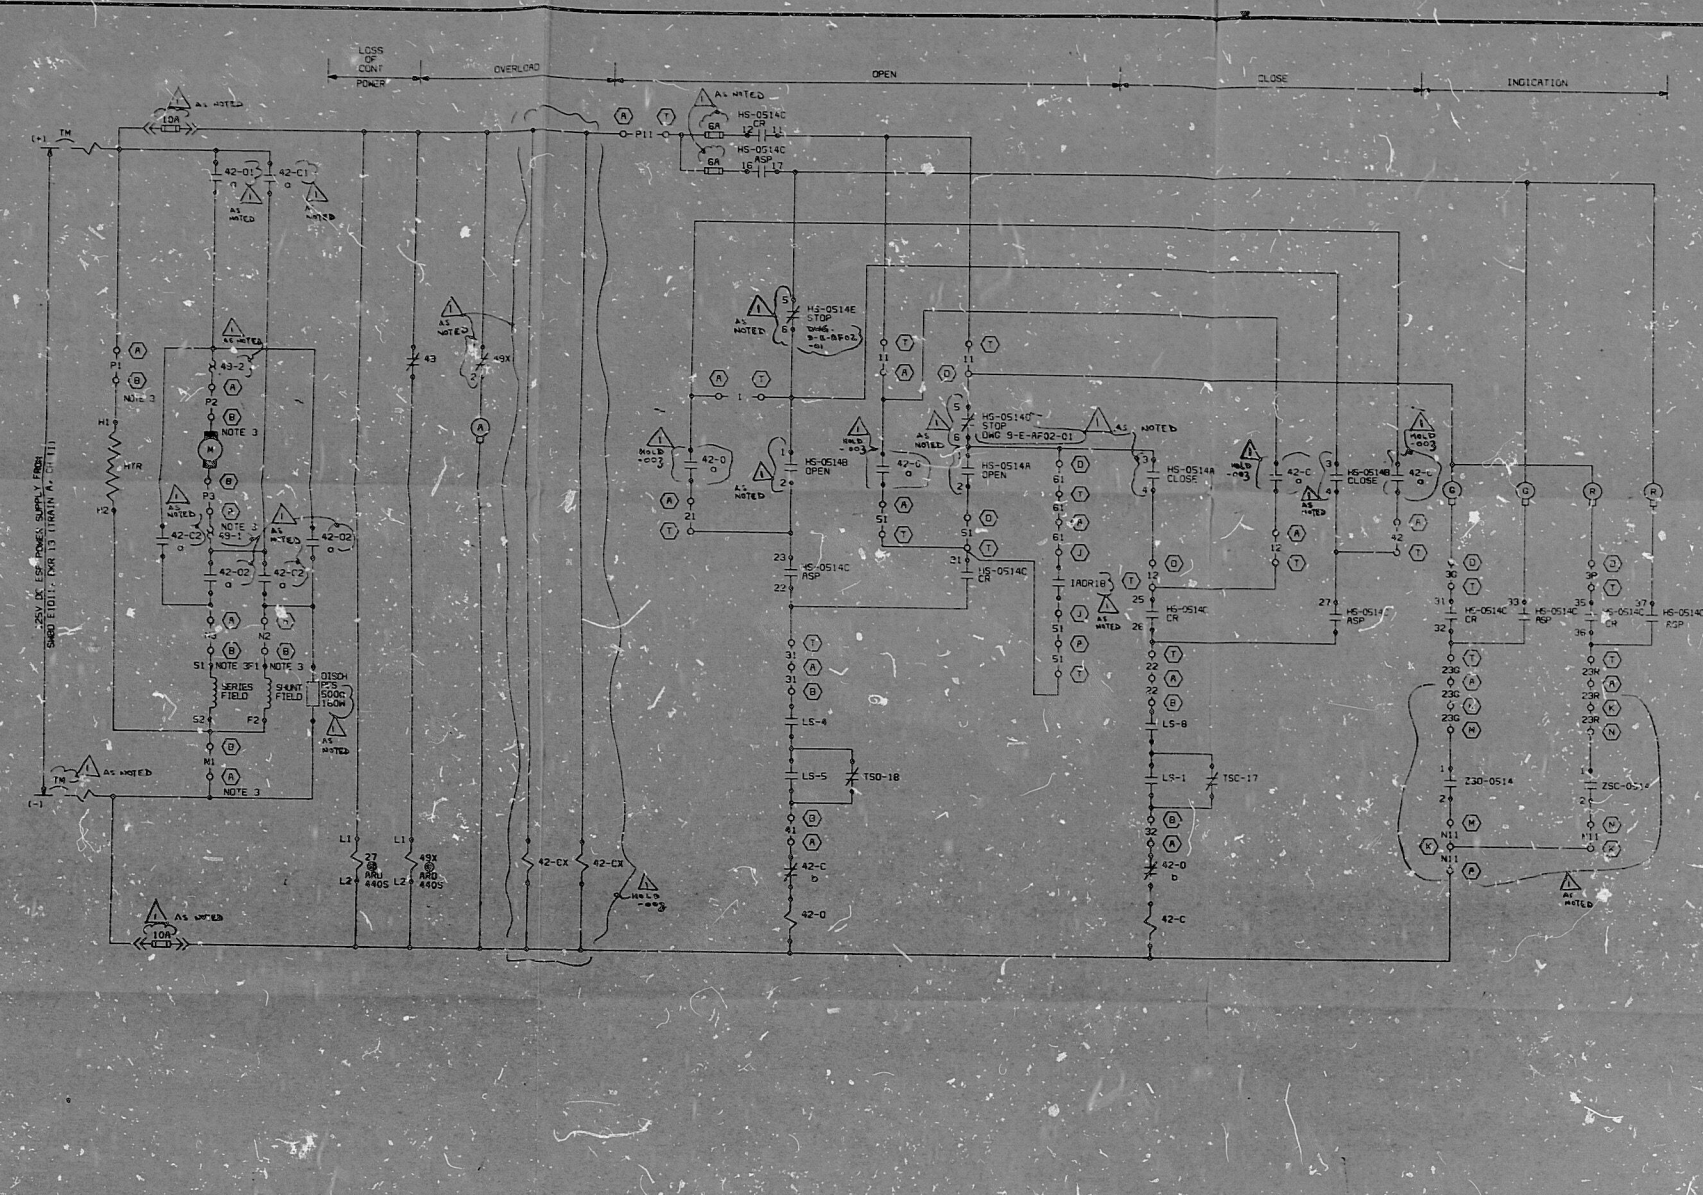

VALVE POSITION		LIMIT SWITCH CONTACT DEVELOPMENT		LIMIT SWITCH CONTACT DEVELOPMENT	
FULL OPEN		FULL OPEN		FULL OPEN	
1	2	3	4	5	6
1	2	3	4	5	6
7	8	9	10	11	12
13	14	15	16	17	18

PDR RIDS

8505300191

