




RIDS₂

8208300169

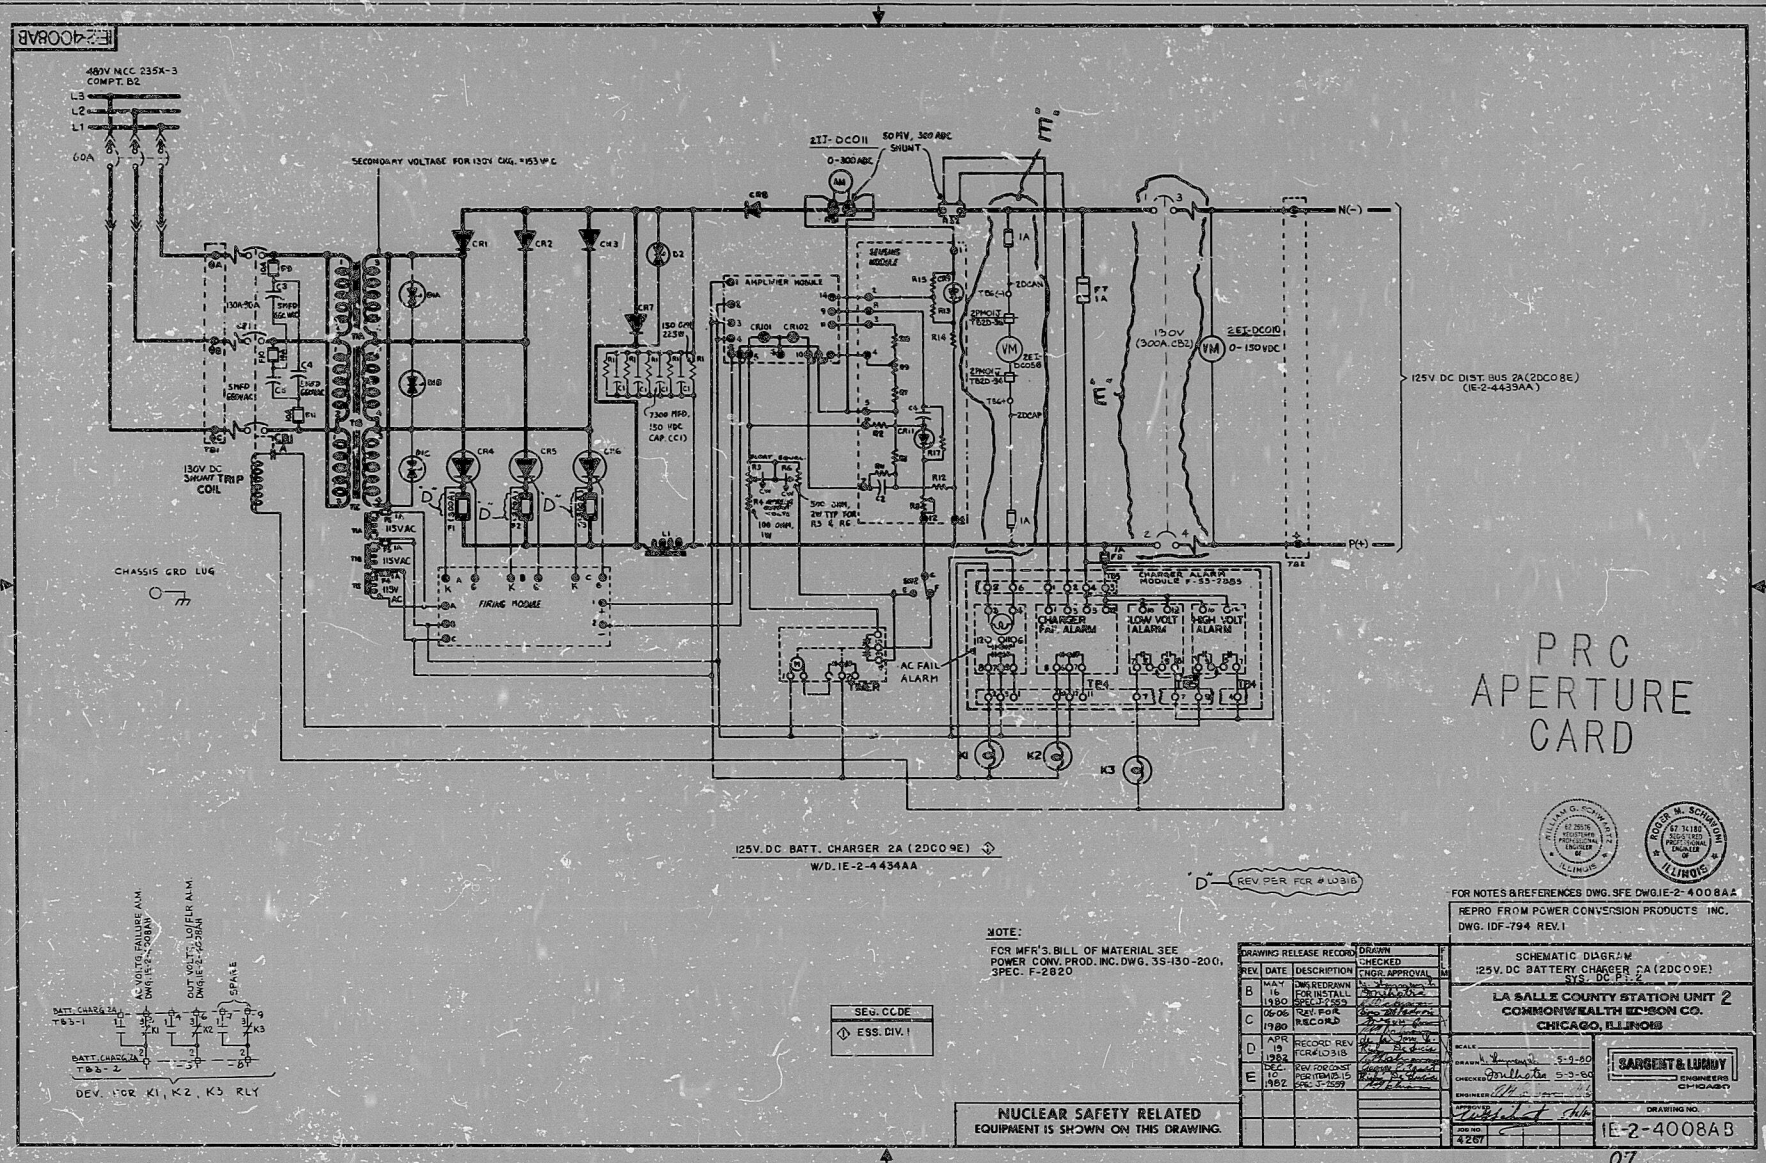