


THIS DRAWING AND THE DESIGN THEREOF ARE THE PROPERTY OF BECHTEL. THEY ARE HEREBY LOANED AND ON THE BORROWER'S EXPRESS AGREEMENT THAT THEY WILL NOT BE REPRODUCED, COPIED, LOANED, EITHER WHOLLY OR IN PART, OR BY ANY MEANS, WITHOUT THE WRITTEN PERMISSION OF BECHTEL. ANY VIOLATION OF THIS AGREEMENT WILL BE CONSIDERED A BREACH OF CONTRACT AND WILL BE SUBJECT TO THE FULL AND COMPLETE REMEDY OF BECHTEL.

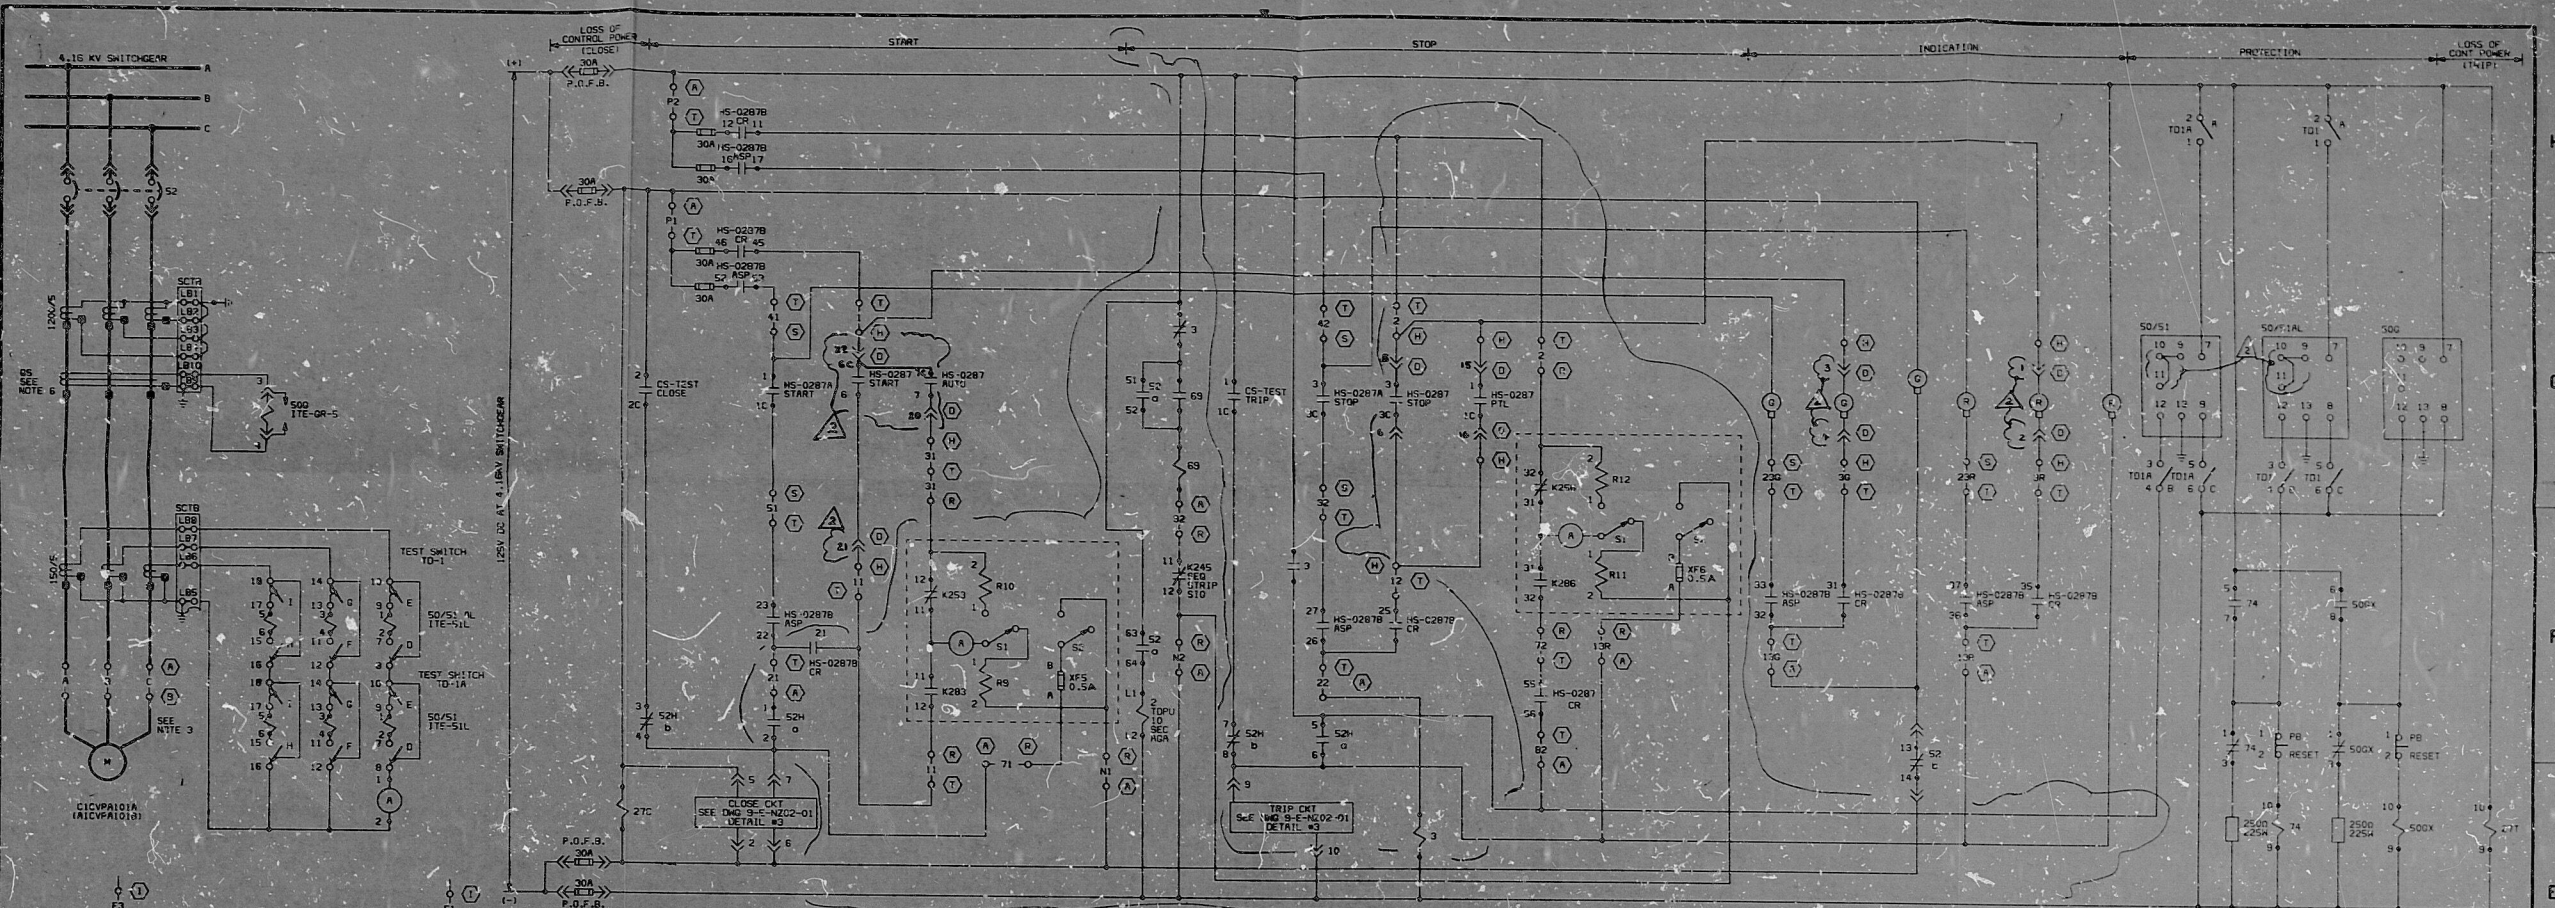

NO.	DATE	REVISION	BY	CHKD.	APP'D.	DESCRIPTION

BECHTEL ENERGY CORPORATION
HOUSTON, TEXAS

HOUSTON LIGHTING & POWER CO.
SOUTH TEXAS PROJECT



DRAWING NO: 9-E-026-01

REV: 2

NUCLEAR SAFETY RELATED
ELEMENTARY DIAGRAM
CENTRIFUGAL CHARGING PUMPS 1A & 1B
(PA101A & PA101B)

HOUSTON OFFICE ISSUED
INFORMATION ONLY
STY 14926

PDR RIDS

8505300314

