


| CONTRACTS     |        |        |       | POSITION |       |      |                 |
|---------------|--------|--------|-------|----------|-------|------|-----------------|
| HANDLE<br>END |        | NUMBER | START | PERC     | SZ OF | STOP | PAID TO<br>TOLK |
| 1             | 1C 2C  | 2      | 1     |          |       |      | X               |
| 2             | 2C 3C  | 3      | 2     |          |       |      | X               |
| 3             | 3C 4C  | 4      | 3     |          |       |      | X               |
| 4             | 4C 5C  | 5      | 4     |          |       |      | X               |
| 5             | 5C 6C  | 6      | 5     | X        | X     | X    | X               |
| 6             | 6C 7C  | 7      | 6     | X        | X     | X    | X               |
| 7             | 7C 8C  | 8      | 7     | X        | X     | X    | X               |
| 8             | 8C 9C  | 9      | 8     | X        | X     | X    | X               |
| 9             | 9C 10C | 10     | 9     | X        | X     | X    | X               |
|               |        | 10     | 10    | X        | X     | X    | X               |

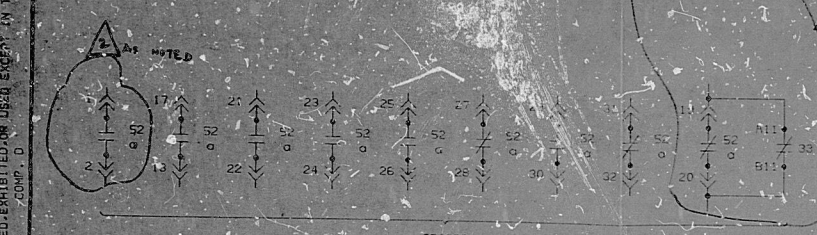

2. AS NOTED

NOTES:

1. FOR LEGEND AND SYMBOLS REFER TO DRAWINGS NO. 9-E-NZ01-01 & 9-E-NZ01-02.
2. C. DENOTED LOCATION NUMBER, FOR COMPLETE LOCATION NUMBER REFER TO DRAWING NO. 9-E-NZ01-02.
5. THIS DRAWING SUPERSEDES BAR DRAWING NO. 9-871-1-E-4575.

TH APERTURE CARD

[illegible]

**BECHTEL ENERGY CORPORATION**  
HOUSTON, TEXAS

HOUSTON LIGHTING & POWER CO  
SOUTH TEXAS PROJECT

LEMENTARY DIAGRAM  
REACTOR COOLANT PURIFICATION PUMP  
RA104A

|       |        |             |    |
|-------|--------|-------------|----|
| SCALE | JOB NO | DRAWING NO. | RE |
| NONE  | 14926  | 9-E-CV01-01 | 2  |

EK


HOUSTON OFFICE ISSUED  
INFORMATION ONLY  
STP 14926

| 01/20/85 | 4:10:08 | P3163 | DSK0 | DWG SIZE | X*                                | 33.398 | Y* | 79.998 | LW | OFF |
|----------|---------|-------|------|----------|-----------------------------------|--------|----|--------|----|-----|
| SCIPAC   | X*      | 0.957 | Y*   | 0.959    | CAUTG SCALE/TOTAL VECTORS = 19801 |        |    |        |    |     |



PDR RIDS

8505300451

