


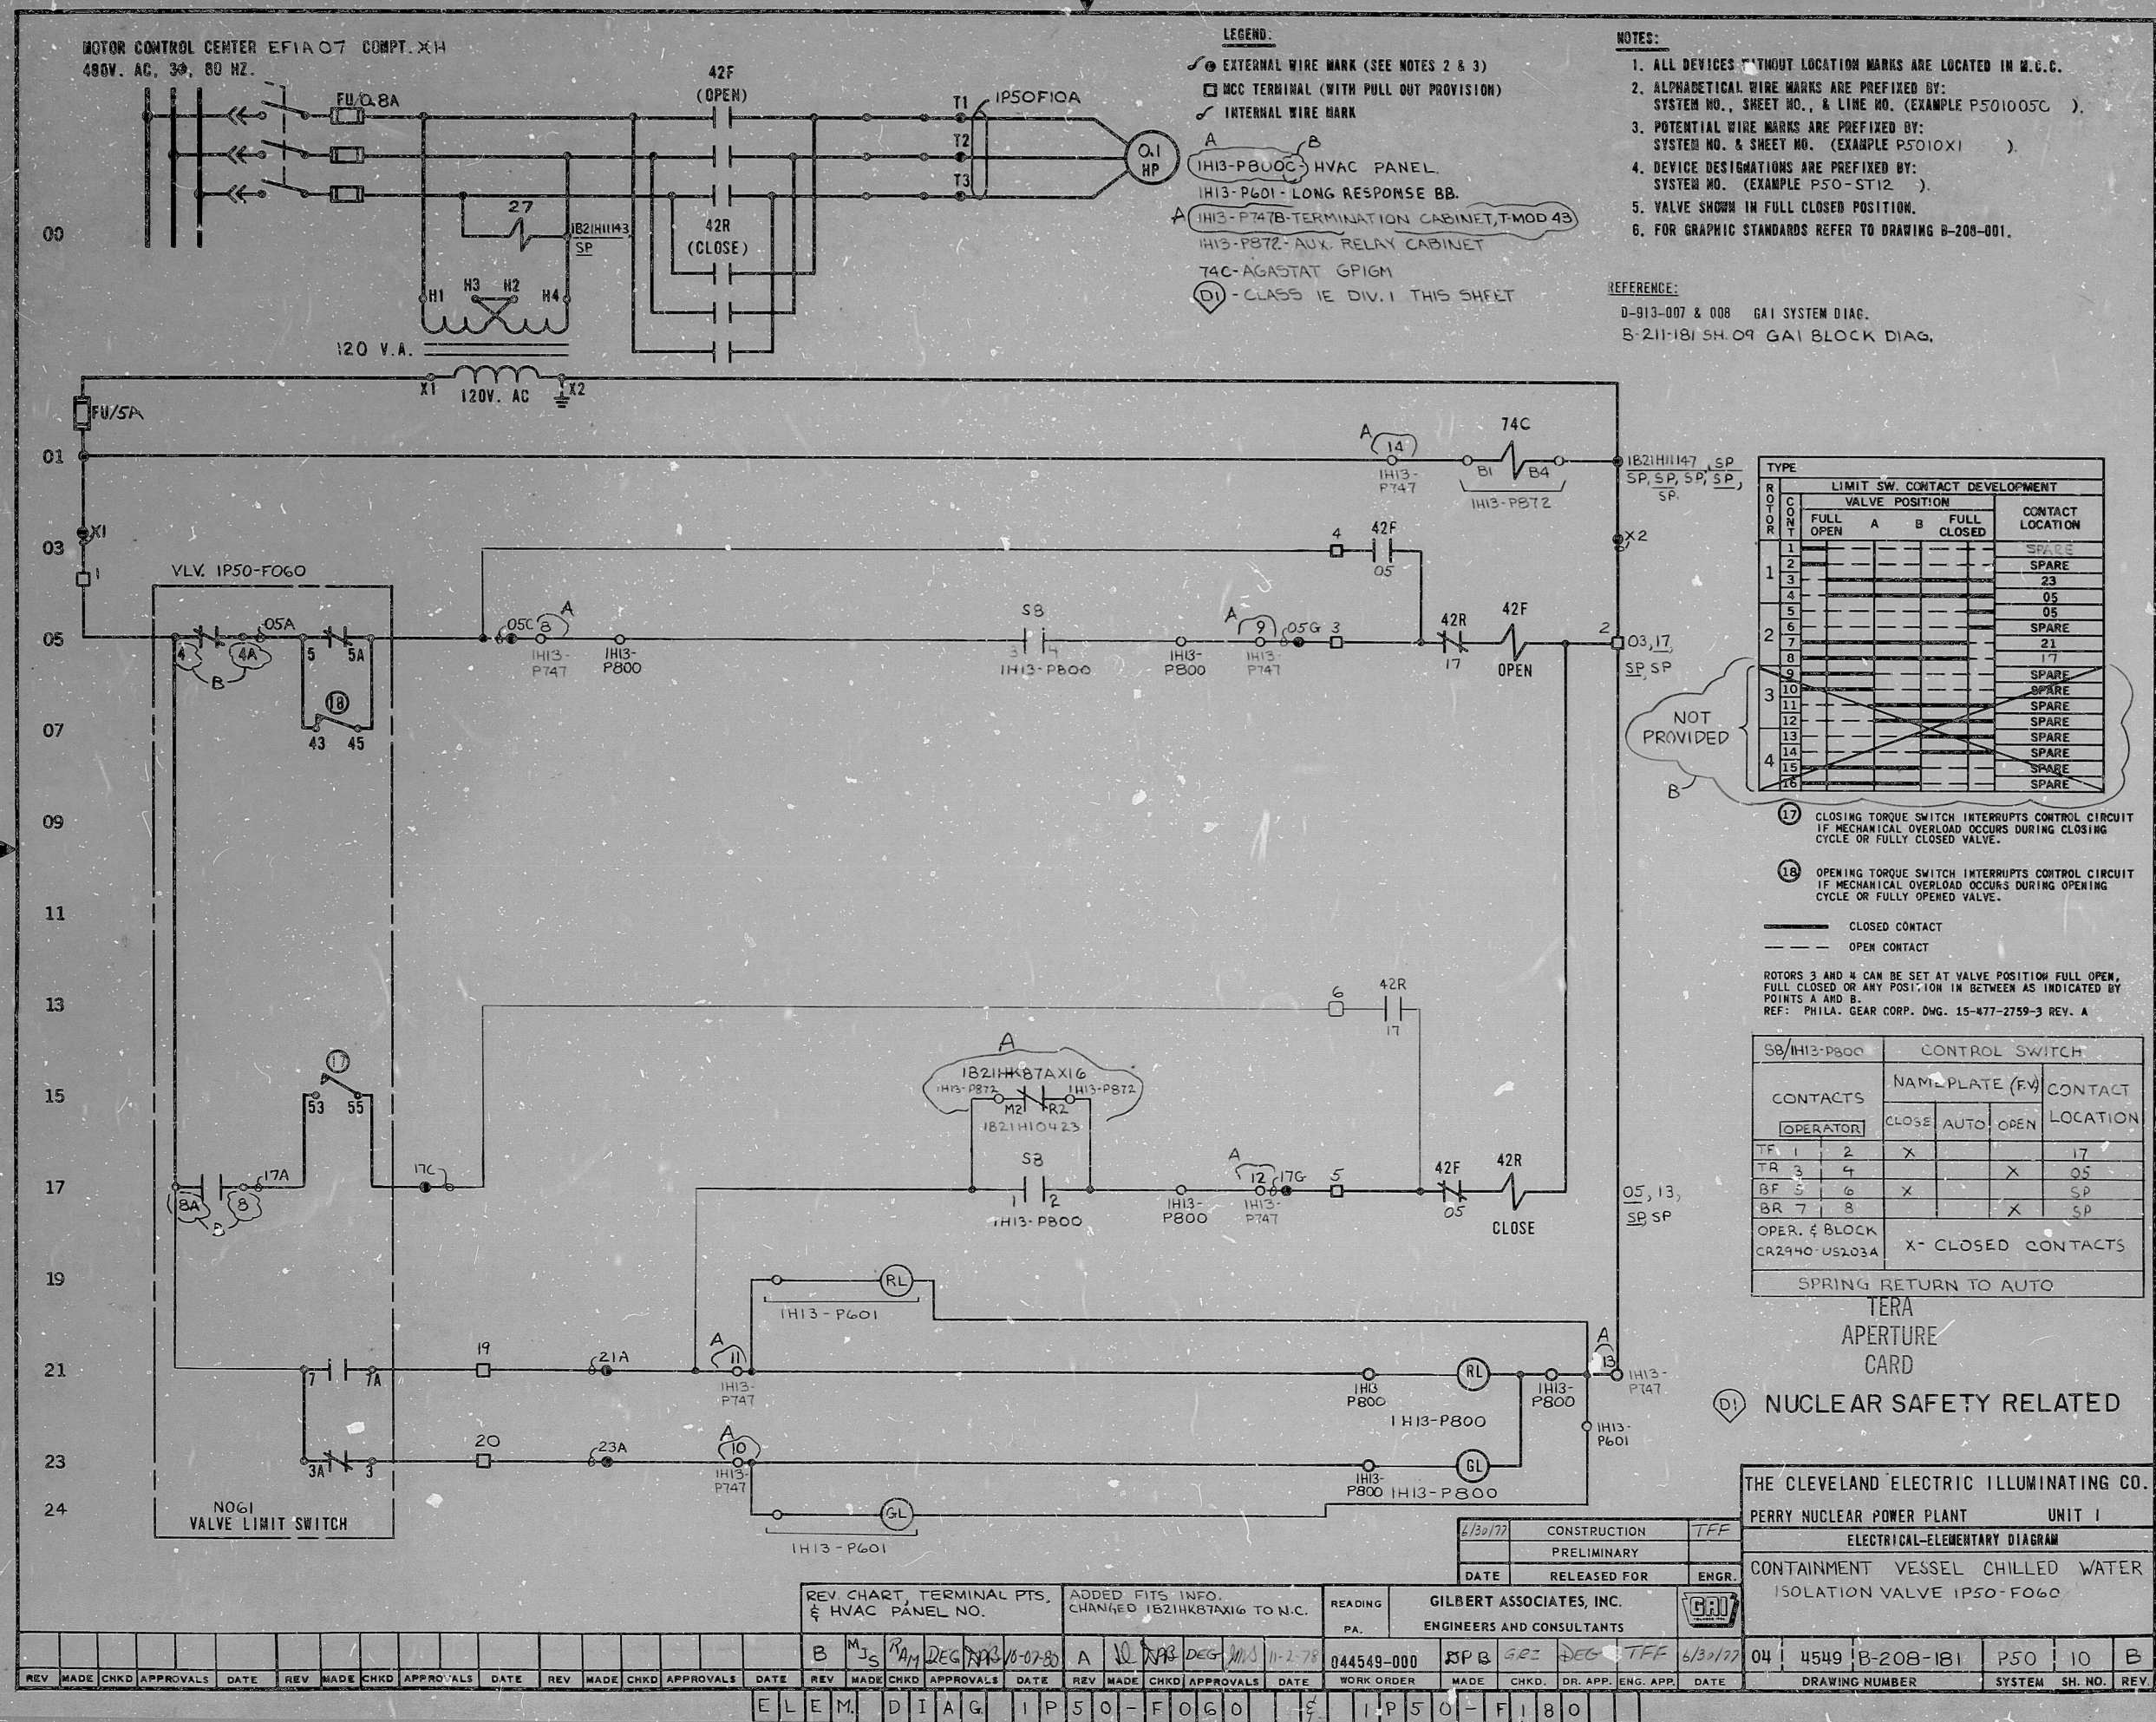



PIDS PDR

8103231034

