


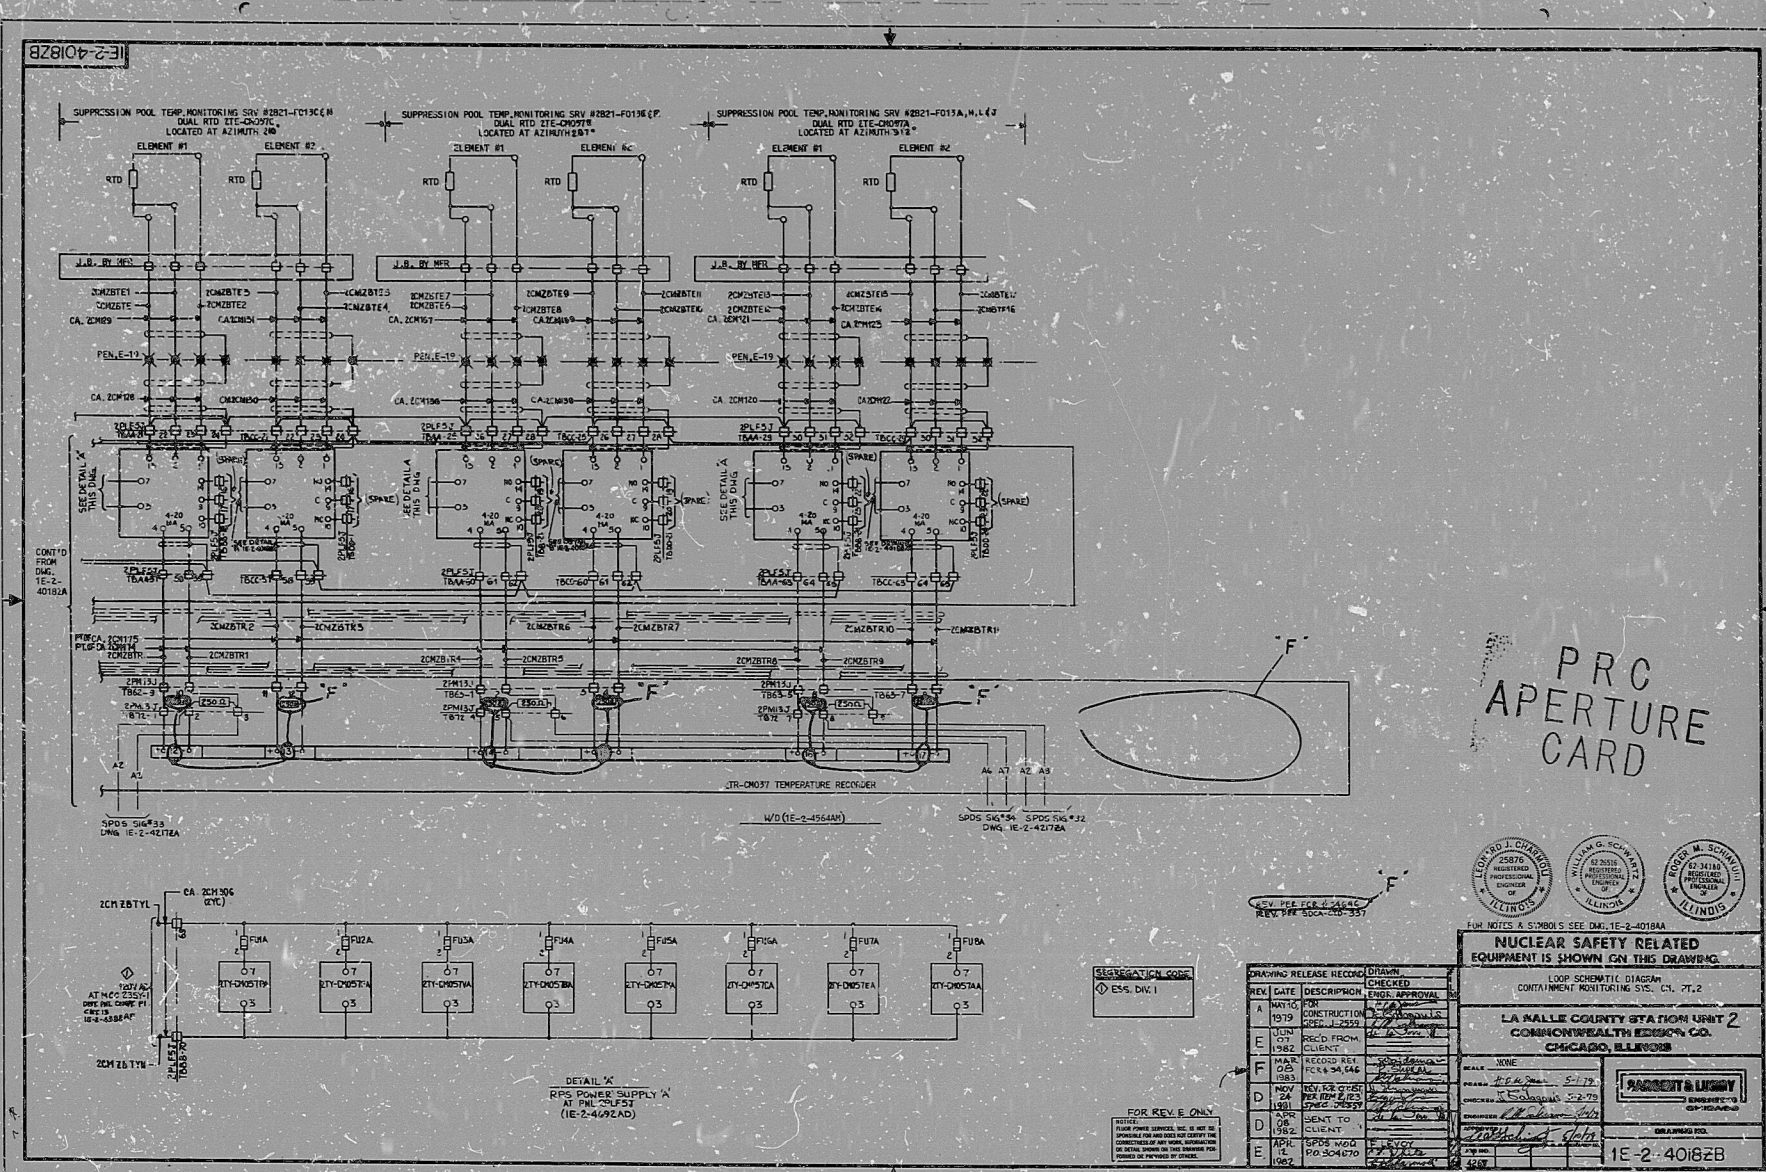



RIDS

8308300256

