




RIDS

8398300270

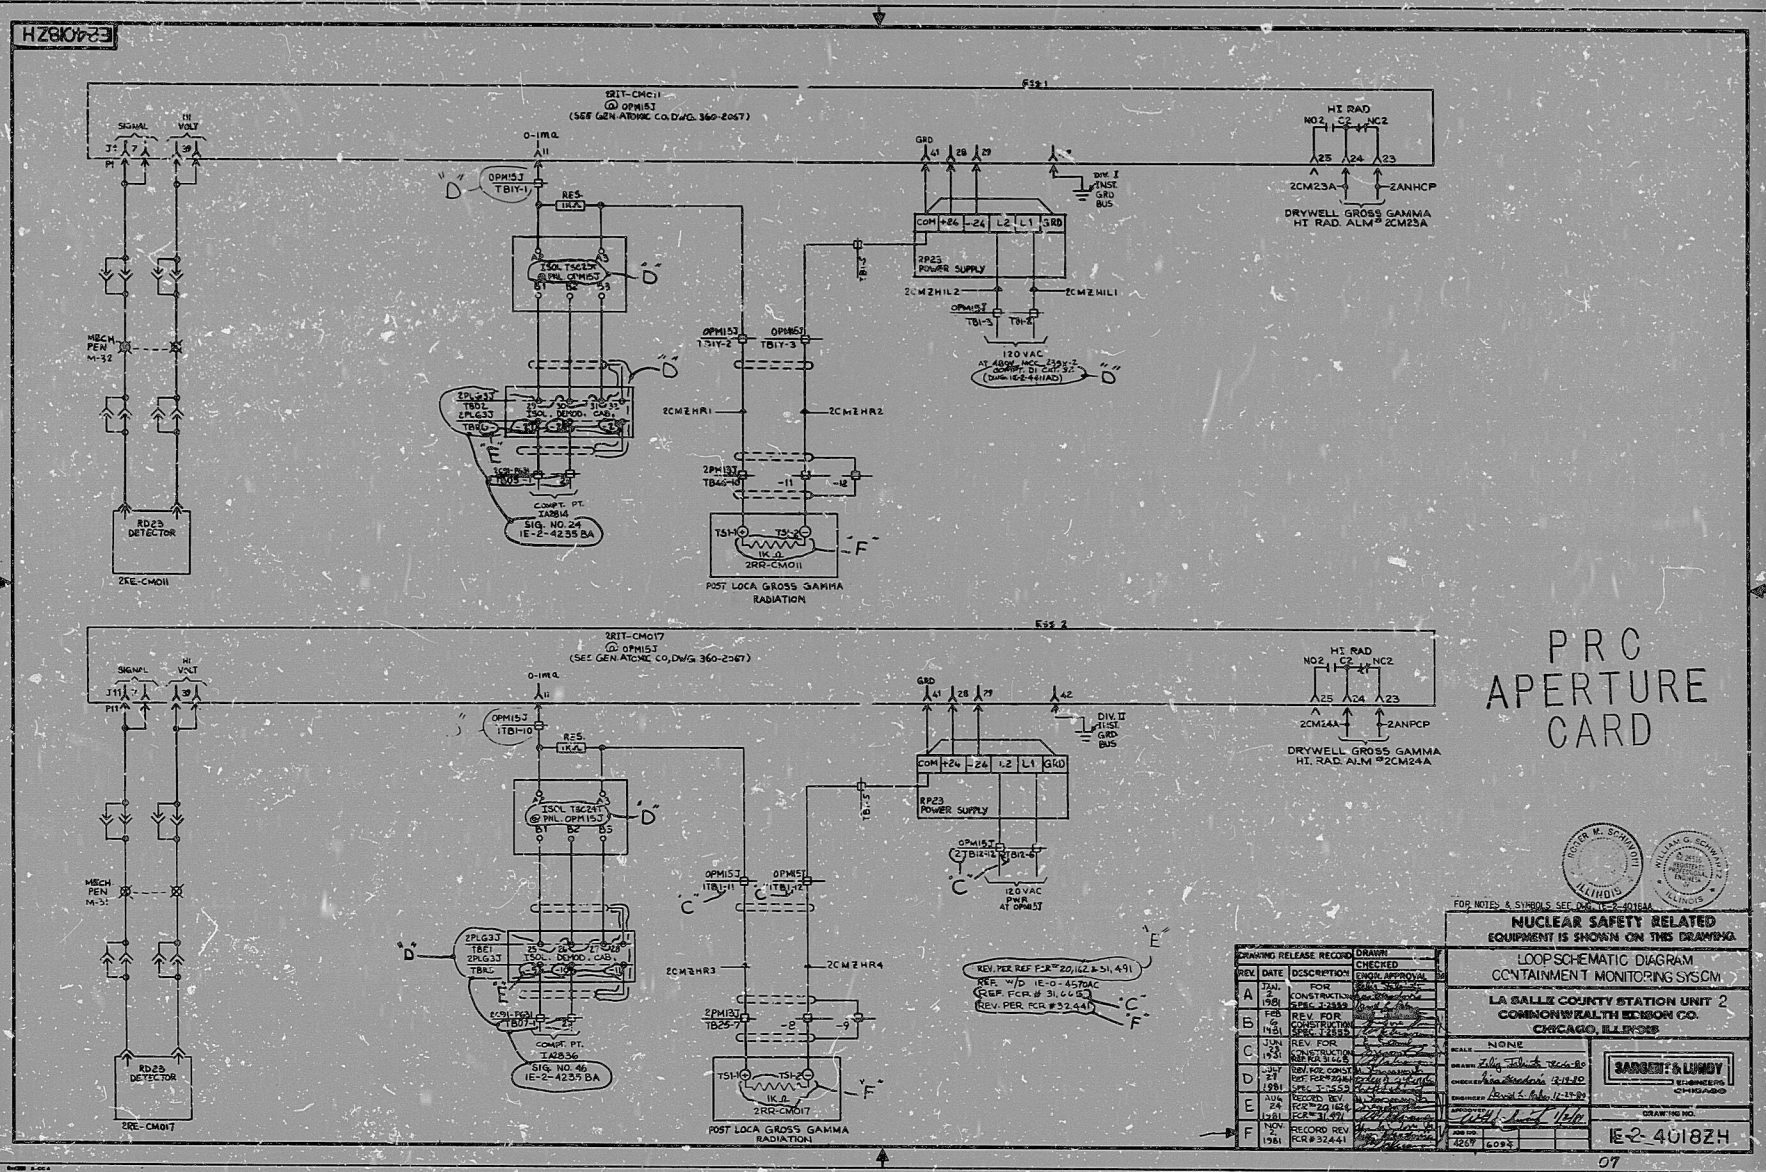