


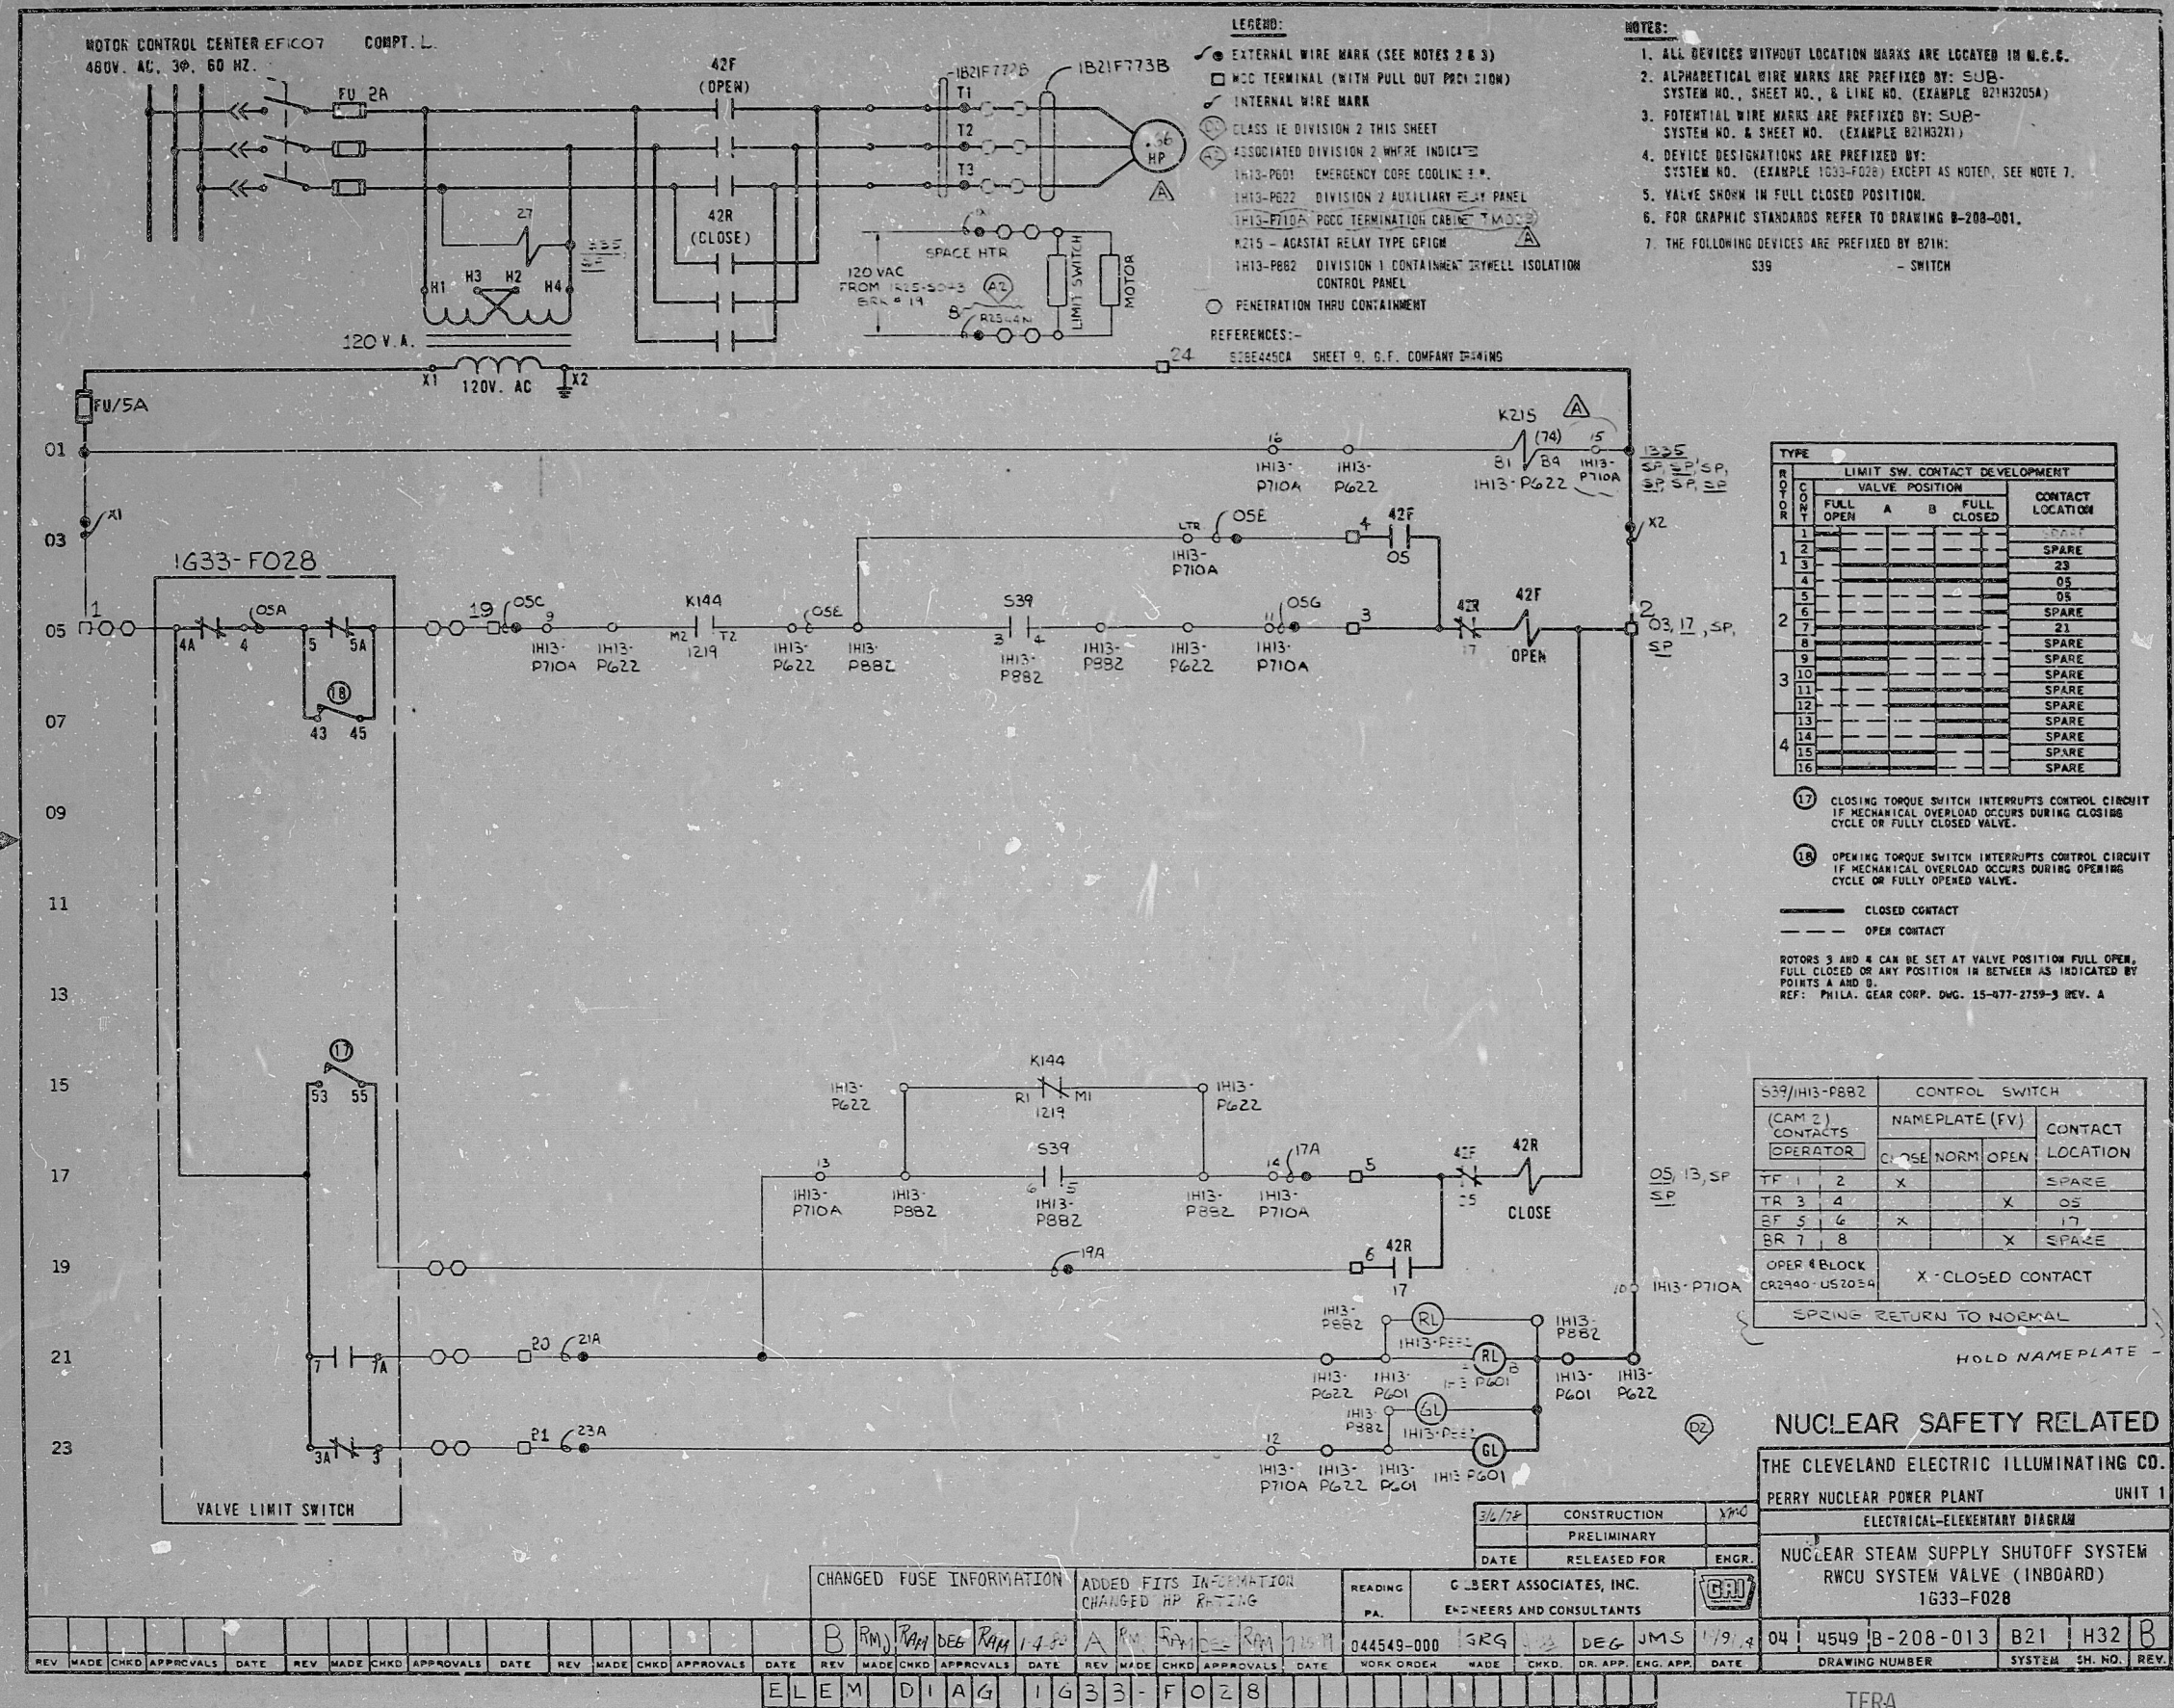

RIDS-RDR

8103240086

