




RIDS

8206210328

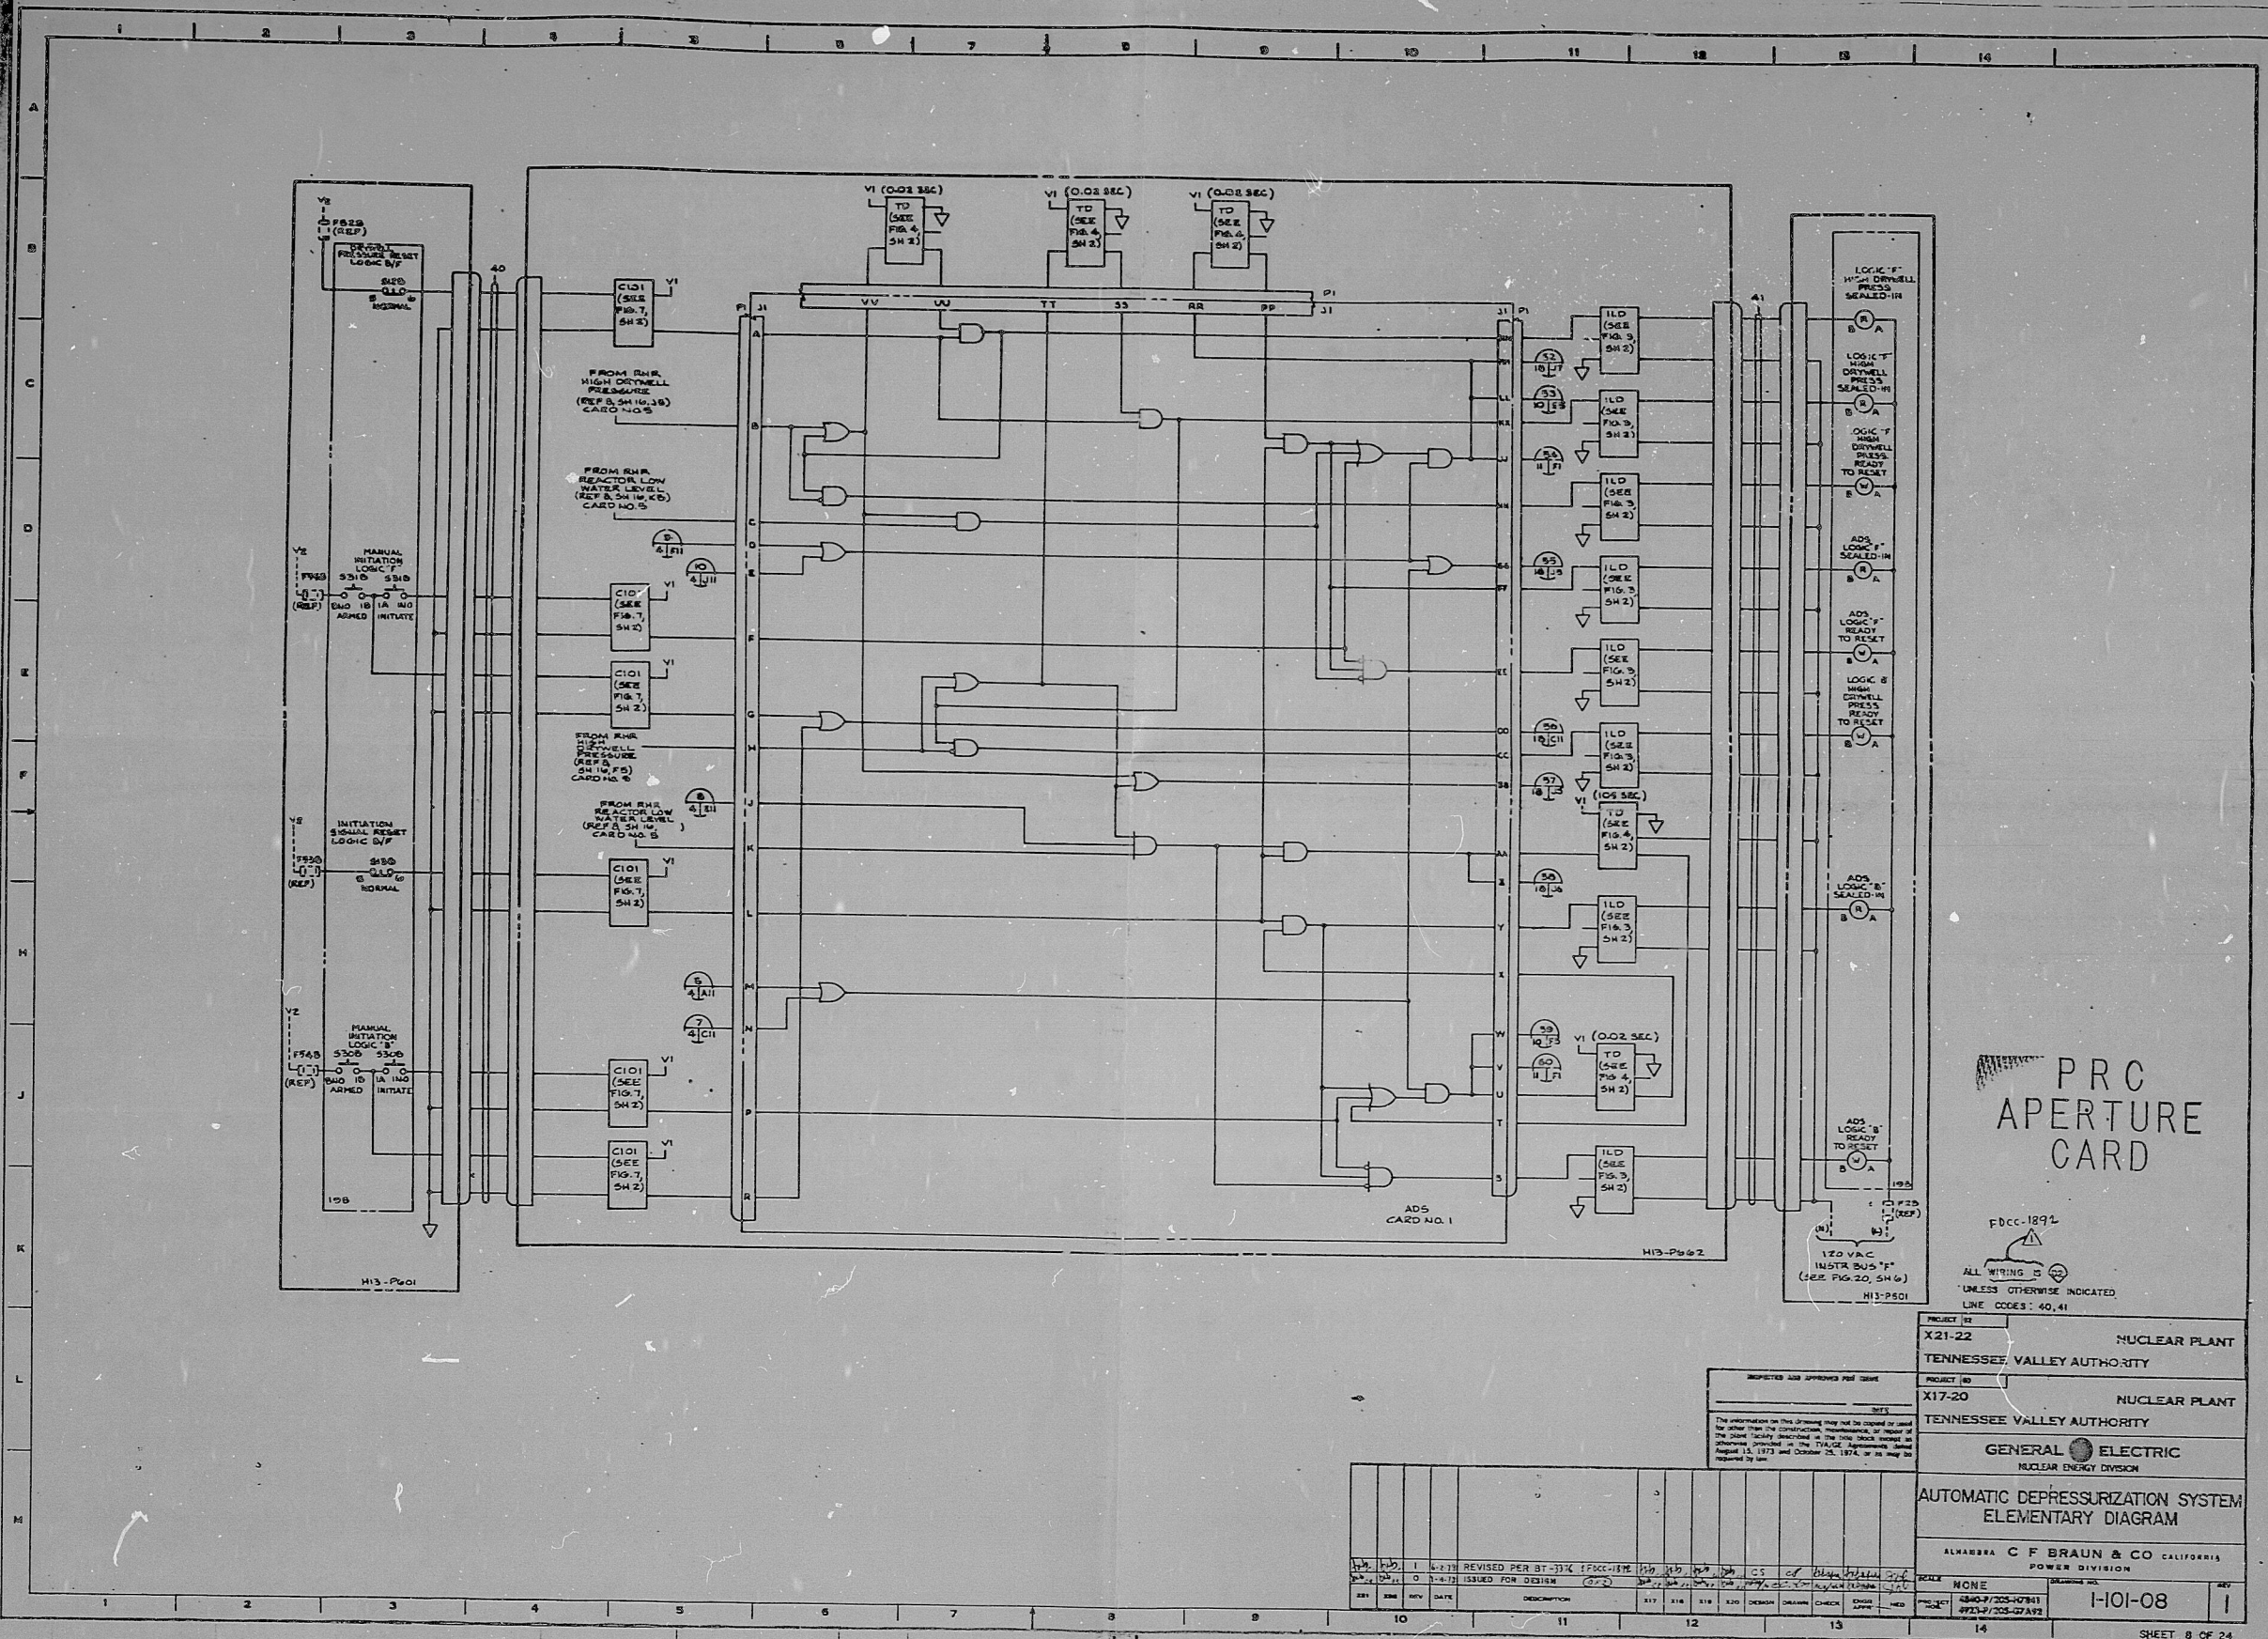