




PDR RIDS

8505310705

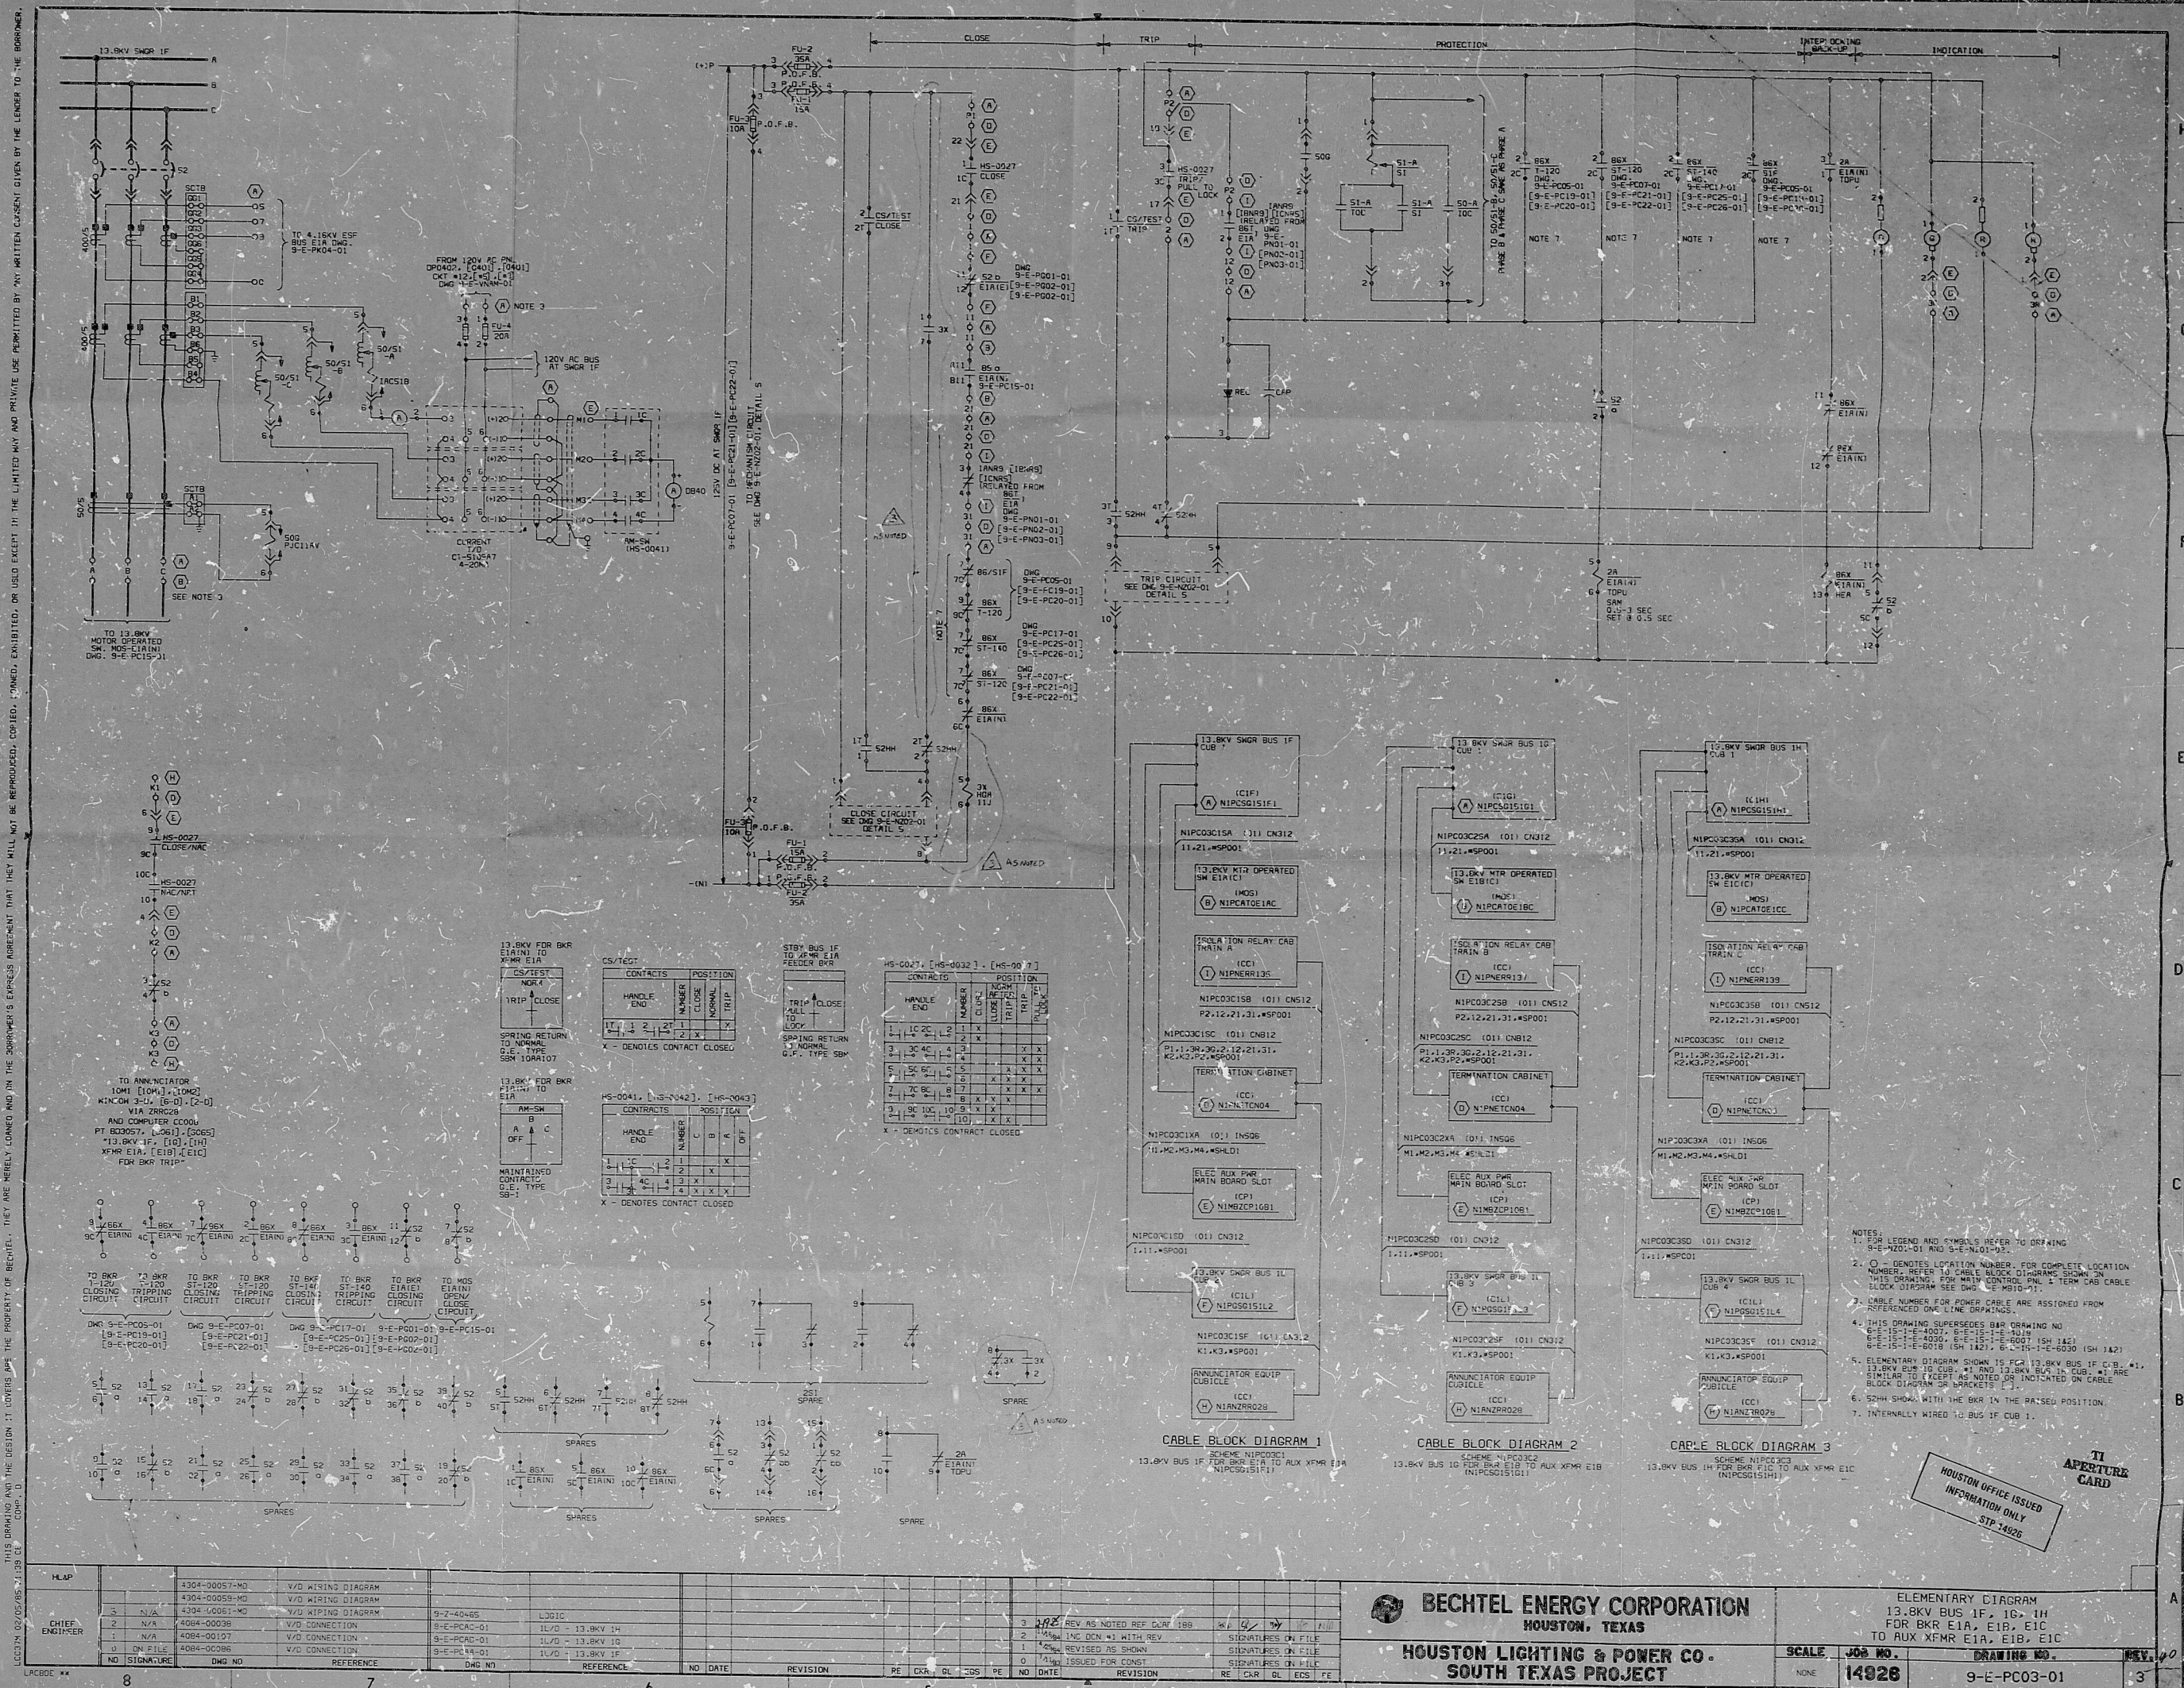