


11715-DAR-74A-1

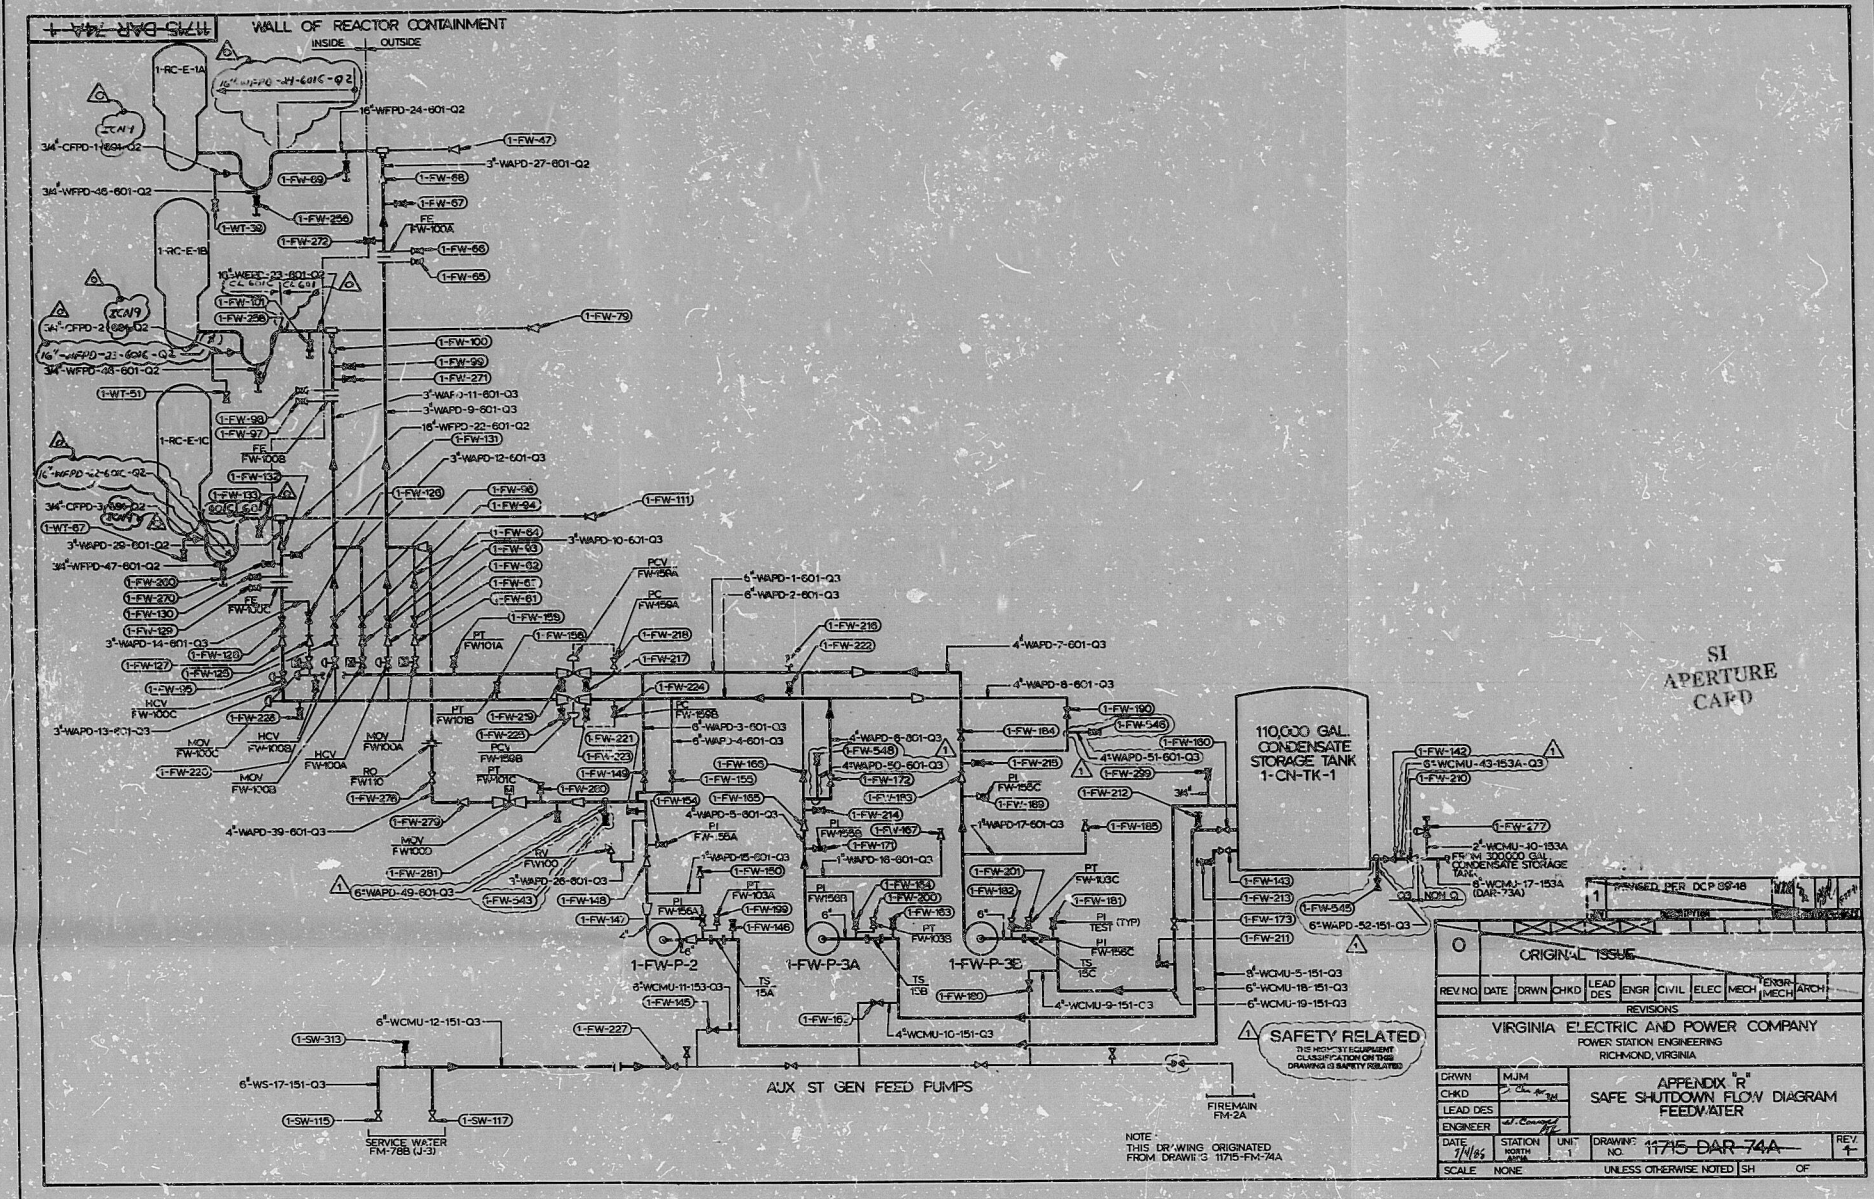

REV.	DATE	BY	CHK	DES	ENGR	PROJ	APPR
0	7/1/85	MSB	NIR	MSB	NIR		

COORDINATION SIGN-OFF

NO.	DATE	REVISIONS	BY	CHK	DES	ENGR	PROJ	APPR
0	7/1/85	ISSUED FOR CONSTRUCTION OF DC 30-13-1	MSB	NIR	MSB	NIR		

N-9013-1-1DAR74A REV 0

INFORMATION ONLY

PDR RIDS

921160512

