


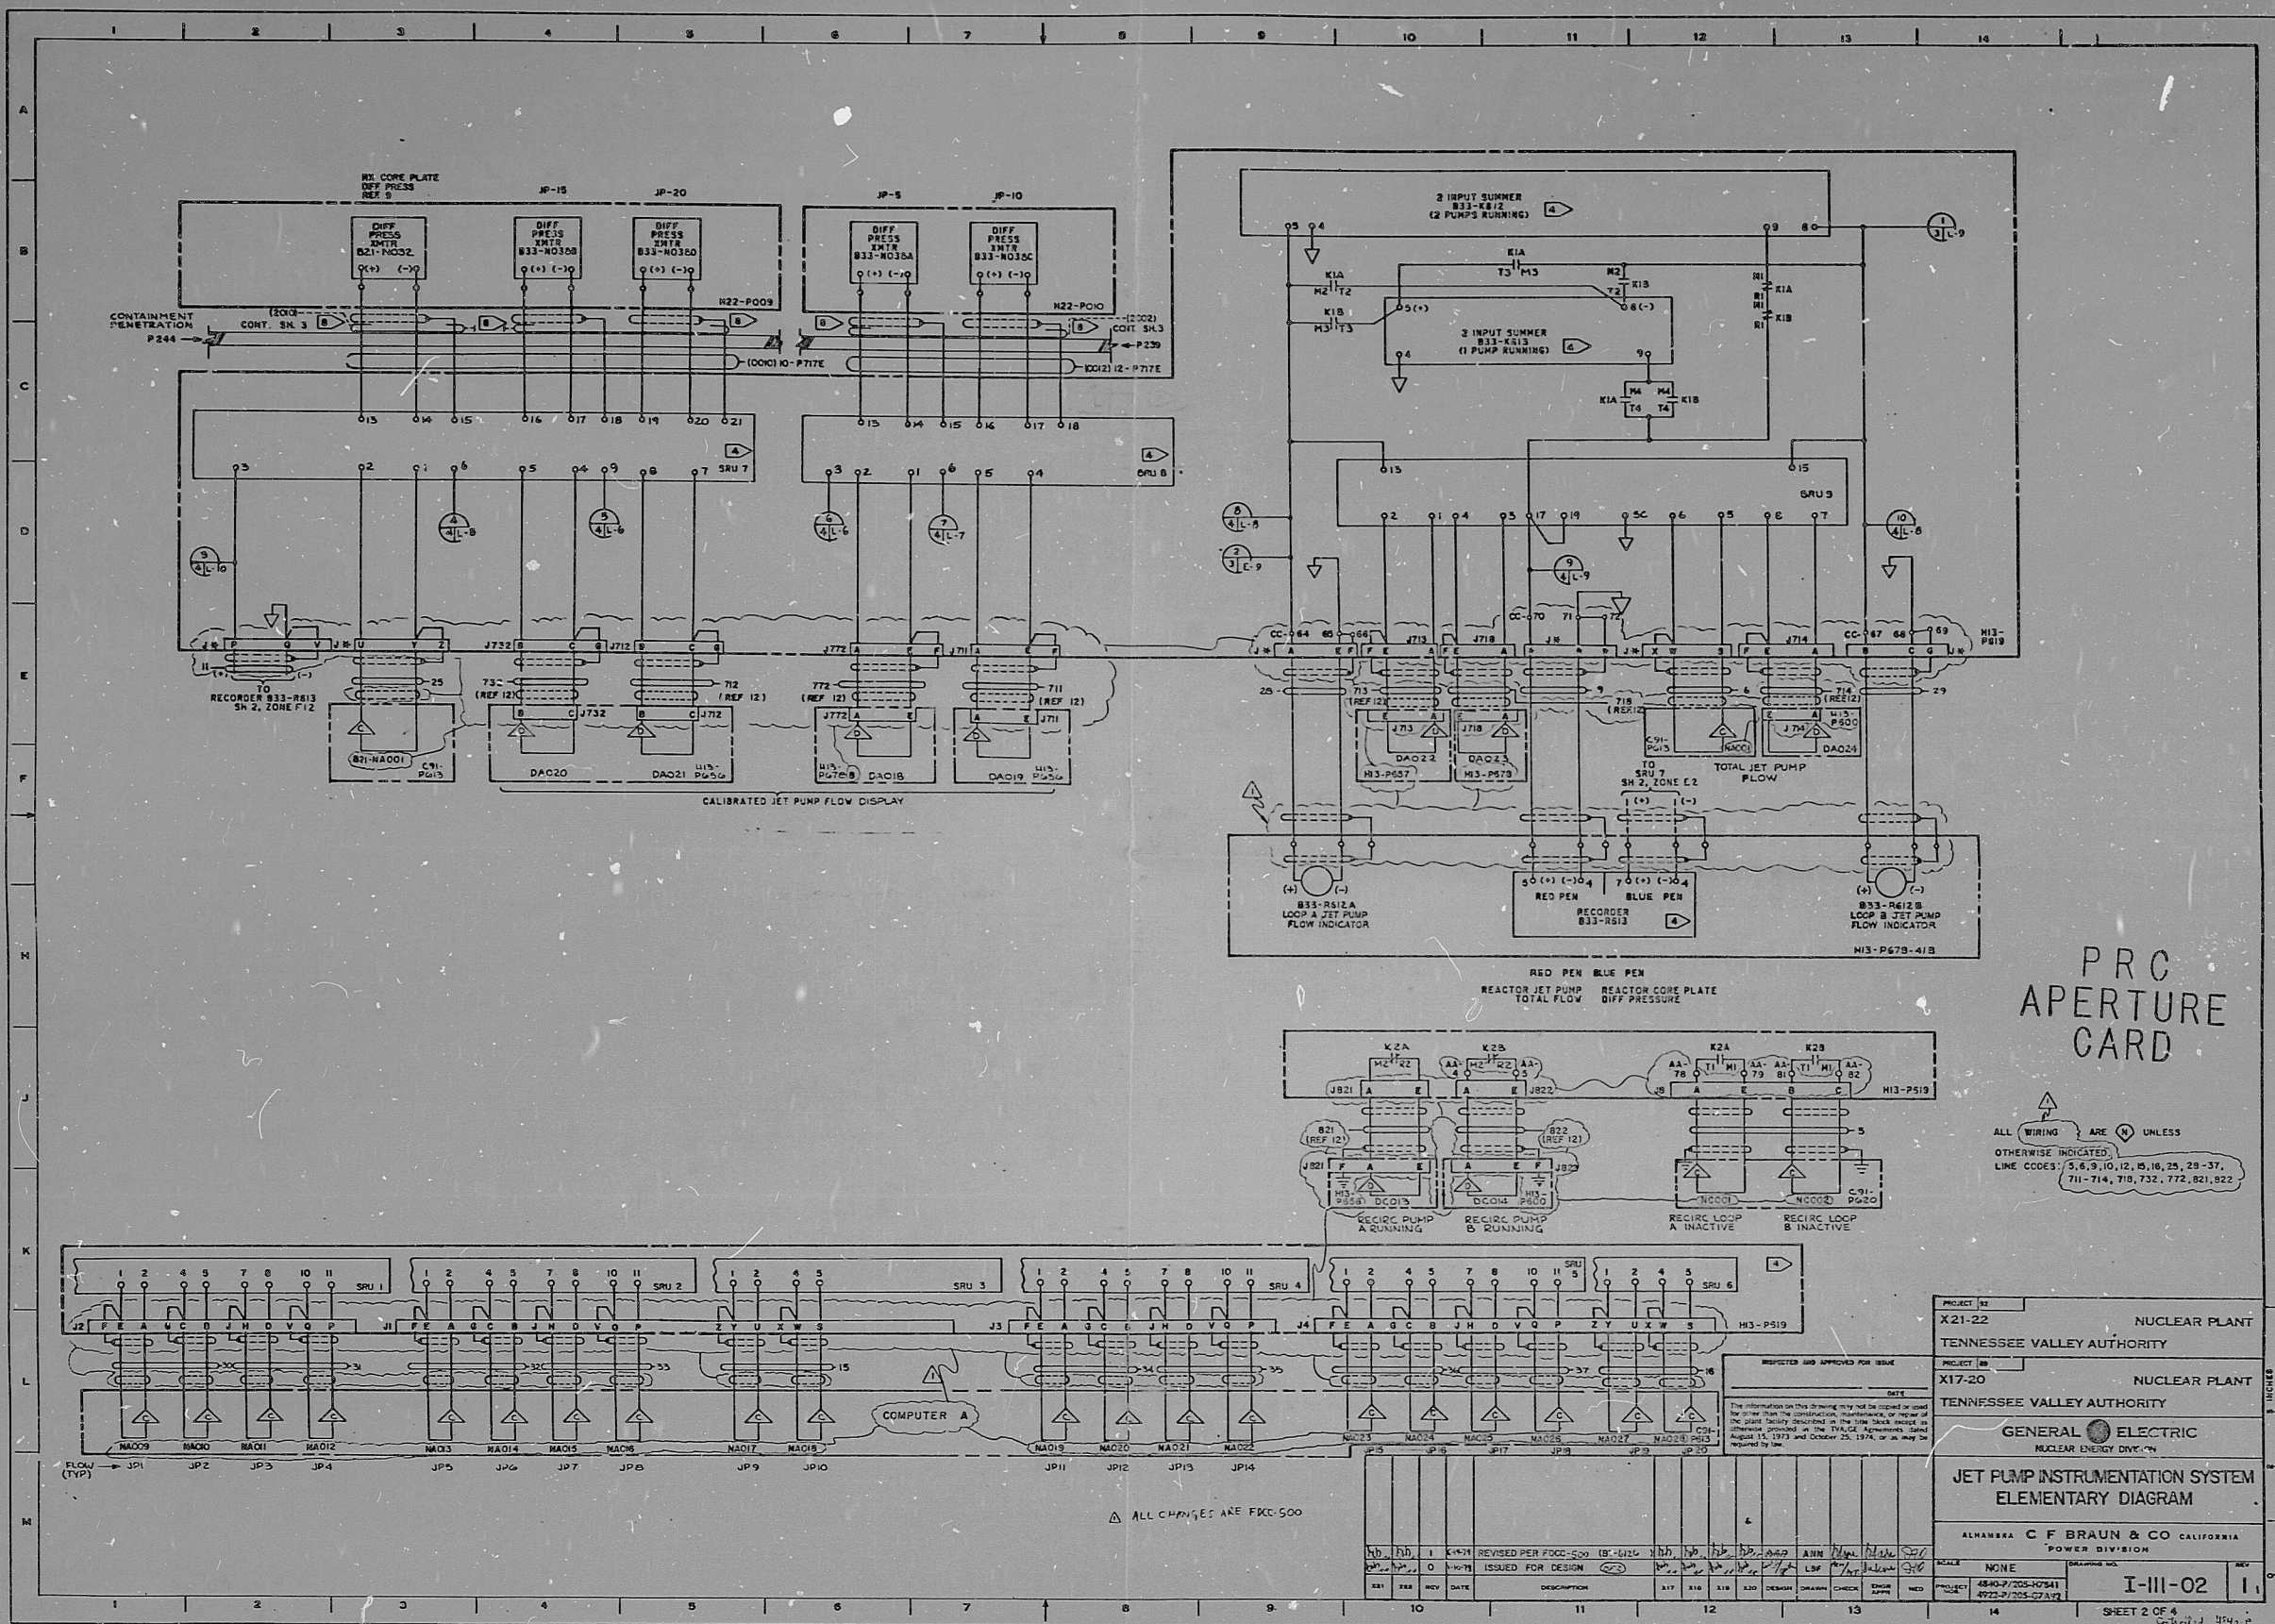

RIDS

8206210654

