


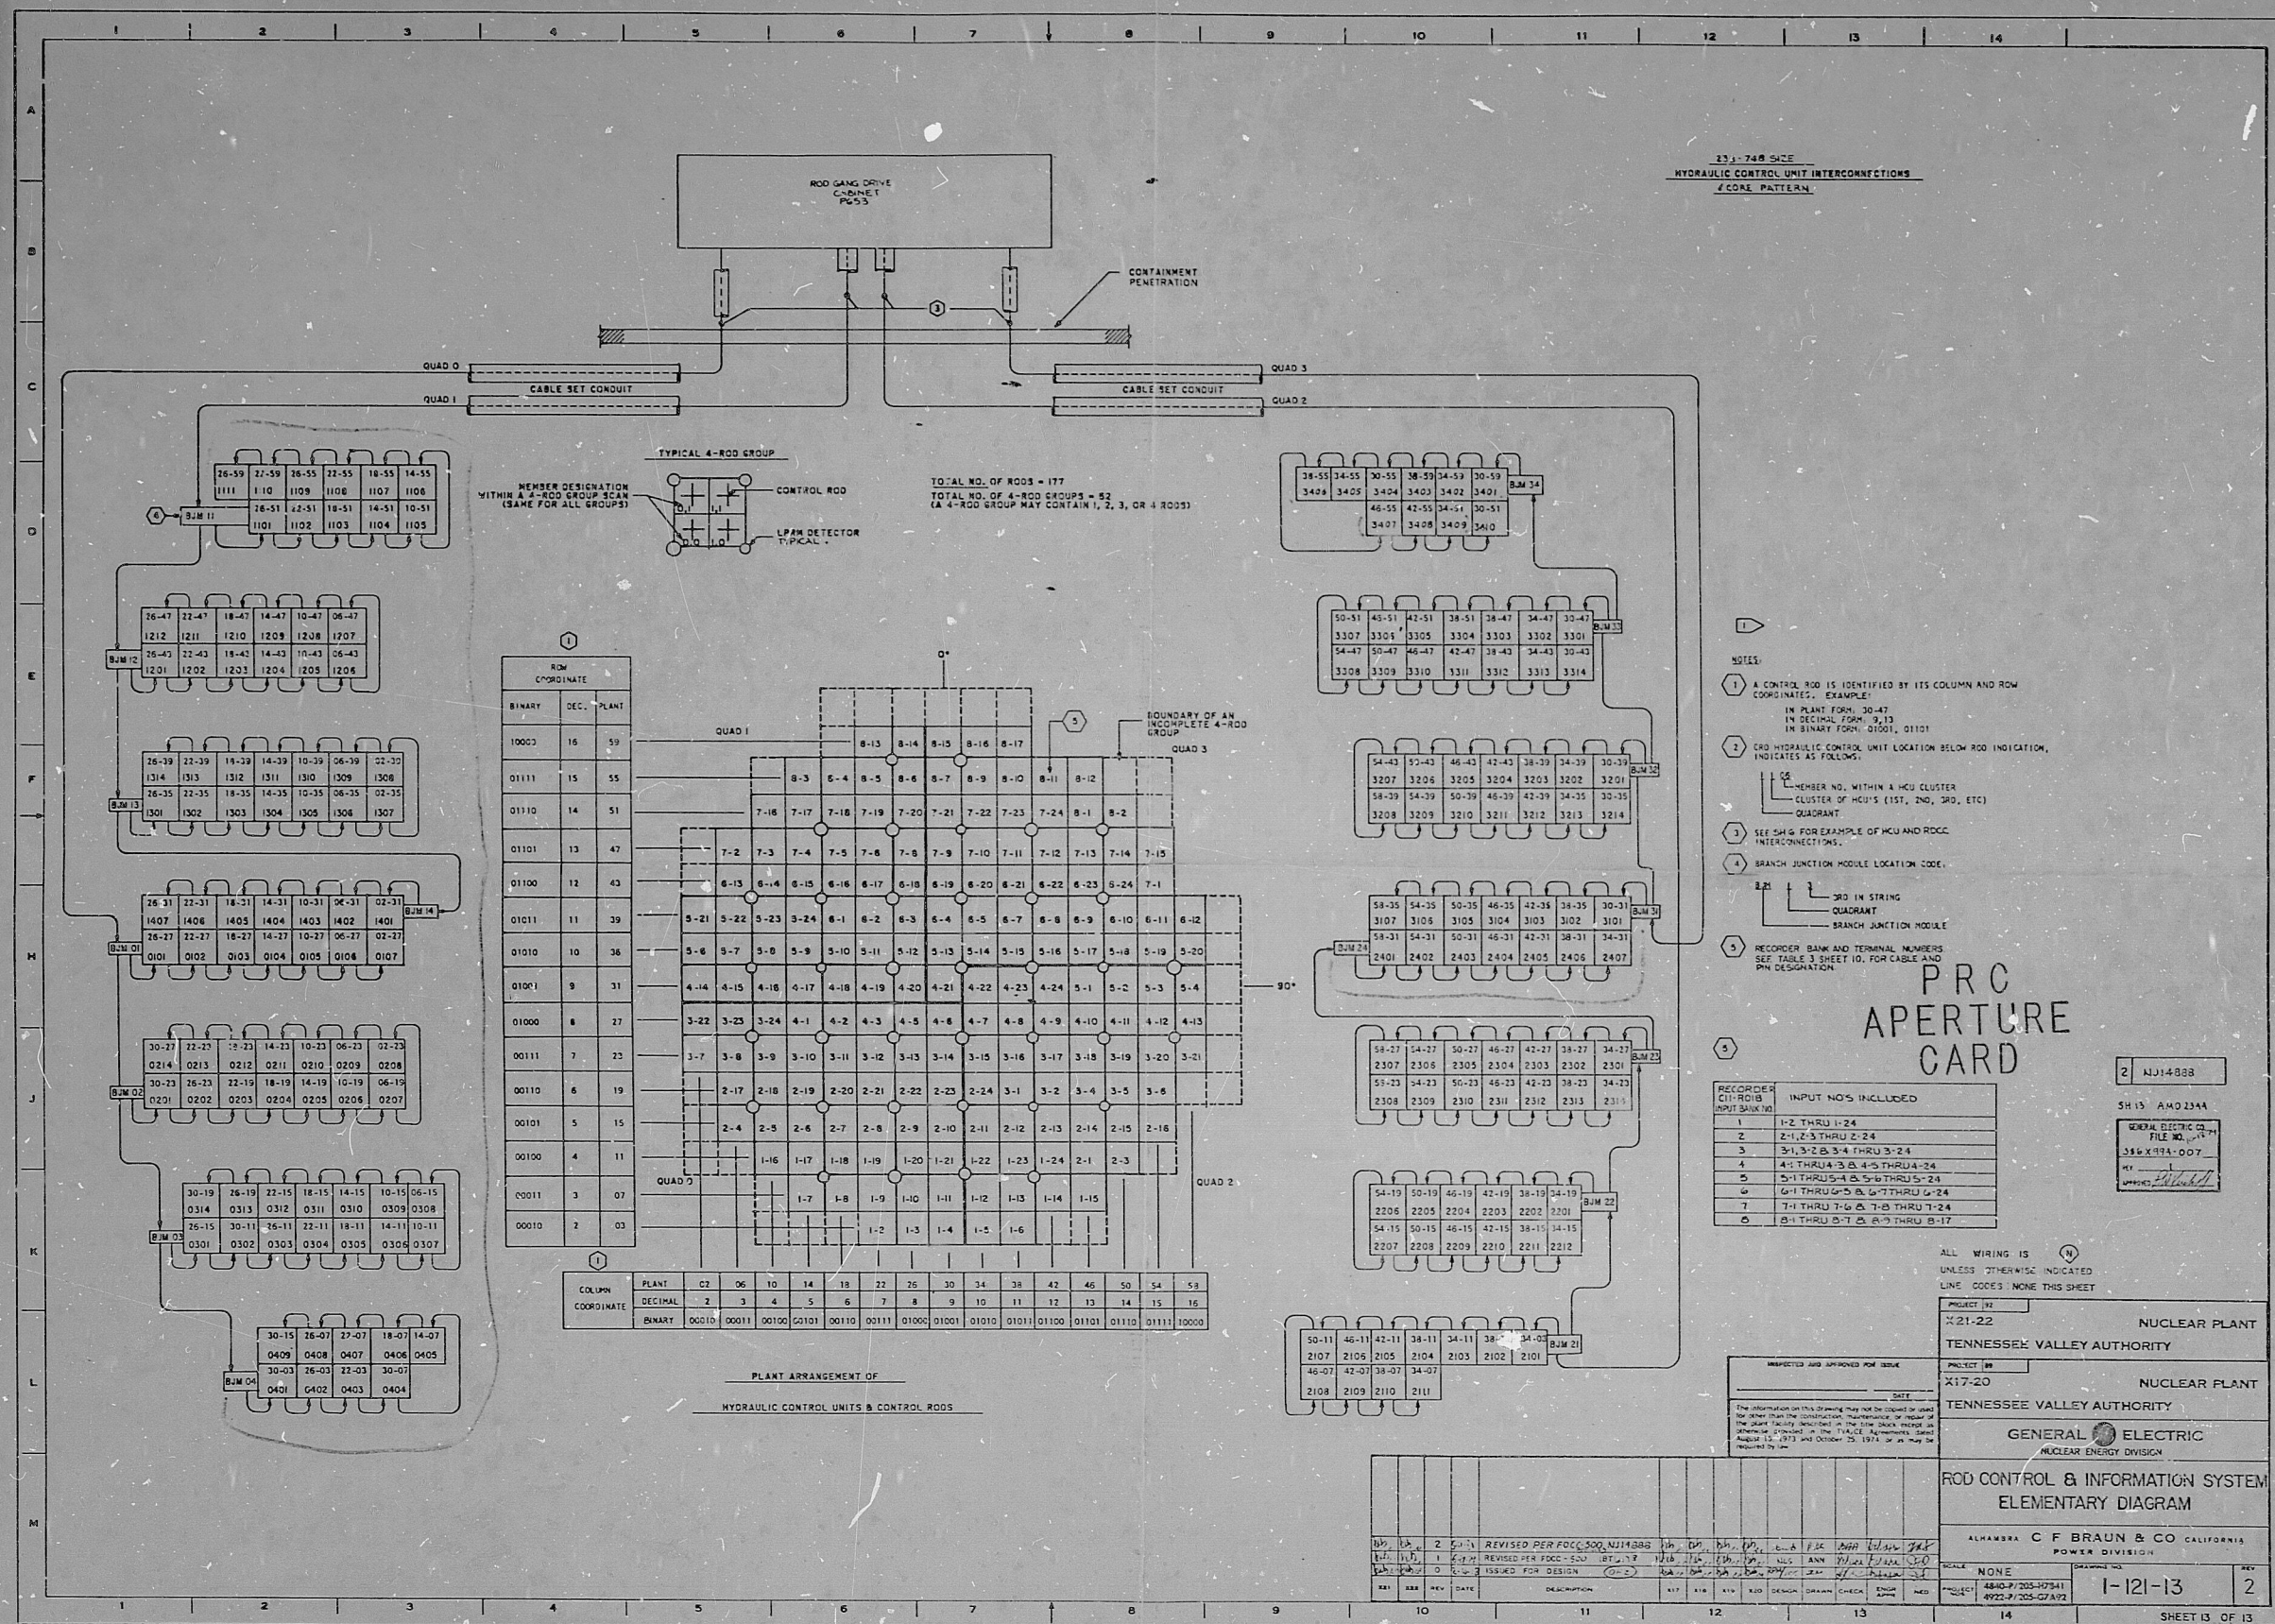

RIDS

8206210680

