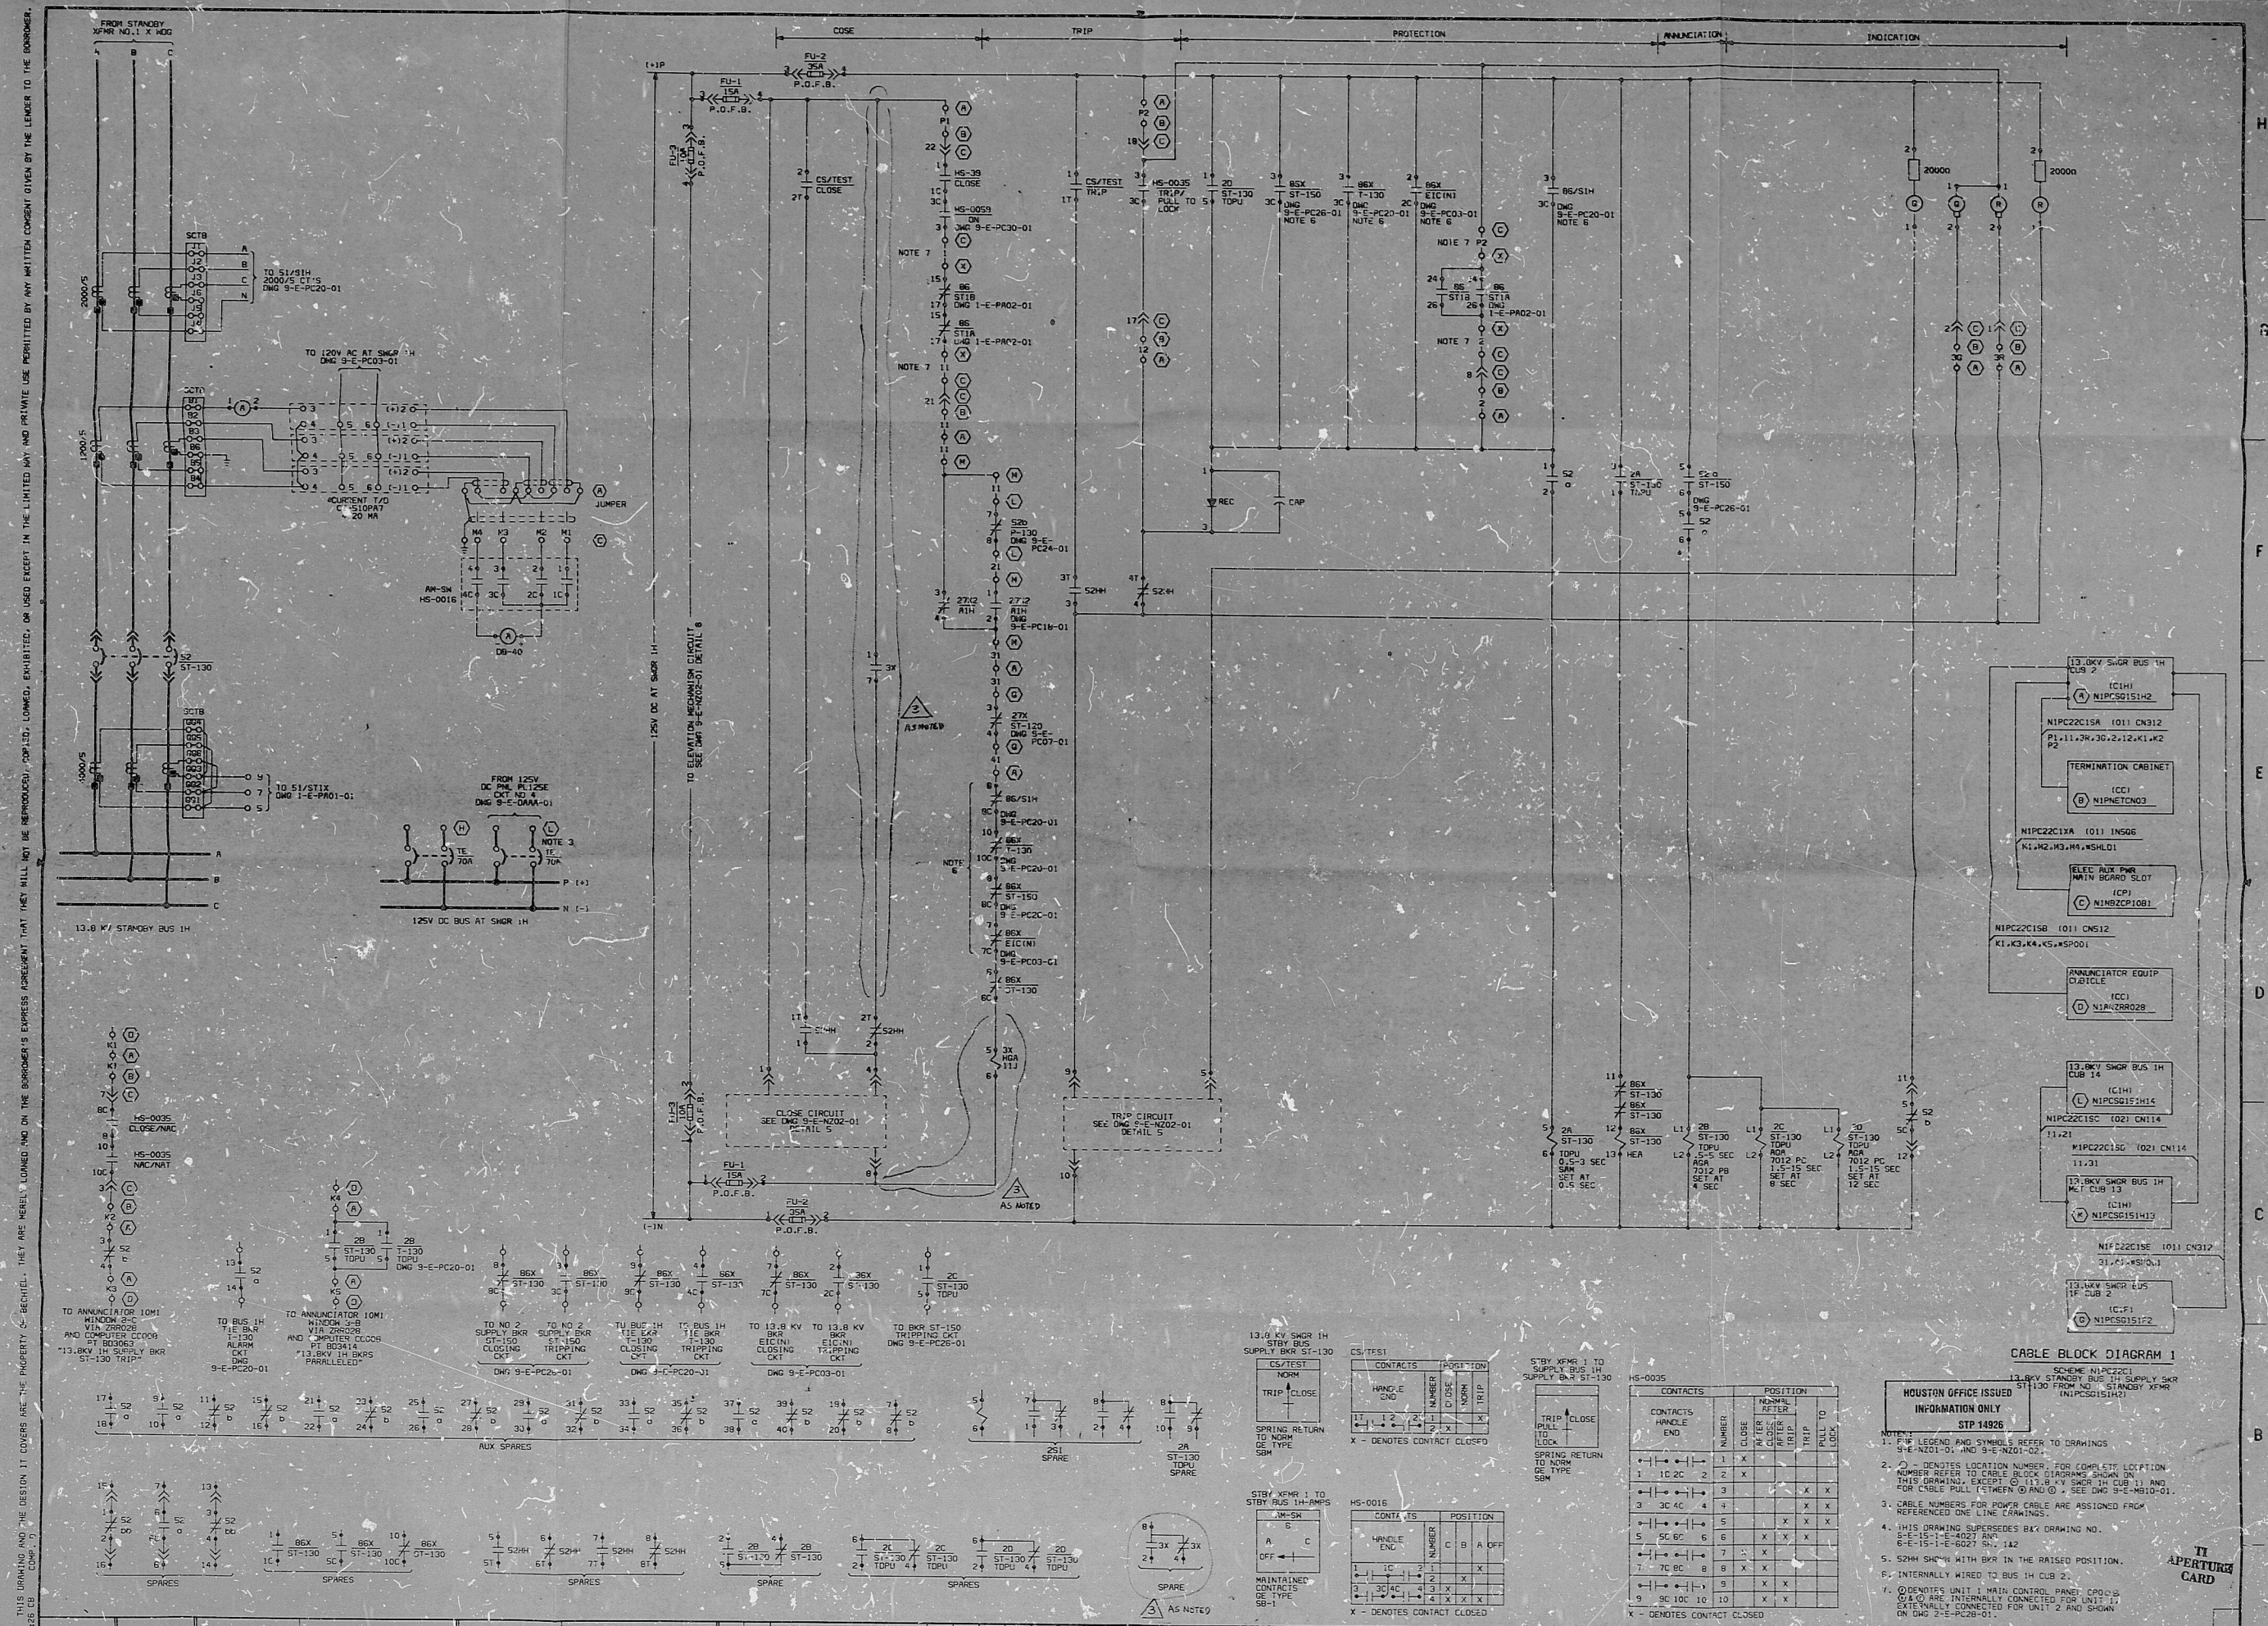


[illegible]

 **BECHTEL ENERGY CORPORATION**
HOUSTON, TEXAS

HOUSTON LIGHTING & POWER CO.
SOUTH TEXAS PROJECT

ELEMENTARY DIAGRAM			
13.8KV STANDBY BUS III SUPPLY BKR ST-130 FROM NO. 1 STANDBY XFMR			
SCALE	JOB NO.	DRAWING NO.	REV.
NONE	14928	9-E-PC22-01	3

PDR RIDS

8506030348

