


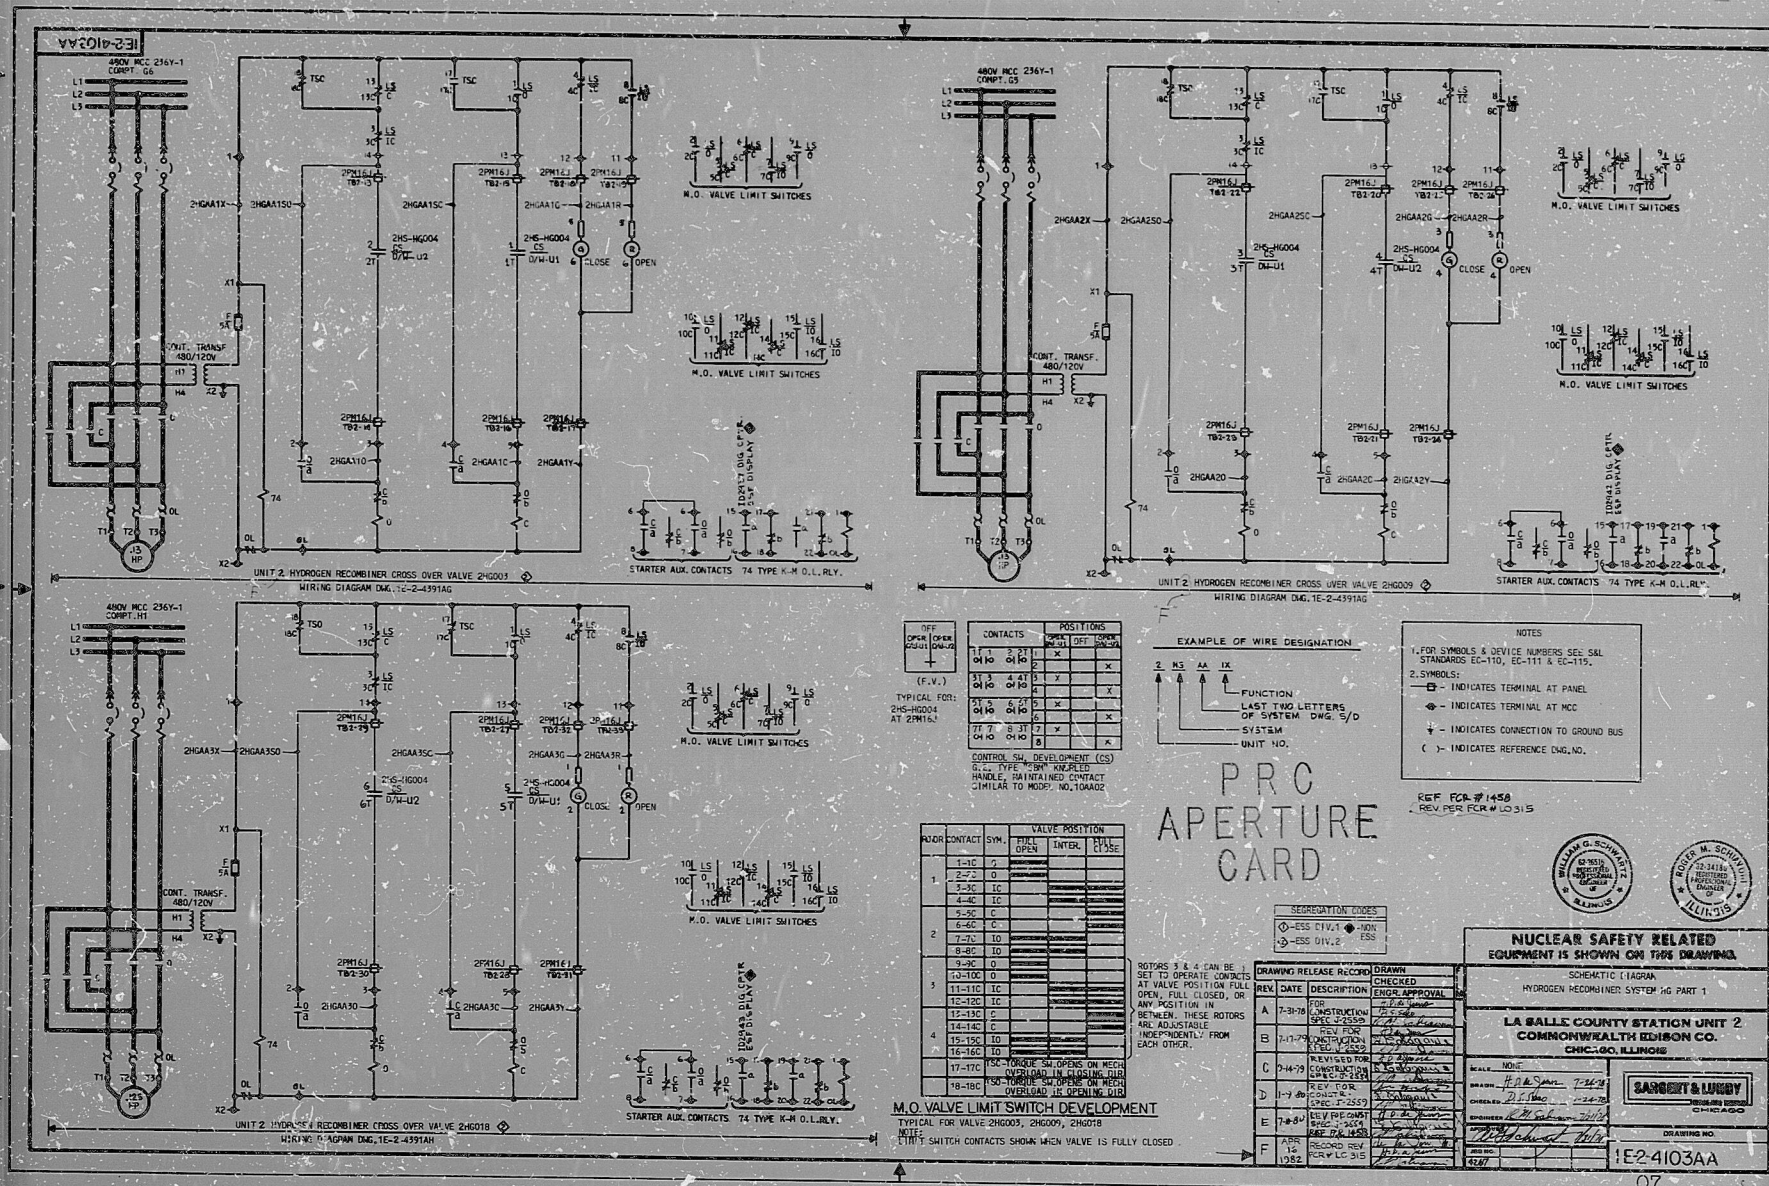

RIDS

83083 | 0138

