


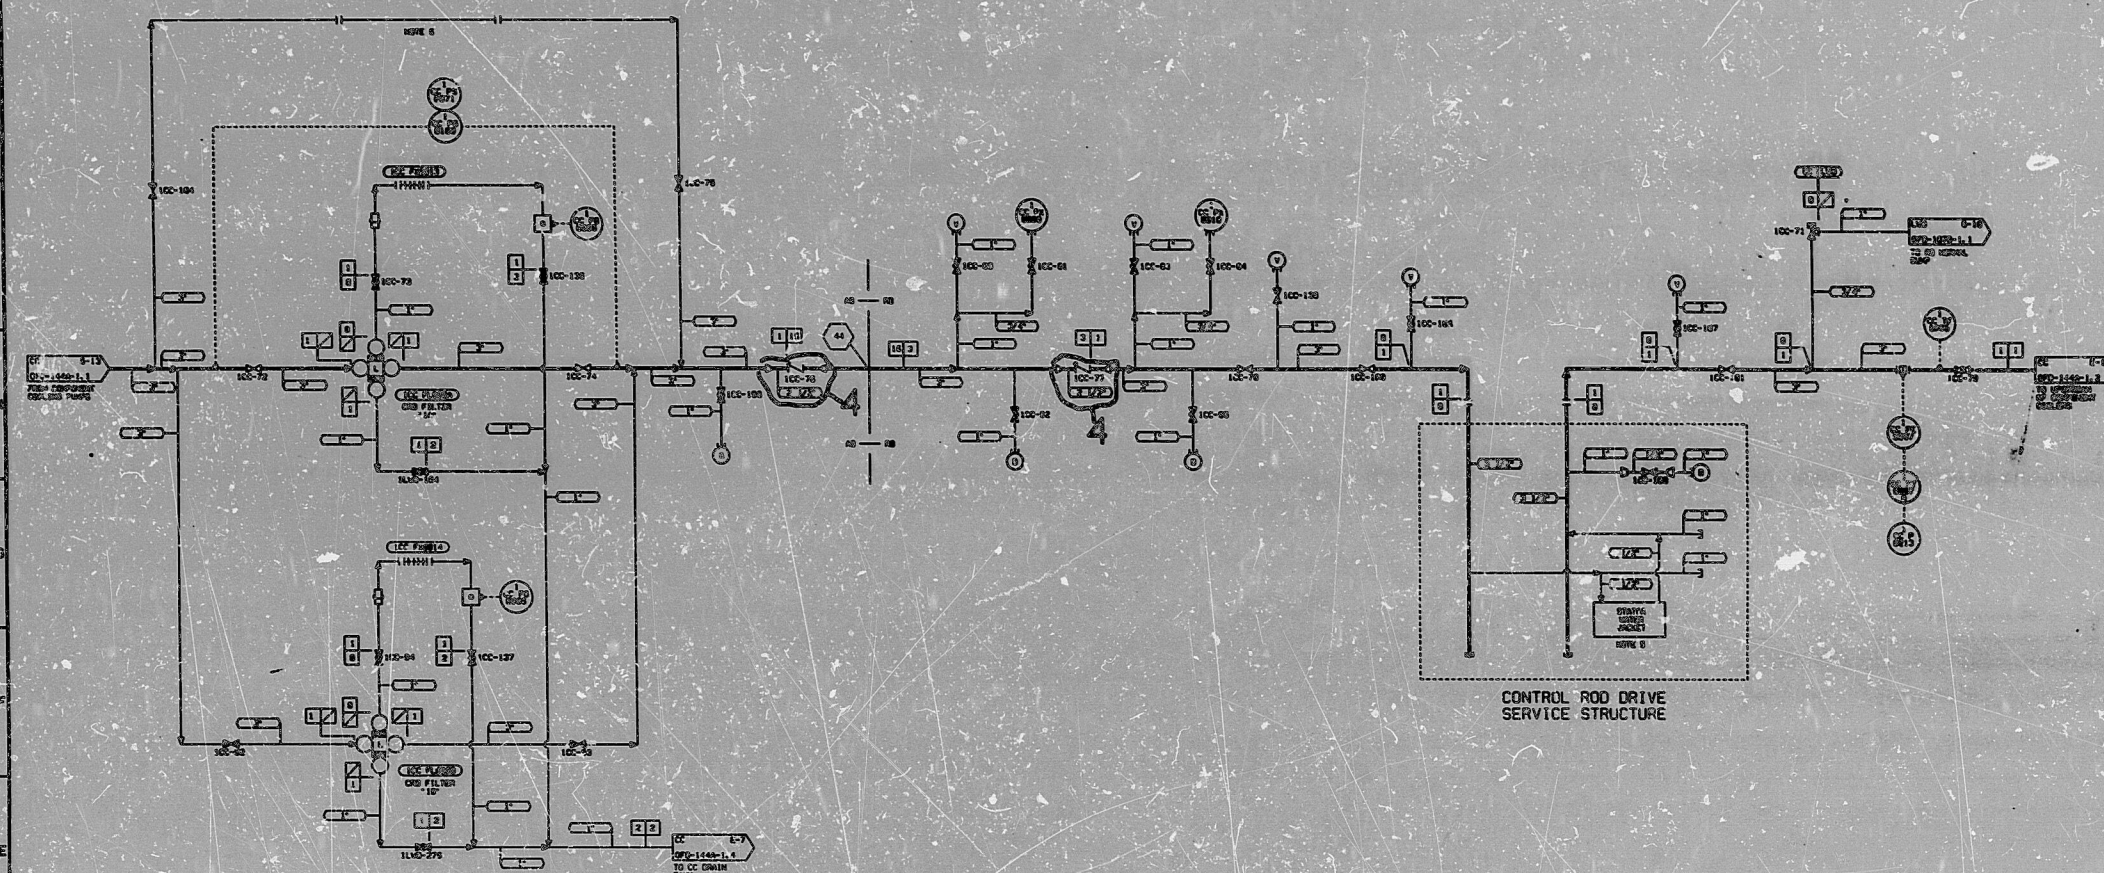

SI
APERTURE
CARD

FOR REFERENCE ONLY
NOT A WORKING COPY

NOTE:




QA CONDITION 1

ELINE POWER COMPANY

FLUX DIAGRAM OF

COMPONENT COOLING SYSTEM

(CONTROL ROD DRIVE SERVICE
STRUCTURE & FILTERS)


QED-1440-1 3

UFG-1444-1.3

* 9211240042 Mother

9211300401

PDR RIDS

