


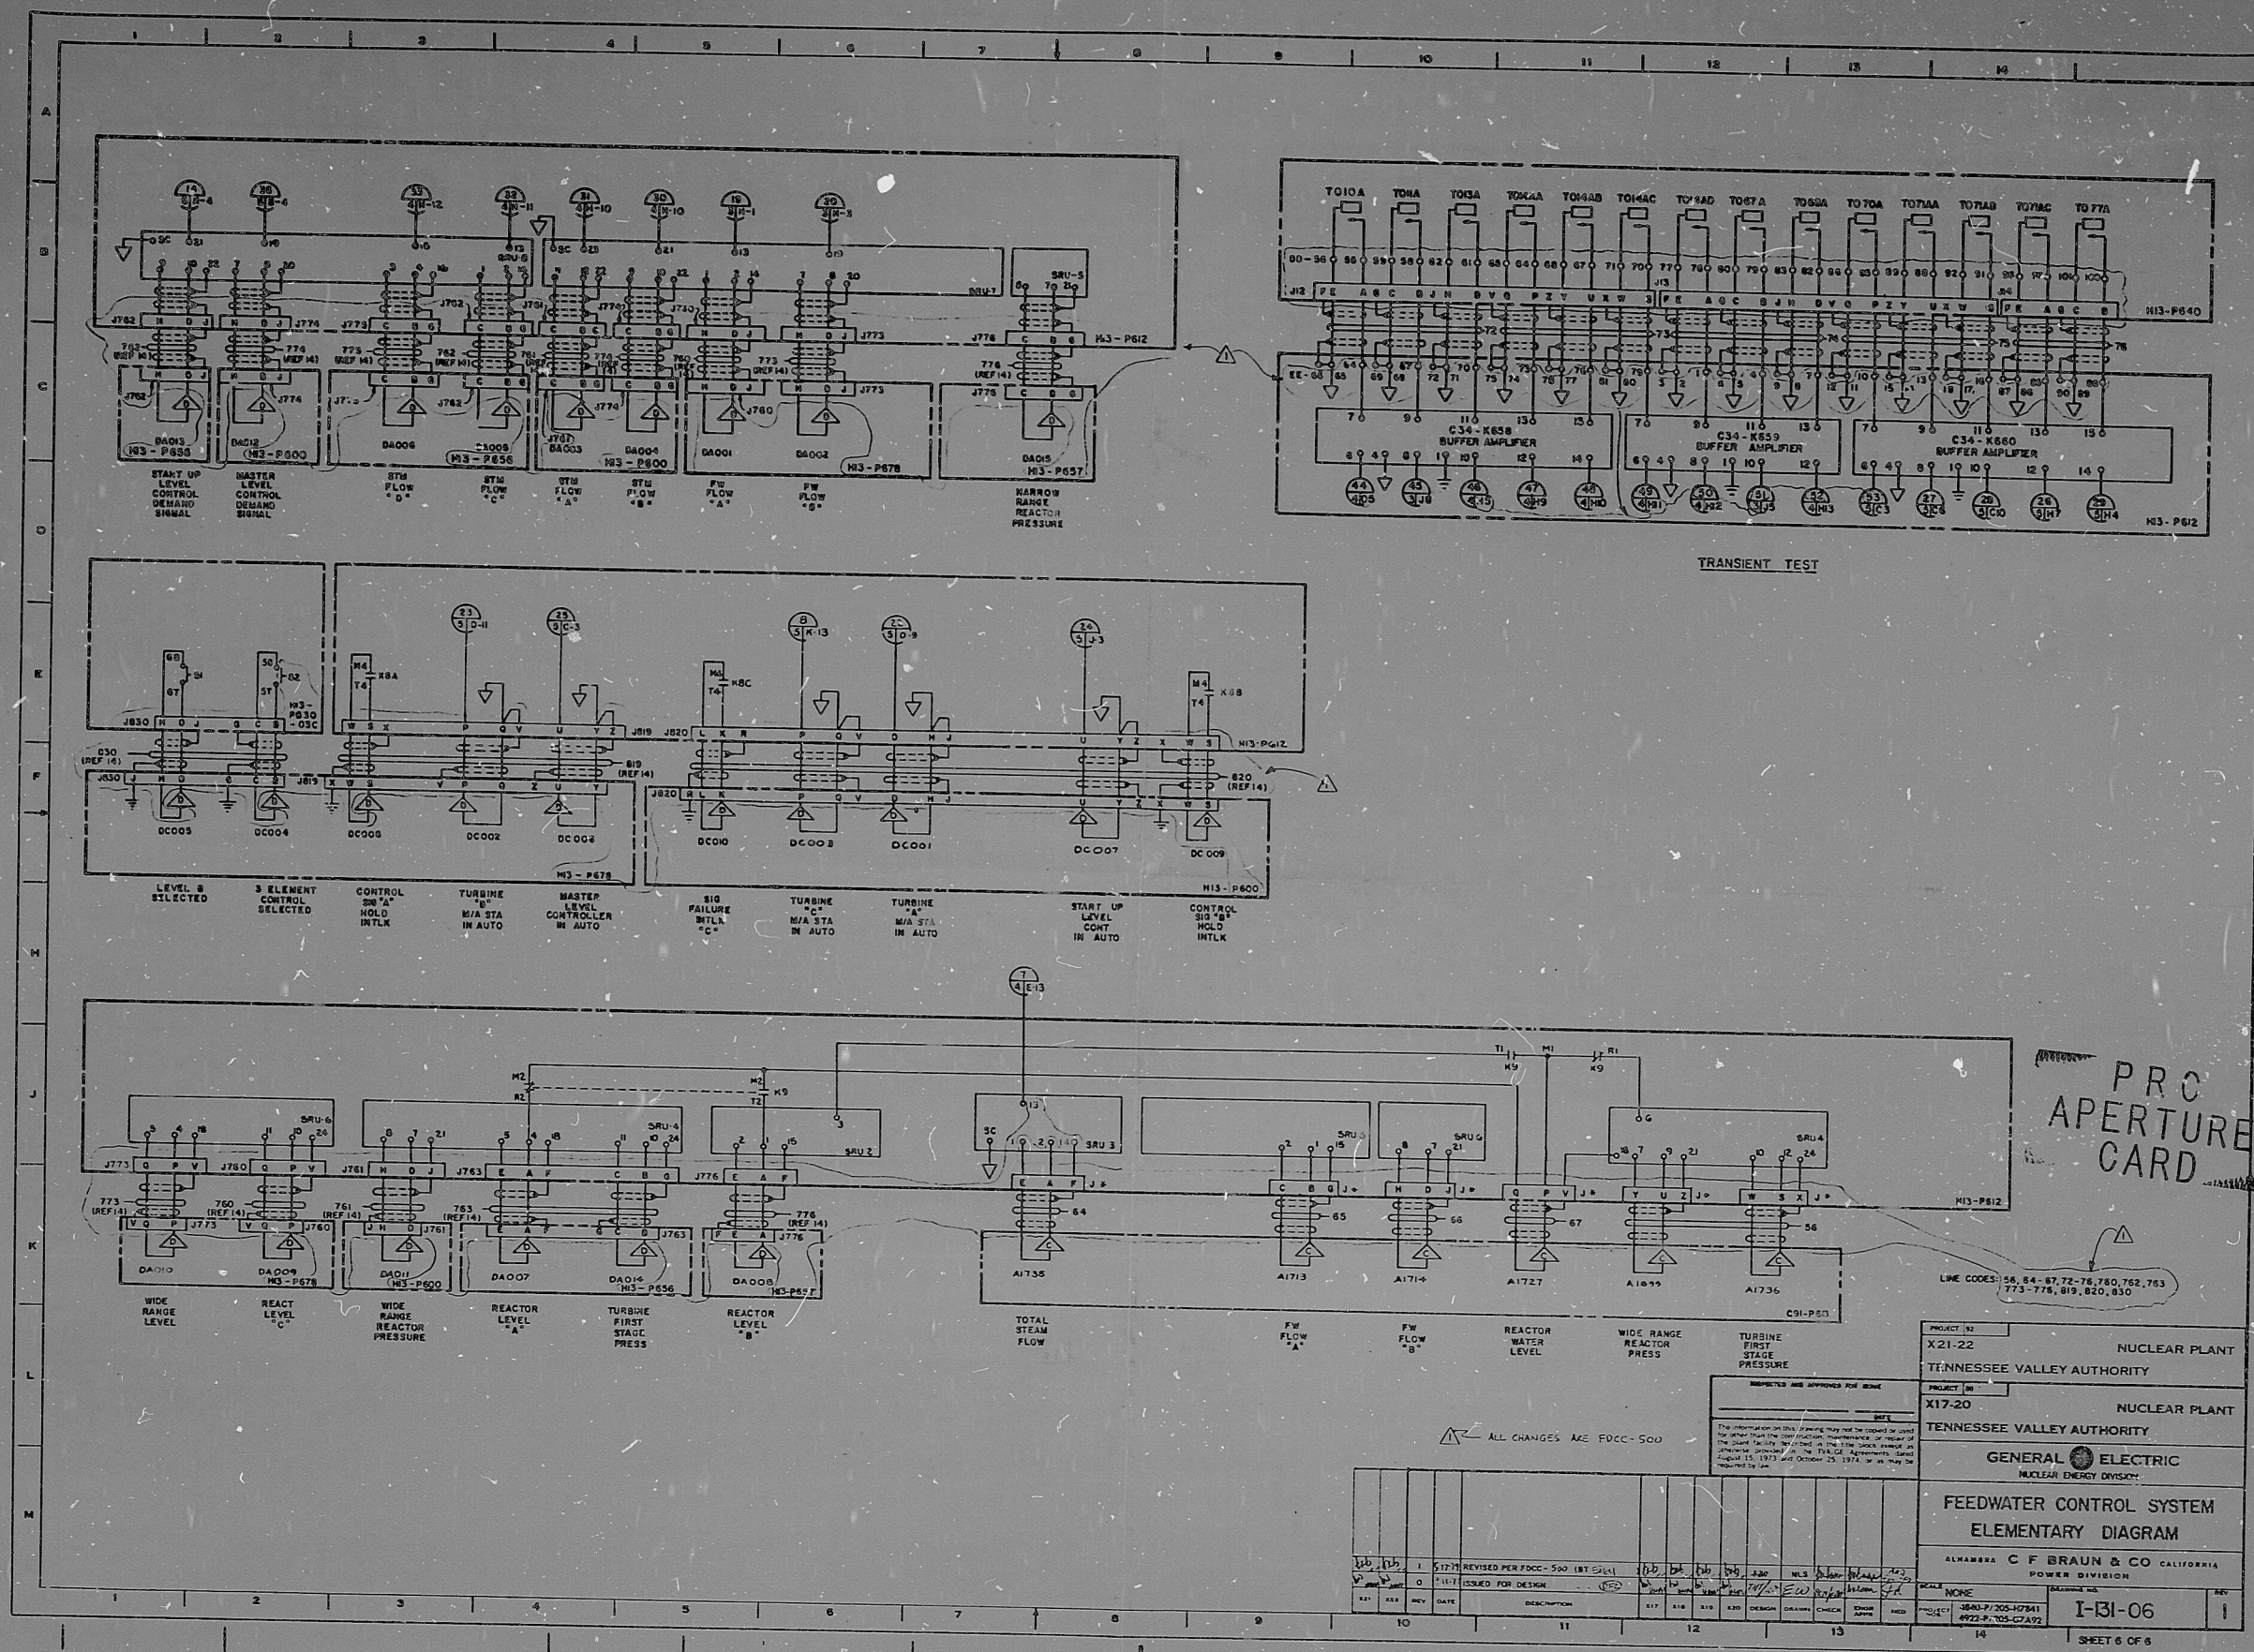

RIDS

806250038

