


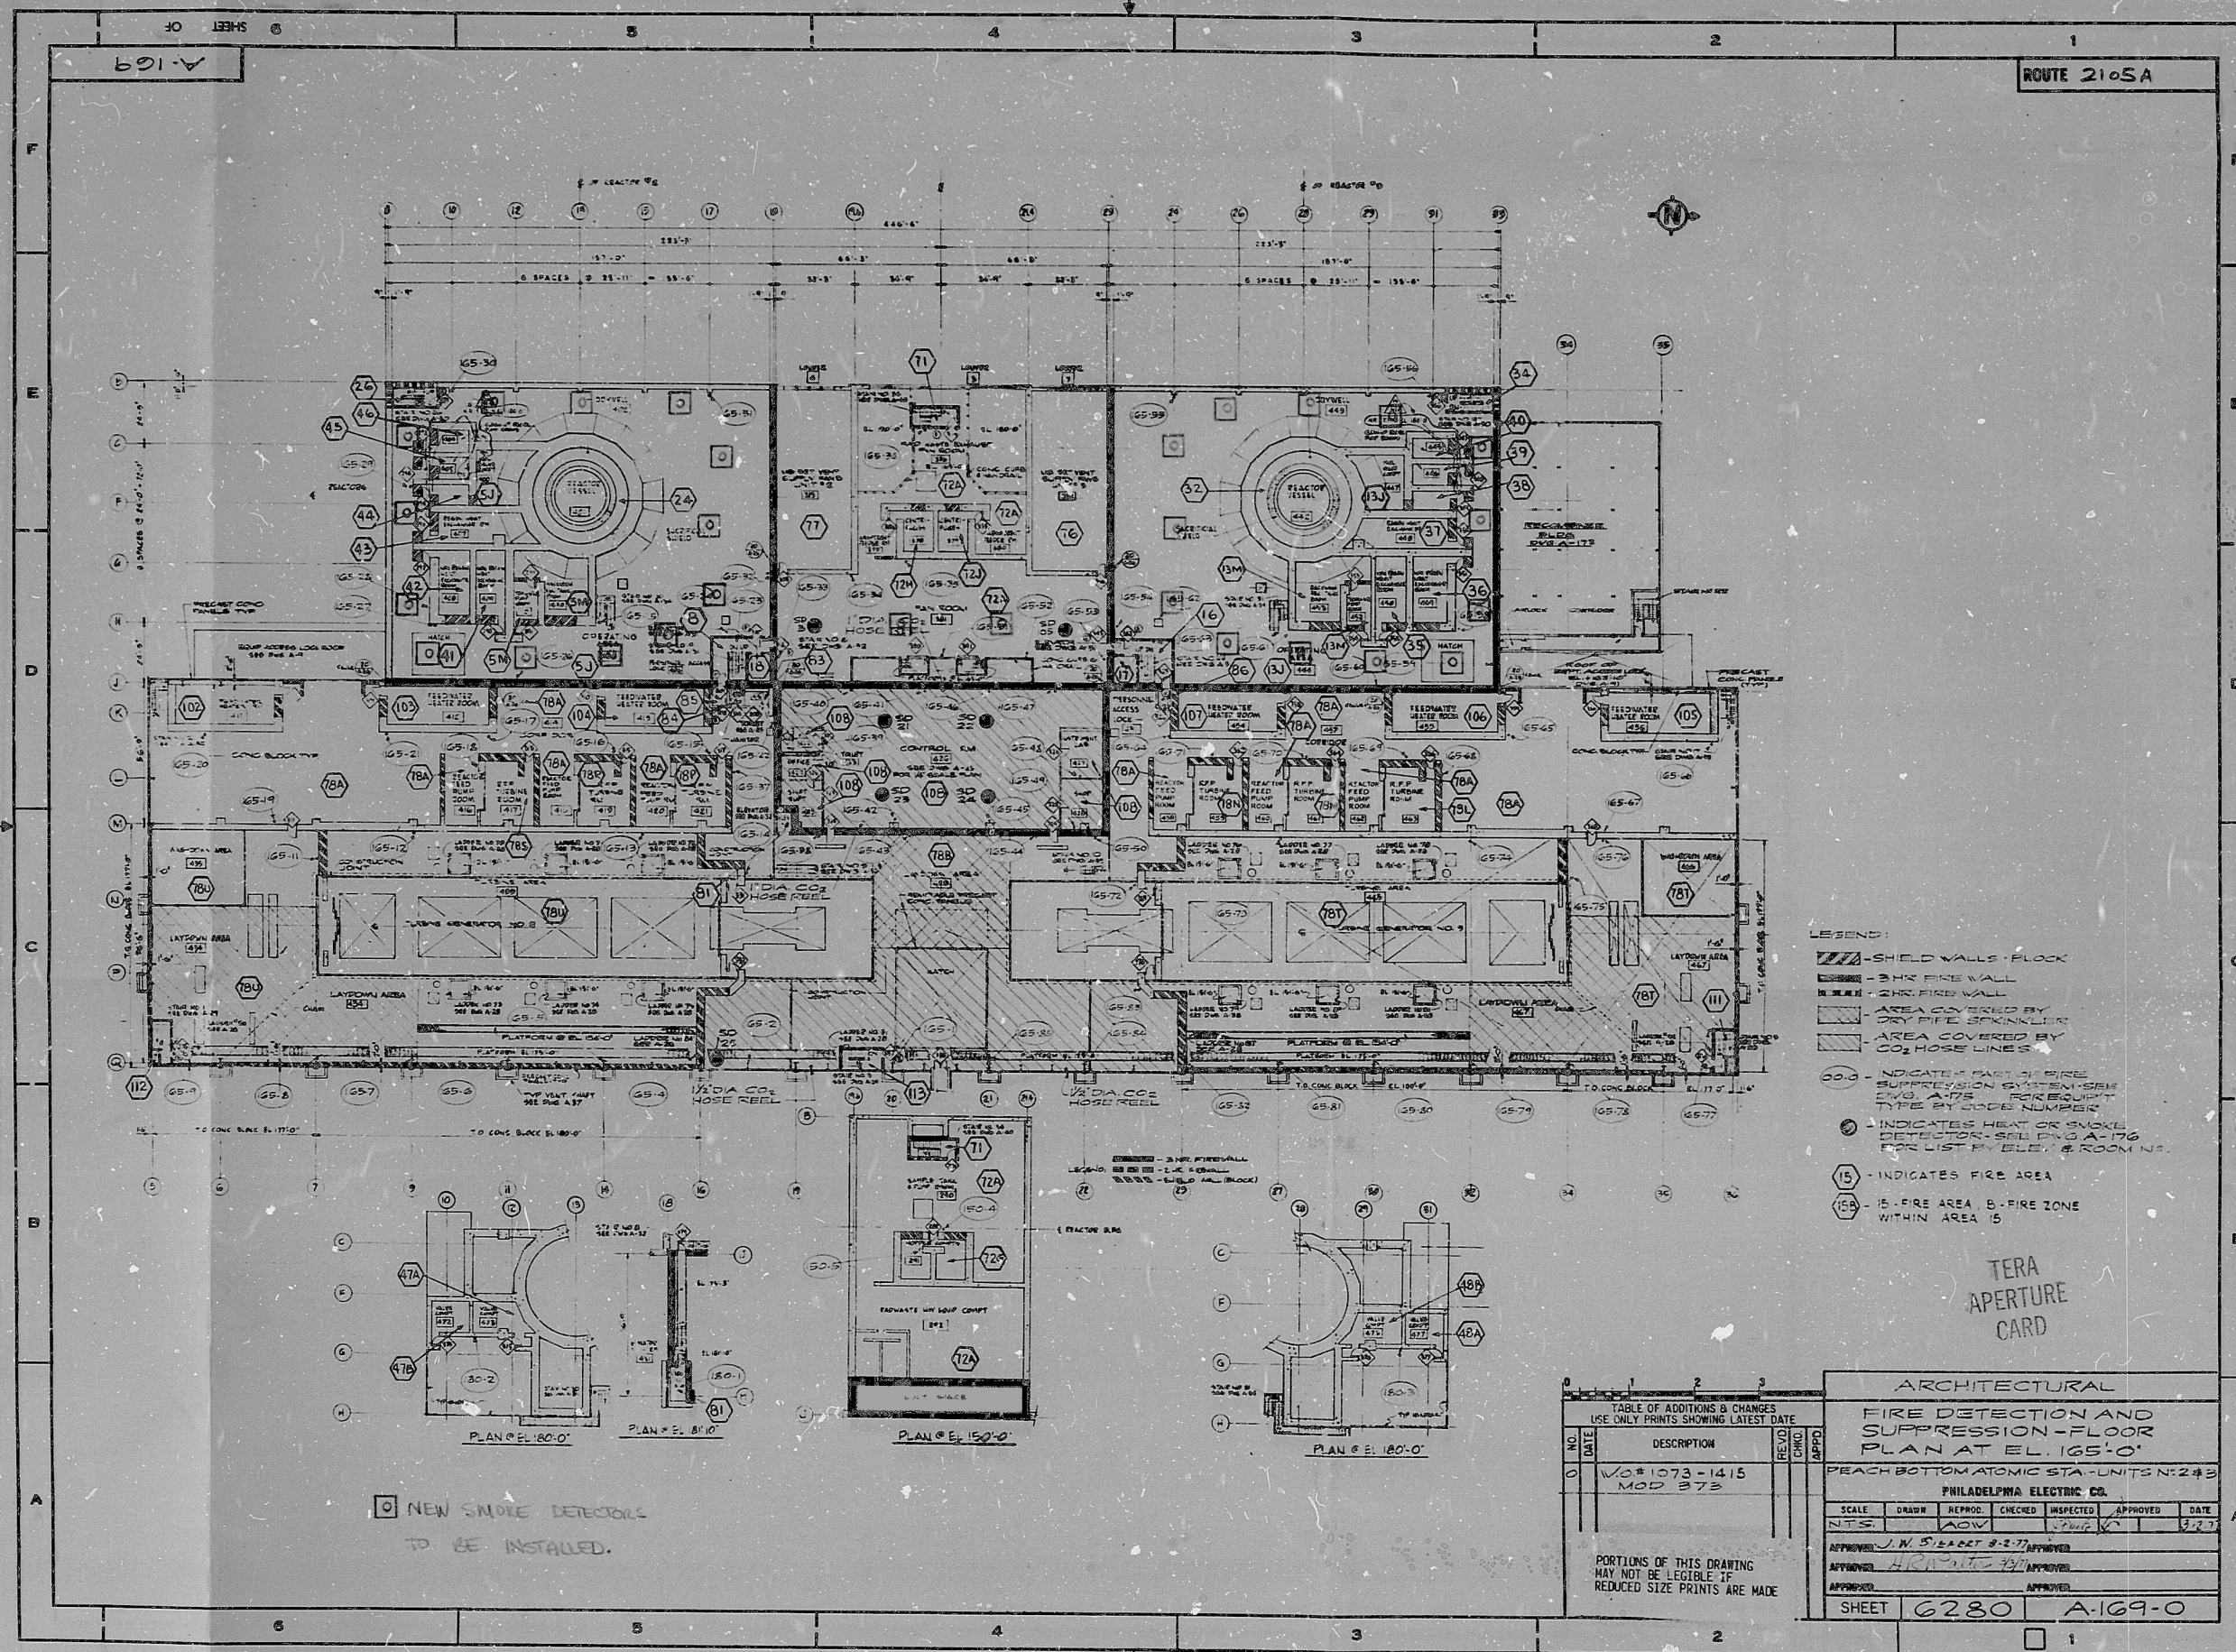

RIDS-PDR

8103250301

