FOR REFERENCE ONLY
NOT A WORKING COPY

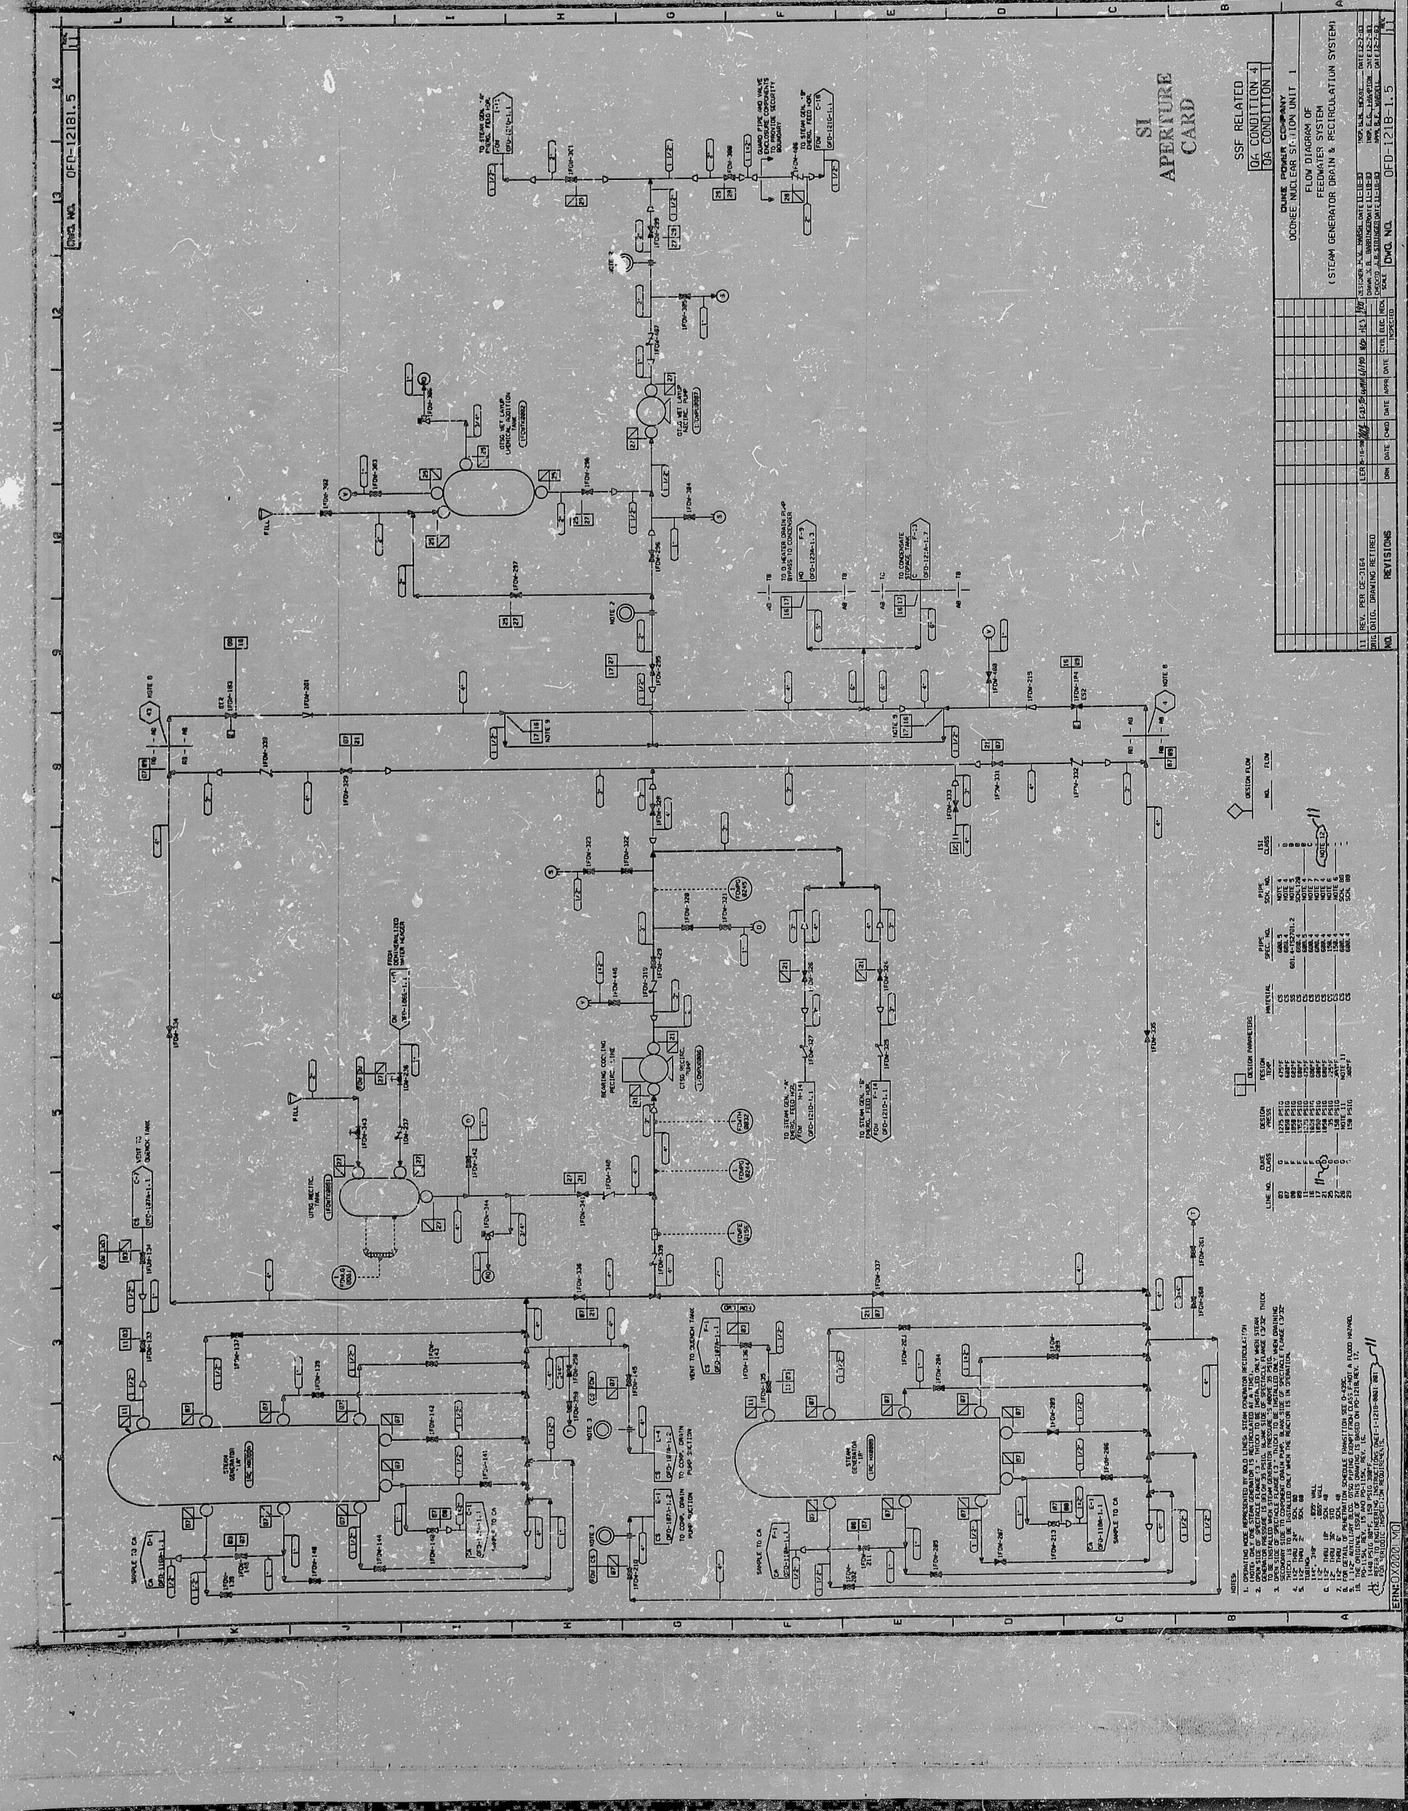

9212040442

PDR RIDS

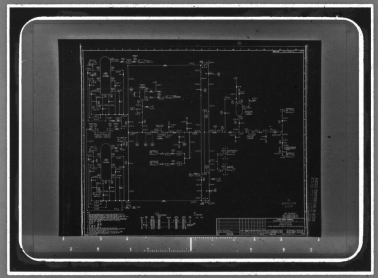

MMM 5824 FILMSORT® & DUPLICARD® Cards

3M, St. Paul, MN.