


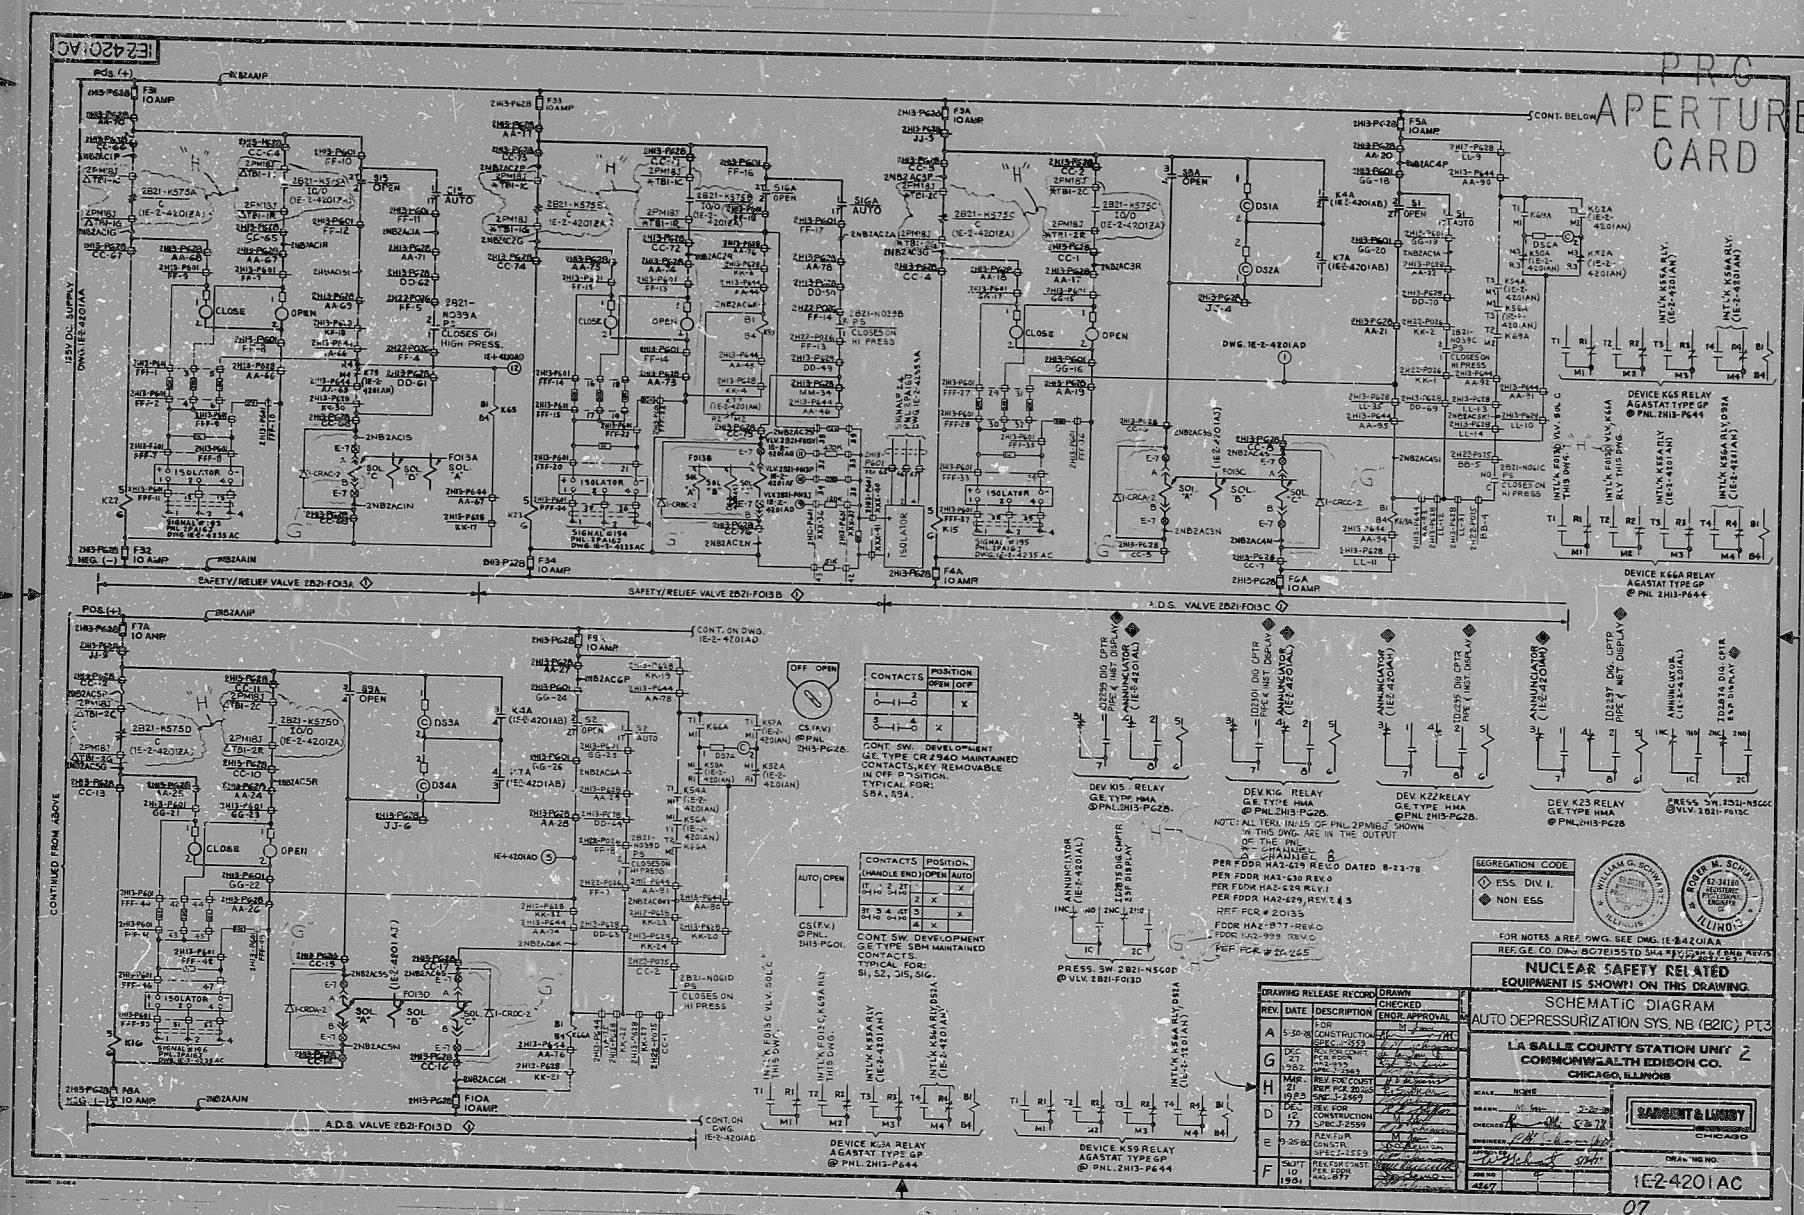



RIDS

8308310171

