


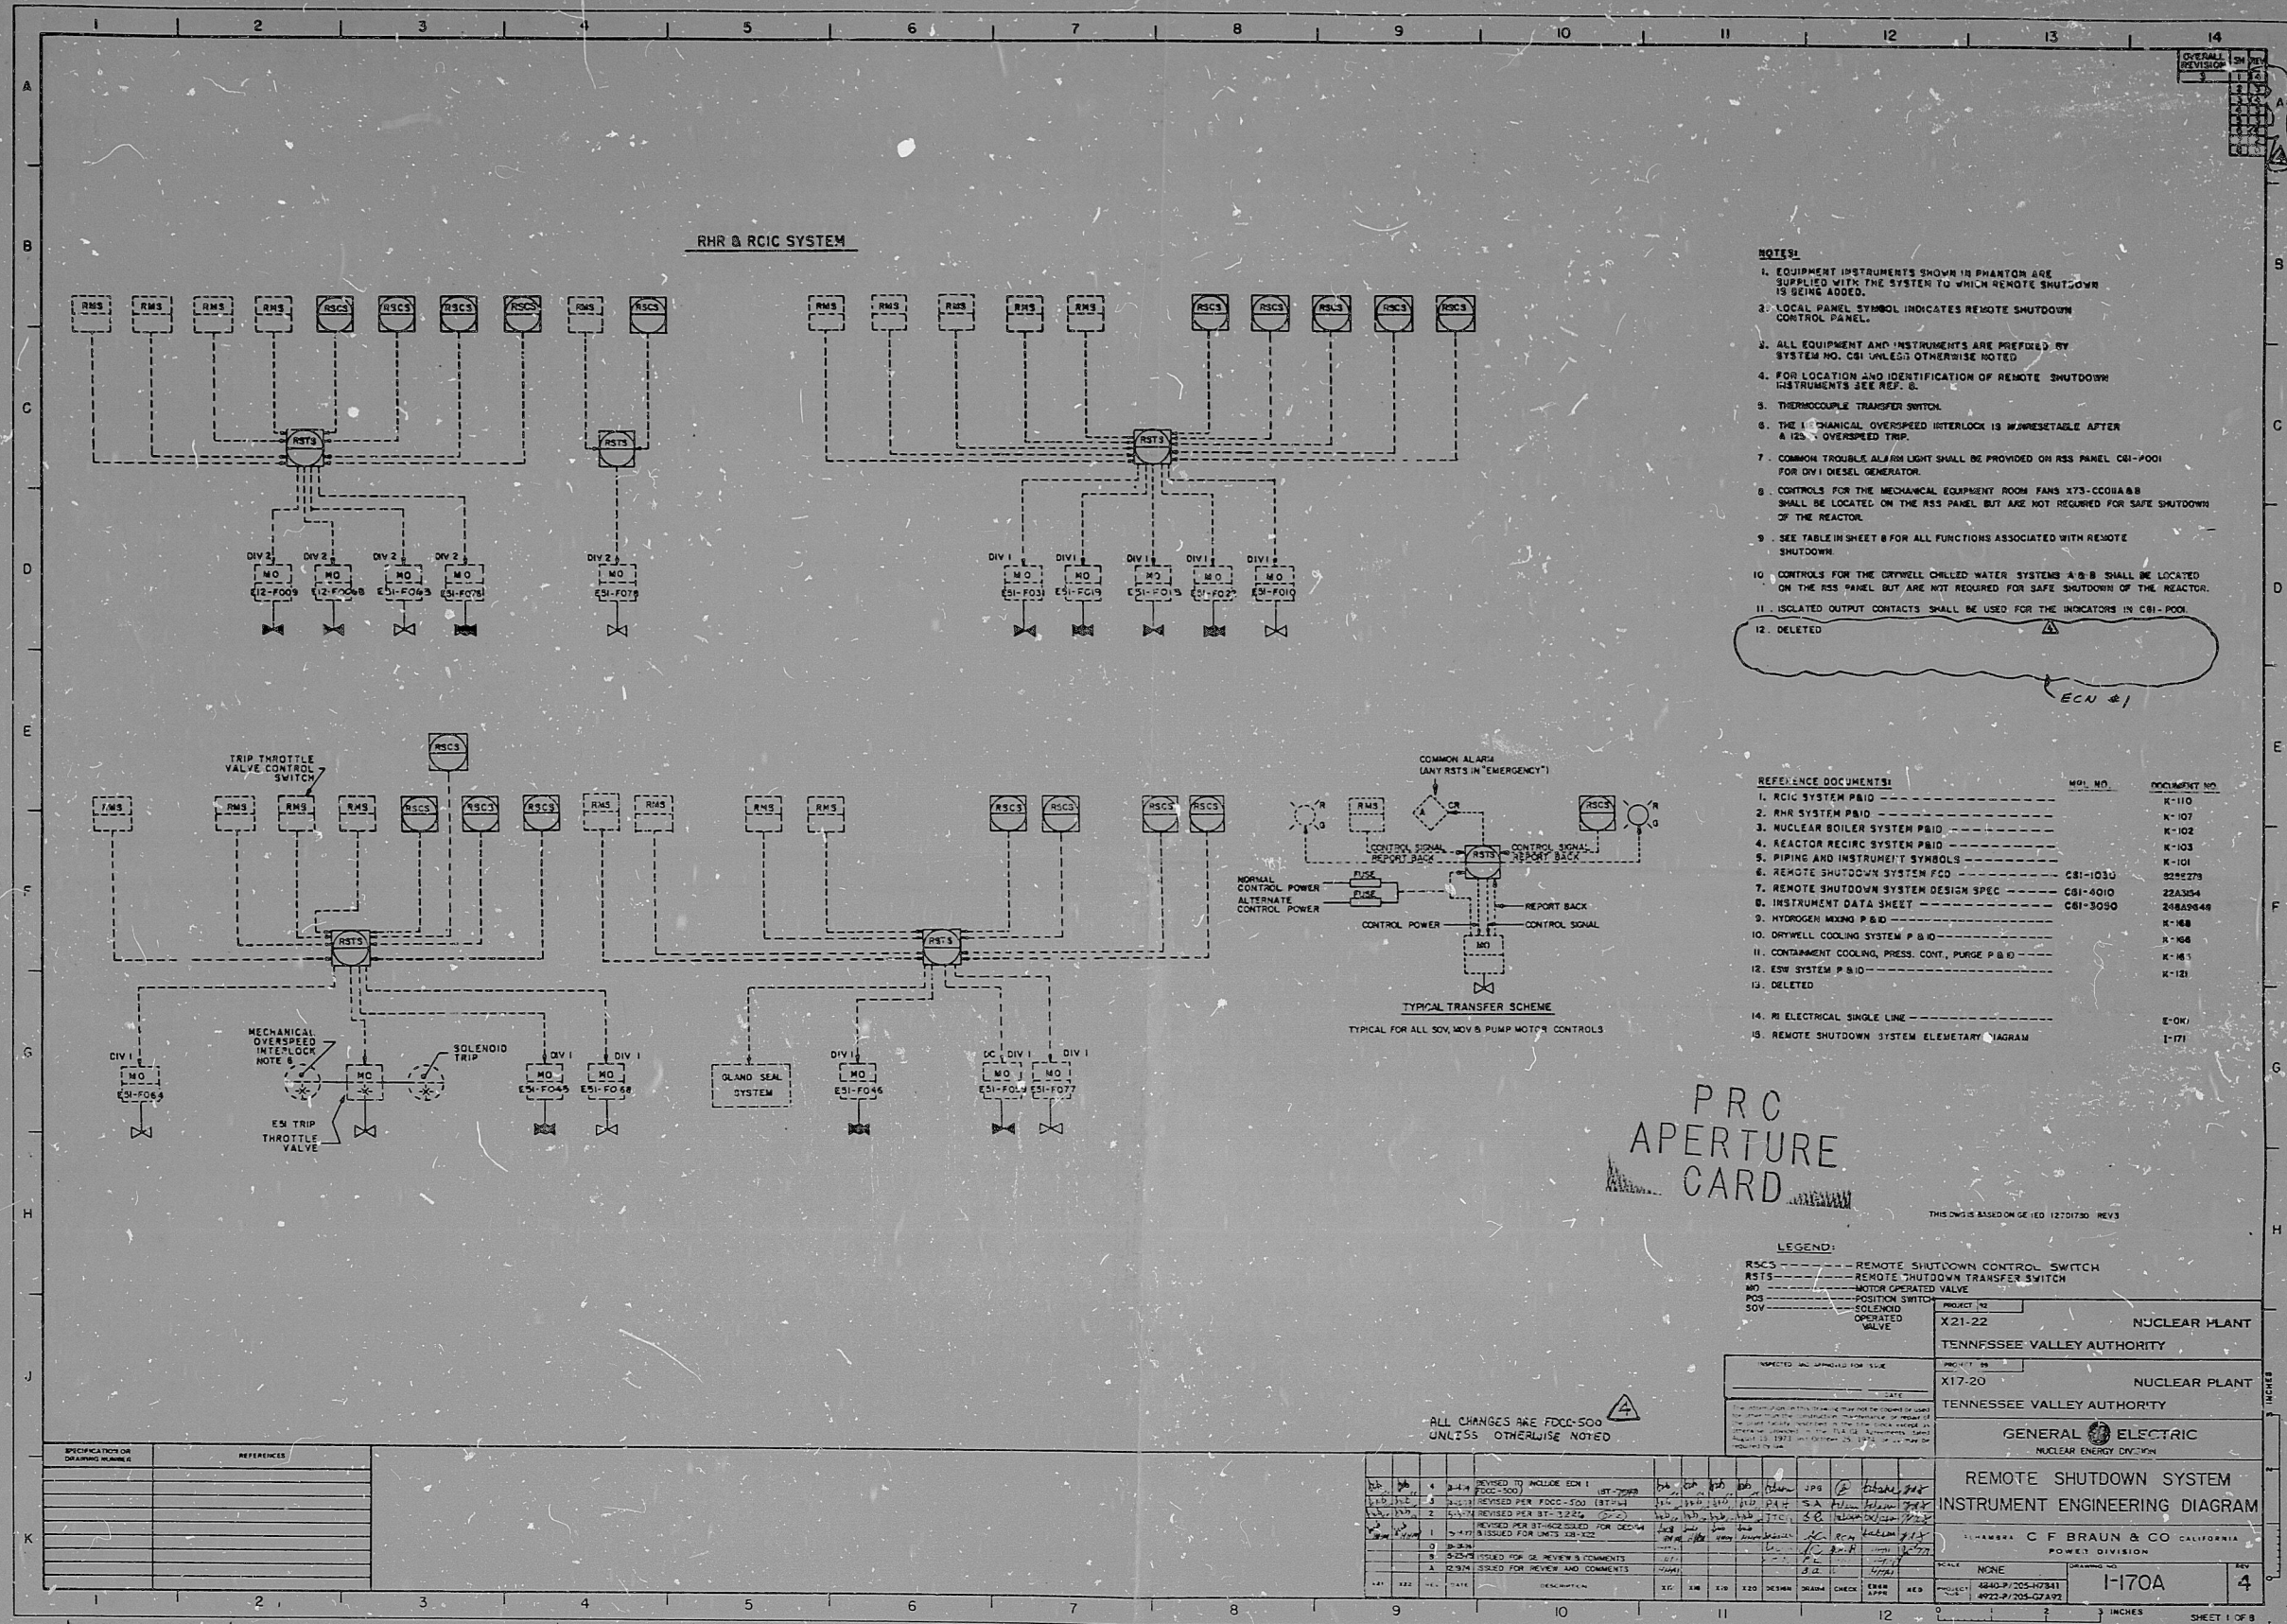

DDAINT
RIDS

8206250227

