


[illegible]

RAS-PDR

8103270362

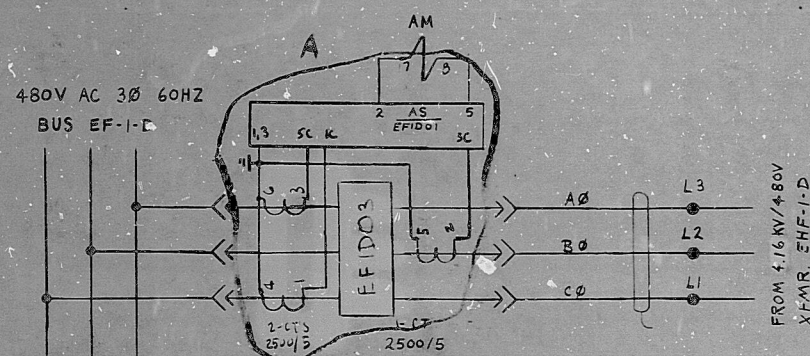