


INSEEVIC INV-137

NO	REV	DATE	DESCRIPTION

ISQ. NO: MCFI-INV-137
 DUKE PIPING CLASS: ASME SECT. II, CL. A+B
 BUILDING: CAS FOR ZONE: R-2
 SYSTEM SYMBOL: CHEMICAL VOLUME CONTROL
 PIPING SPEC: NV-19 PS 1501.1, NV-21 PS 1501.2
 DRAWING NO: MC-1A14-22-21-00-D1, 22-00-D1
 PROJECT: PROJECT MCGUIRE
 NUCLEAR SAFETY RELATED

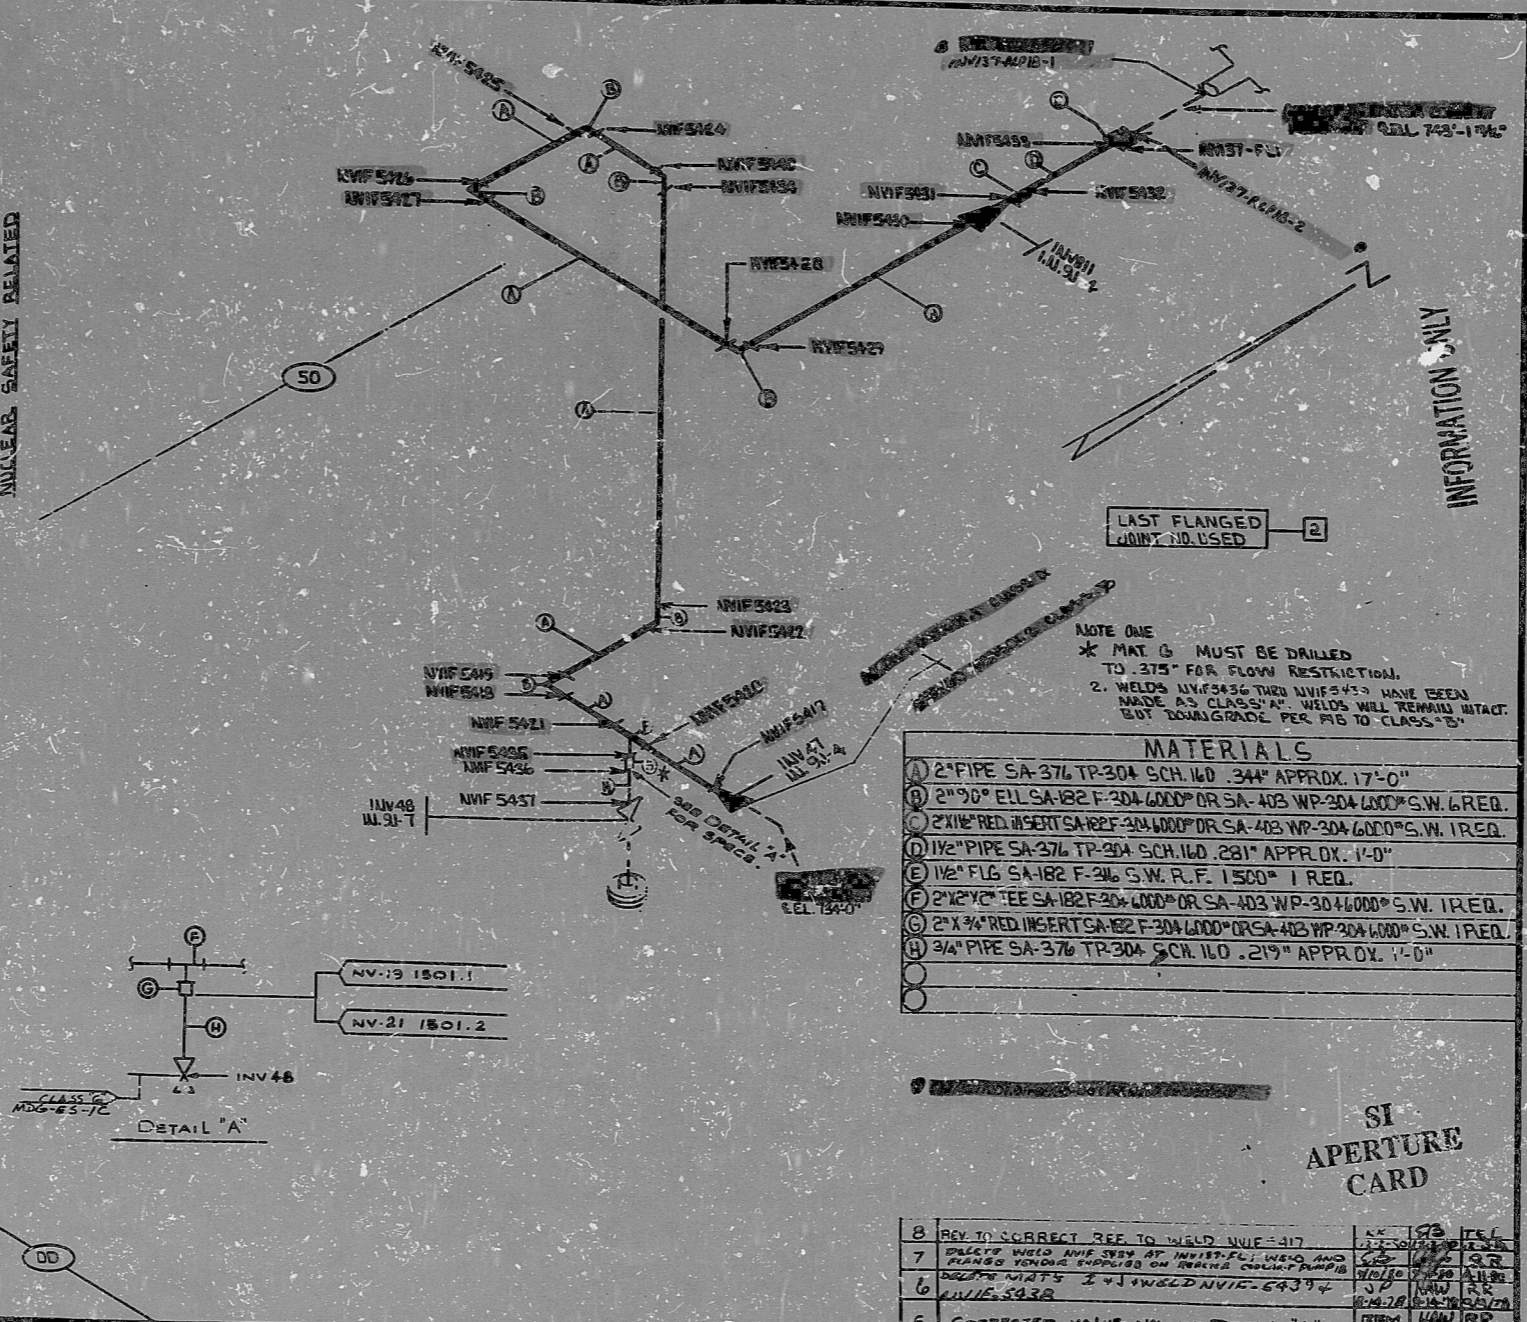

PDR RIDS

9301130285

