


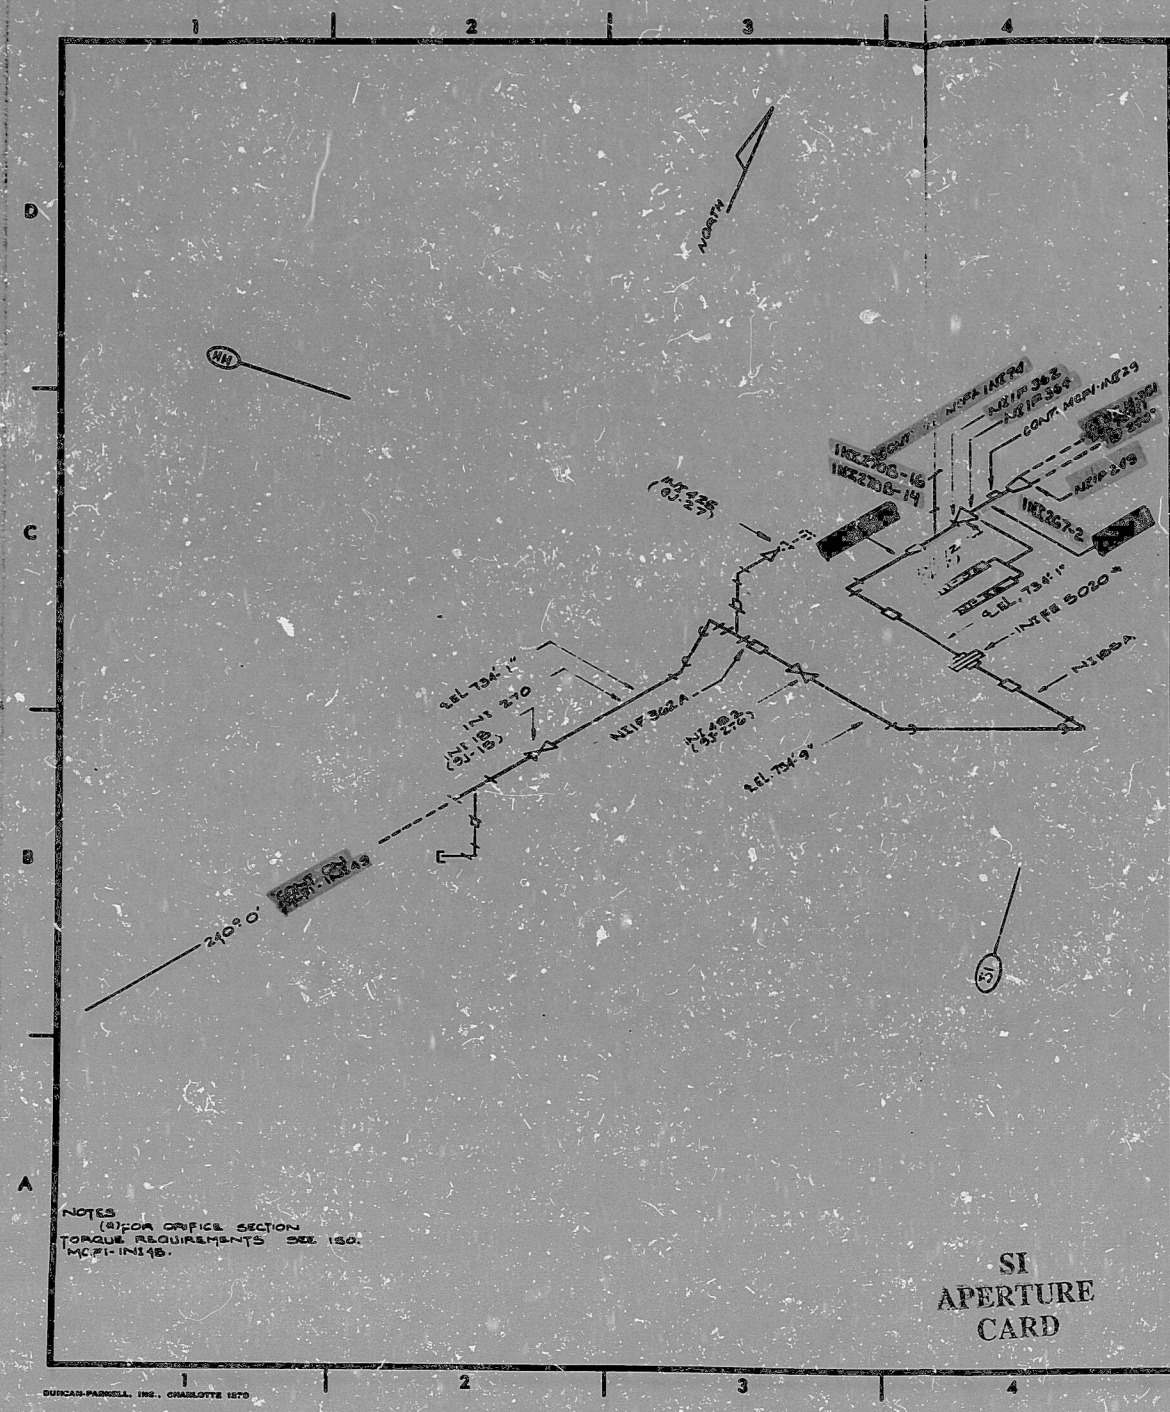

NOTES
(S)FOR OFFICE SECTION
TORQUE REQUIREMENTS SEE 150.
MCPI-INT 15

SI
APERTURE
CARD

REVISIONS BLOCK						
NO.	DESCRIPTION	DATE	BY	CHKD.	APP'D.	REMARKS
0	RELEASE FOR CONST.	4-2-60				
1	CHANGE WELD NUT 2 IN. TO 3 IN. PER 150	4-2-60				

ITEM	SIZE	QTY.	SPEC./GRADE	SPEC./GRADE	SCF./LBS.	REMARKS
BILL OF MATERIAL						
LAST WELD NO.		DUKE POWER COMPANY			LAST PL. NO.	
NA		McGUIRE NUCLEAR STATION			NA	
NUCLEAR SAFETY RELATED				YES ☐	NO ☒	
PIPE SPEC.	SYS. SYMBOL	SEC. NO.	DRAWING NO.	BL.		
2801.2	NI	03, 04, 05	MC-1414-09.21-00.01	738-C		
APPLICABLE CODE	CLASS	ISO. NO.	MCPI-INT 15	REV.		
ASME SECT III	D			1		

INFORMATION ONLY

PDR RIDS

9301140170

