




RIDS

8308310435

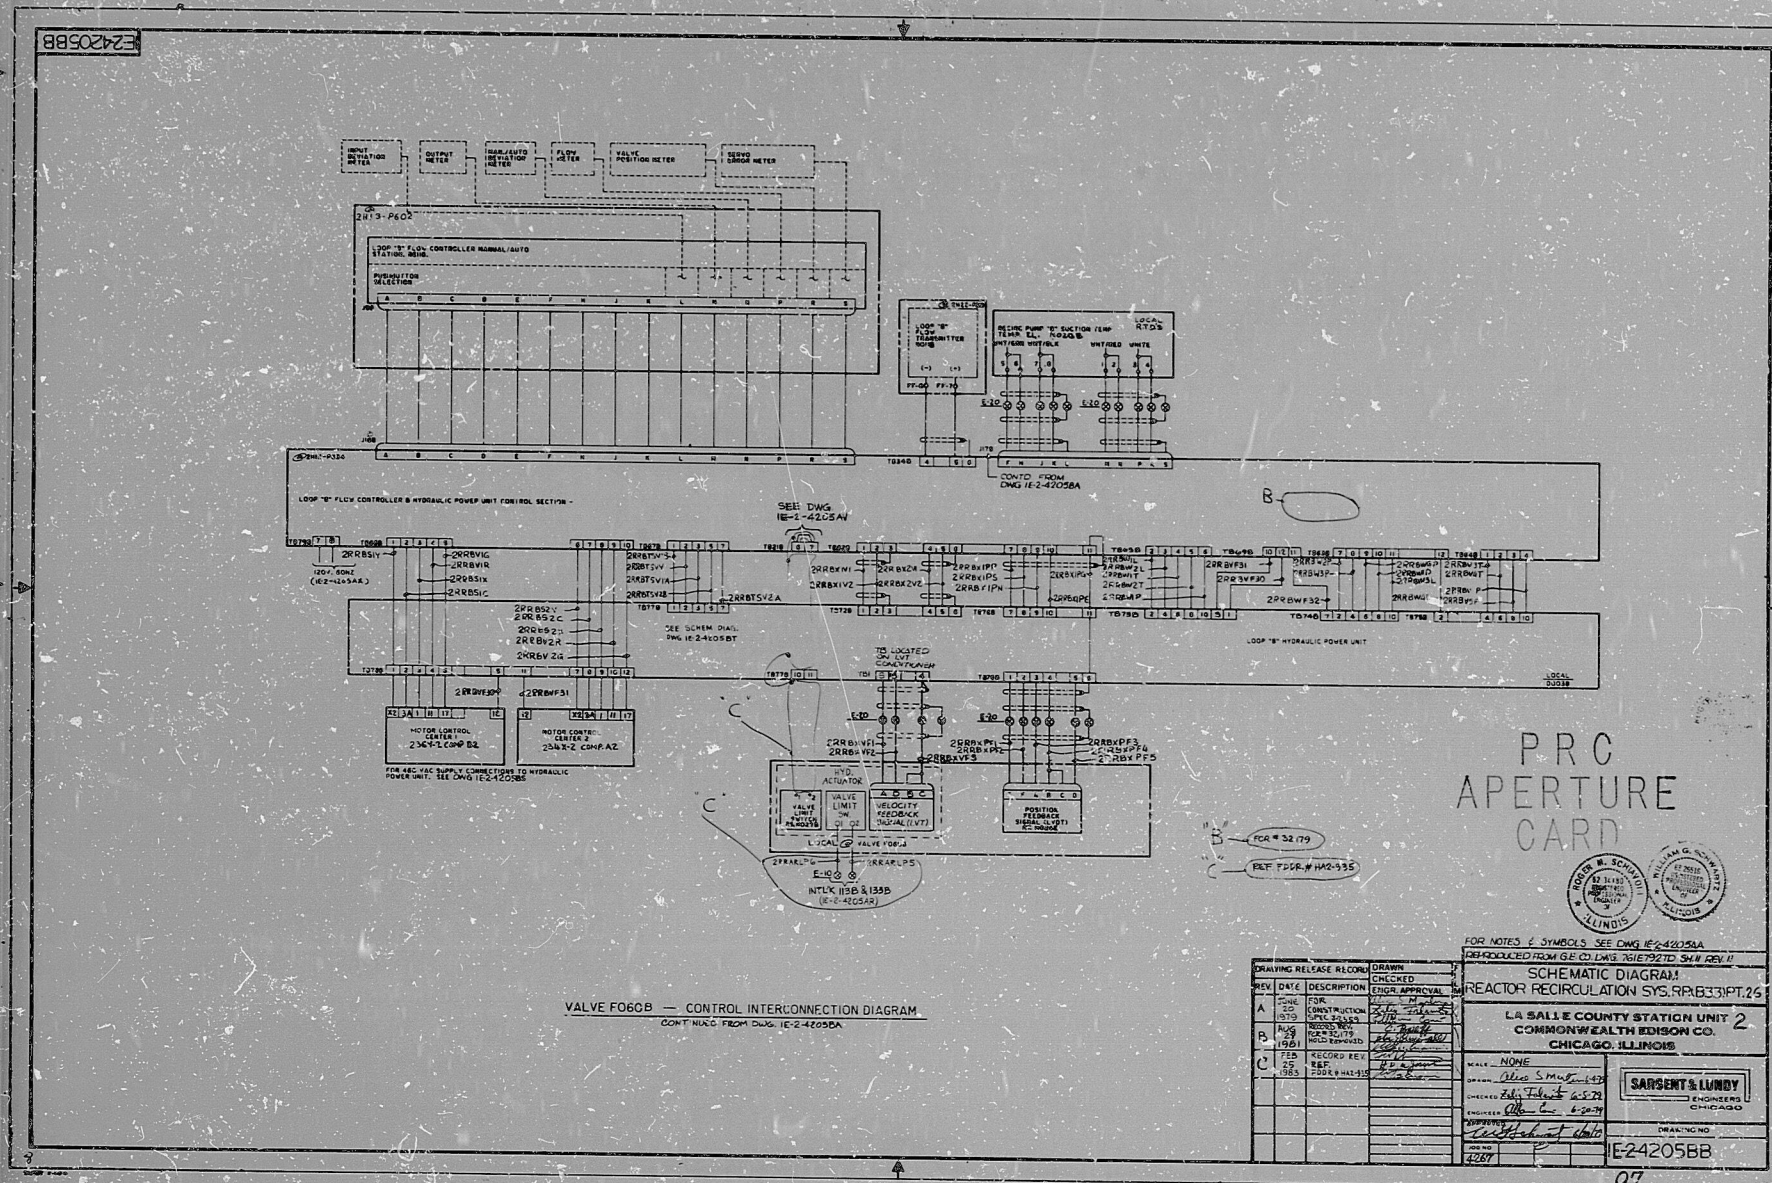