


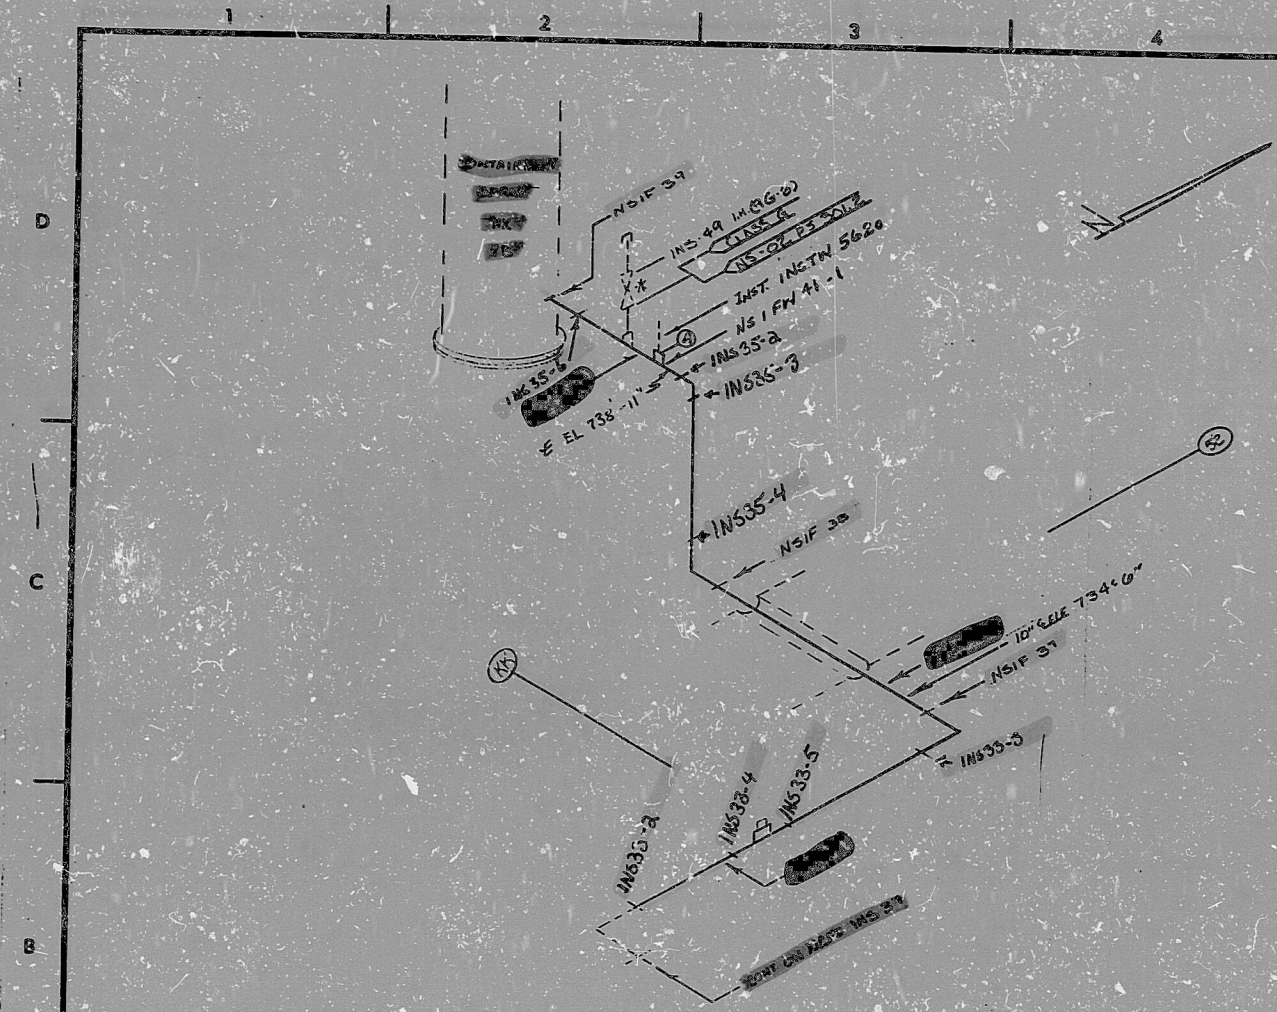

NOTE:
* INSTALL I.A.W. MDG-ES-1A

SI
APERTURE
CARD

REVISIONS BLOCK					
GRID	REV. NO.	DESCRIPTION	ORIG. DATE	CHG. DATE	APPROV. ESTD.
	0	RELEASED FOR CONSTRUCTION	ERG	7-16-80	7-16-80
	1	REPLACED ORIGINATOR'S AND DATE IN INSTN 5620. (ORIGINATOR'S INSTN 5620, A. R. C. 10-17-80)	ERG	10-17-80	10-17-80

INFORMATION ONLY

(H)	1"	HALF CPLG	1/2" x 1/2"	3000#	FS/SW/SS
ITEM	SIZE	DES.	SPEC.	QTY	REMARKS
BILL OF MATERIAL					
LAST WELD NO. 1			DUKE POWER COMPANY McGUIRE NUCLEAR STATION		
BA CONDITION 1			LAST FL. NO. NA		
NUCLEAR SAFETY RELATED			BUILDING: ZONE: A-3		
PIPE SPEC: 301.2		SYS. SYMBOL: NS	SEC. NO: 02	DRAWING NO: MC 144-19.42-00.01	
APPLICABLE CODE: ASME SECTION III		CLASS: B	ISO. NO: MCFI INS 41	REV: 1	

PDR RIDS

9301140346

