


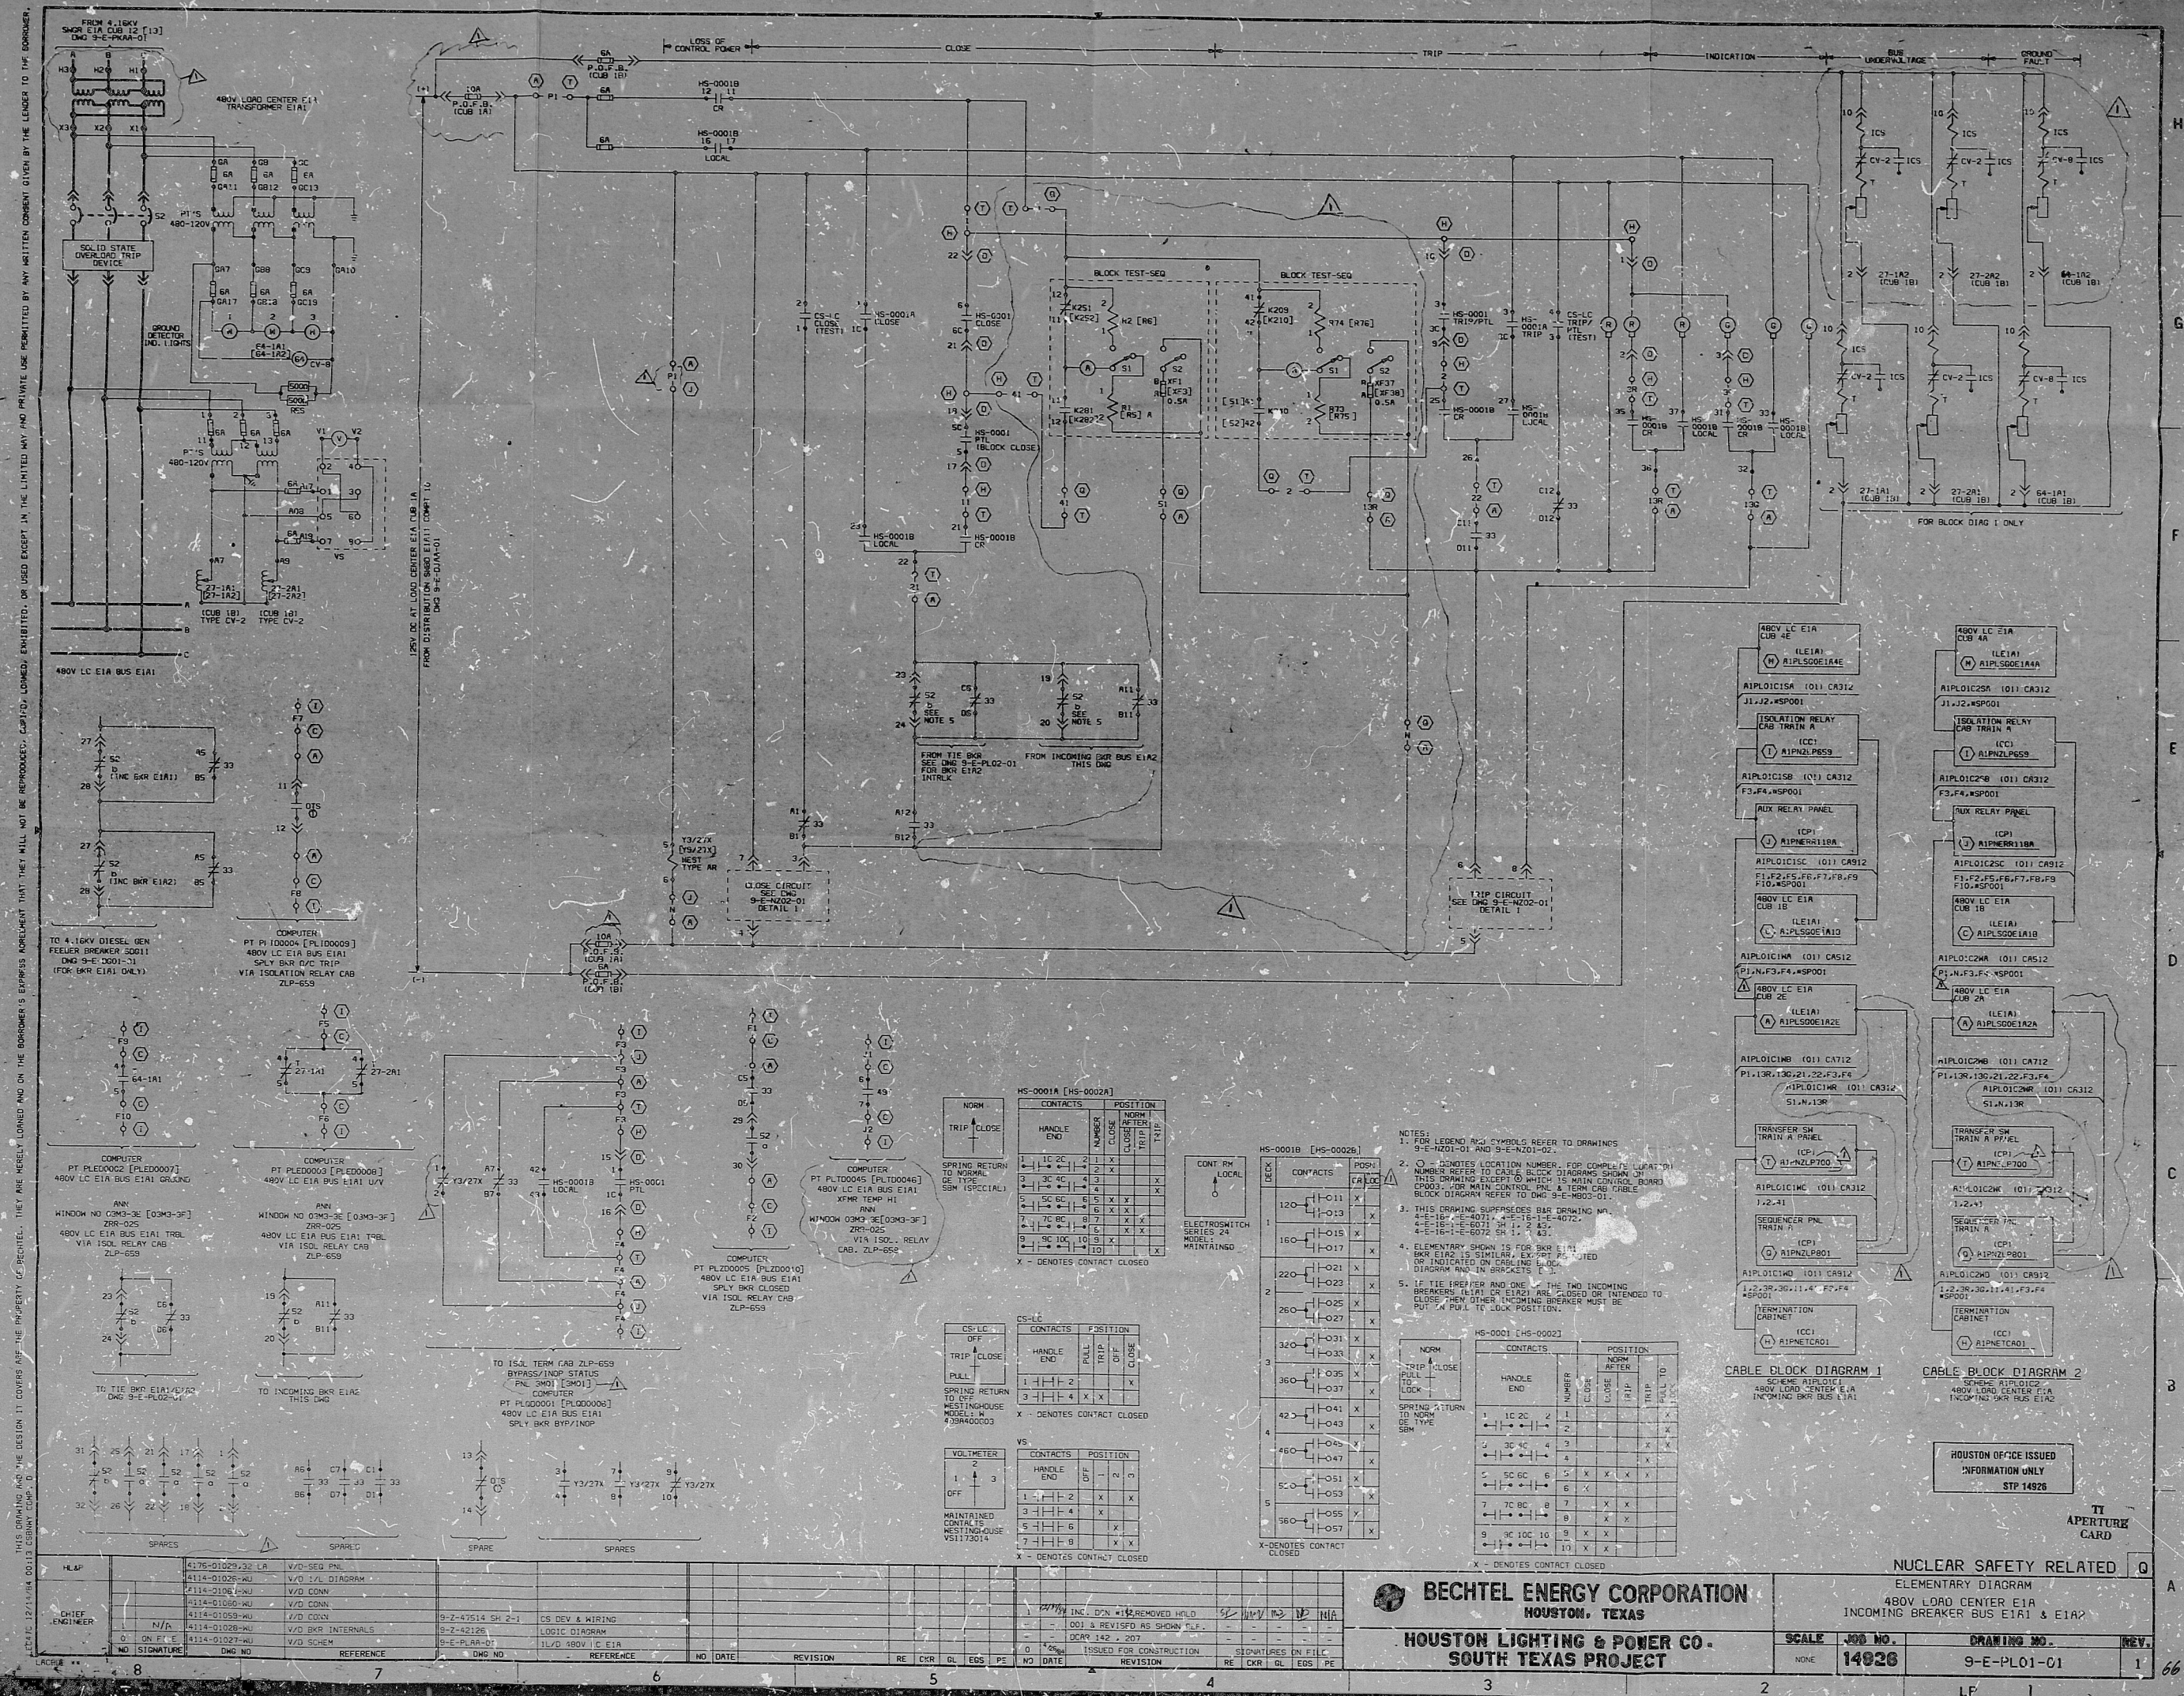

PDR RIDS

8506040430

