


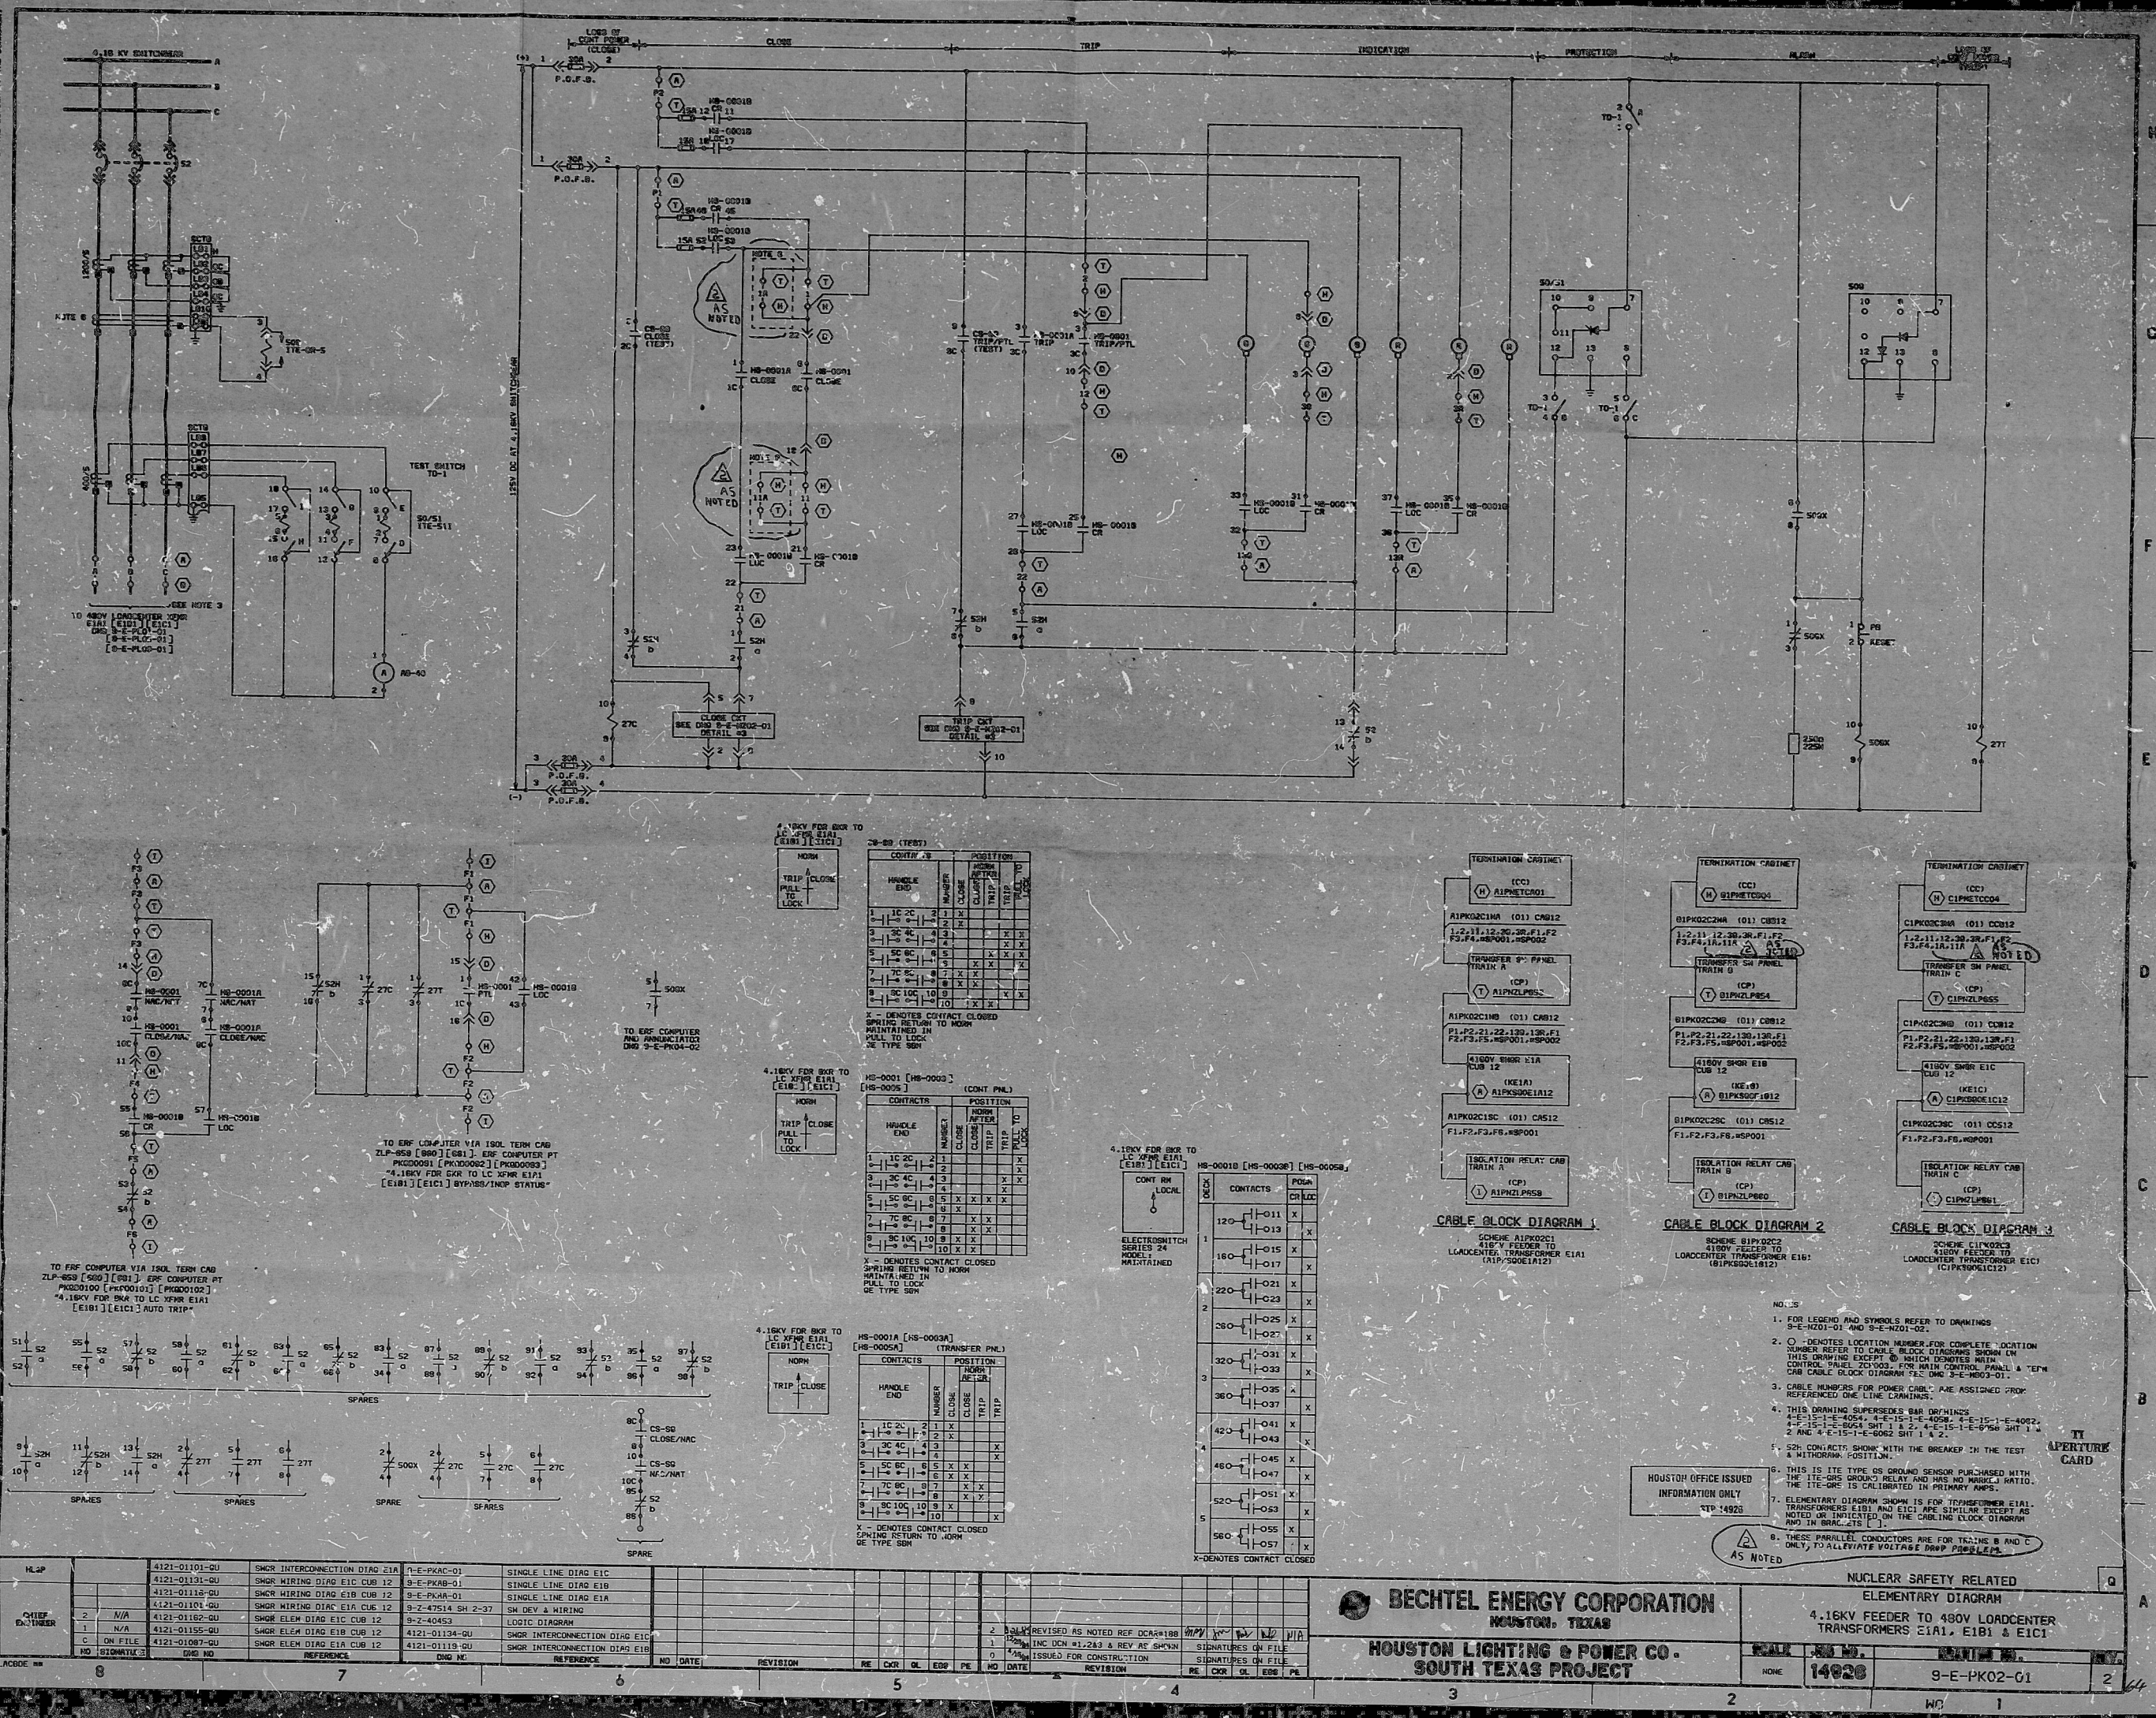

PDR RIDS

85Q6Q4Q46L

