




RIDS

8308310488

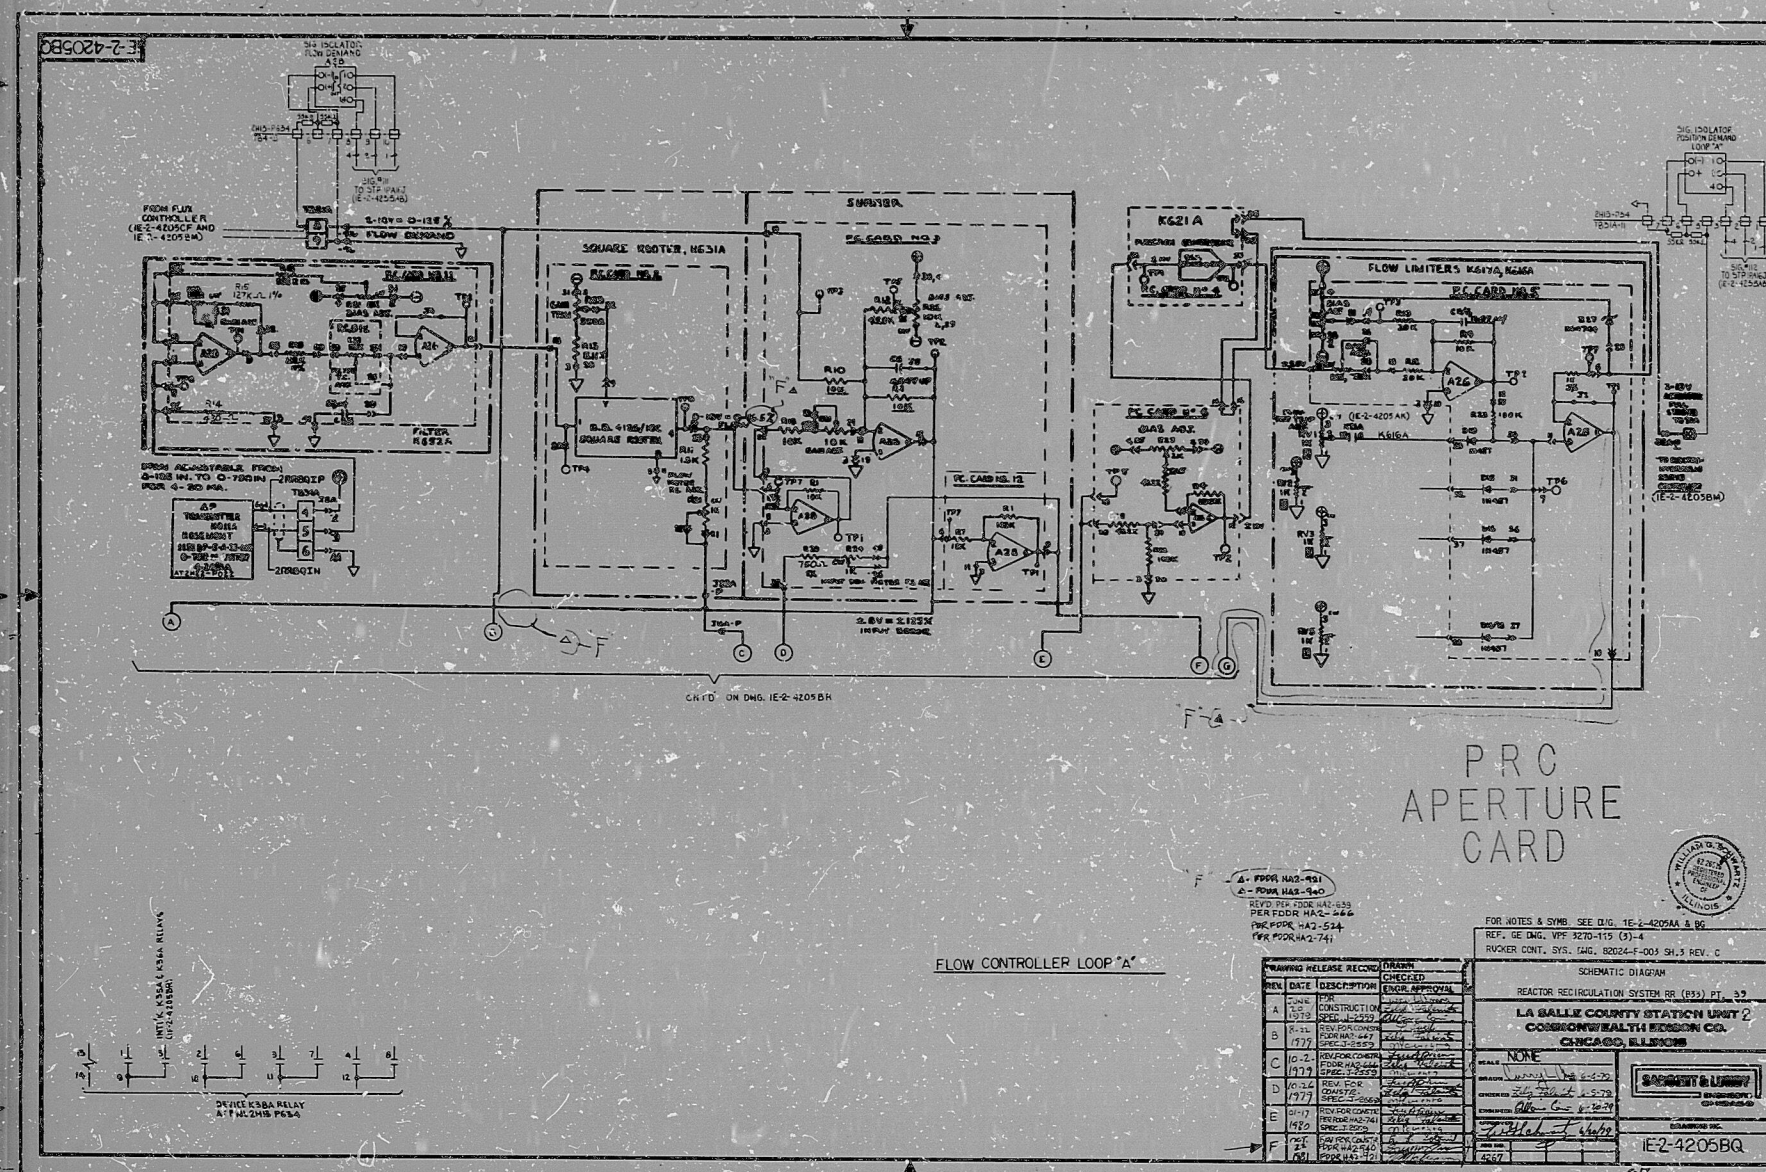