


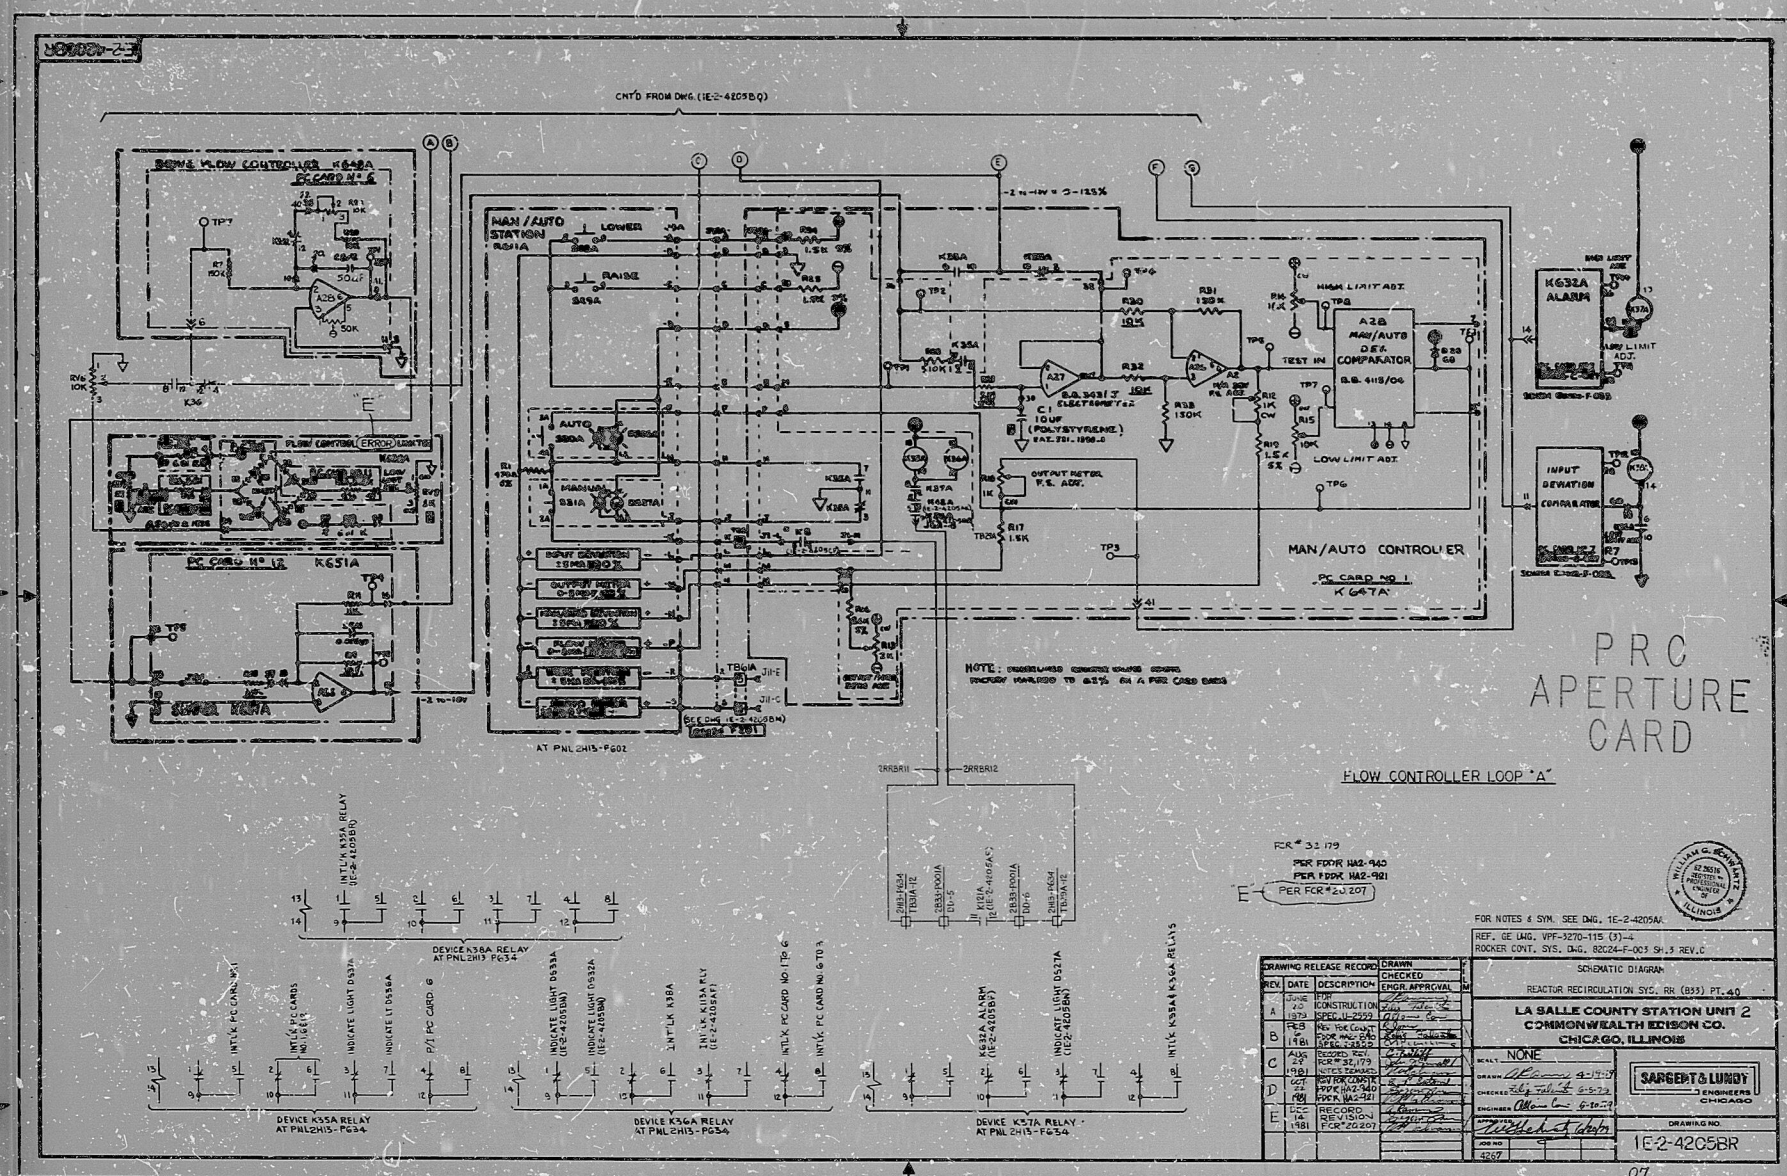

KIDS

8308310489

